


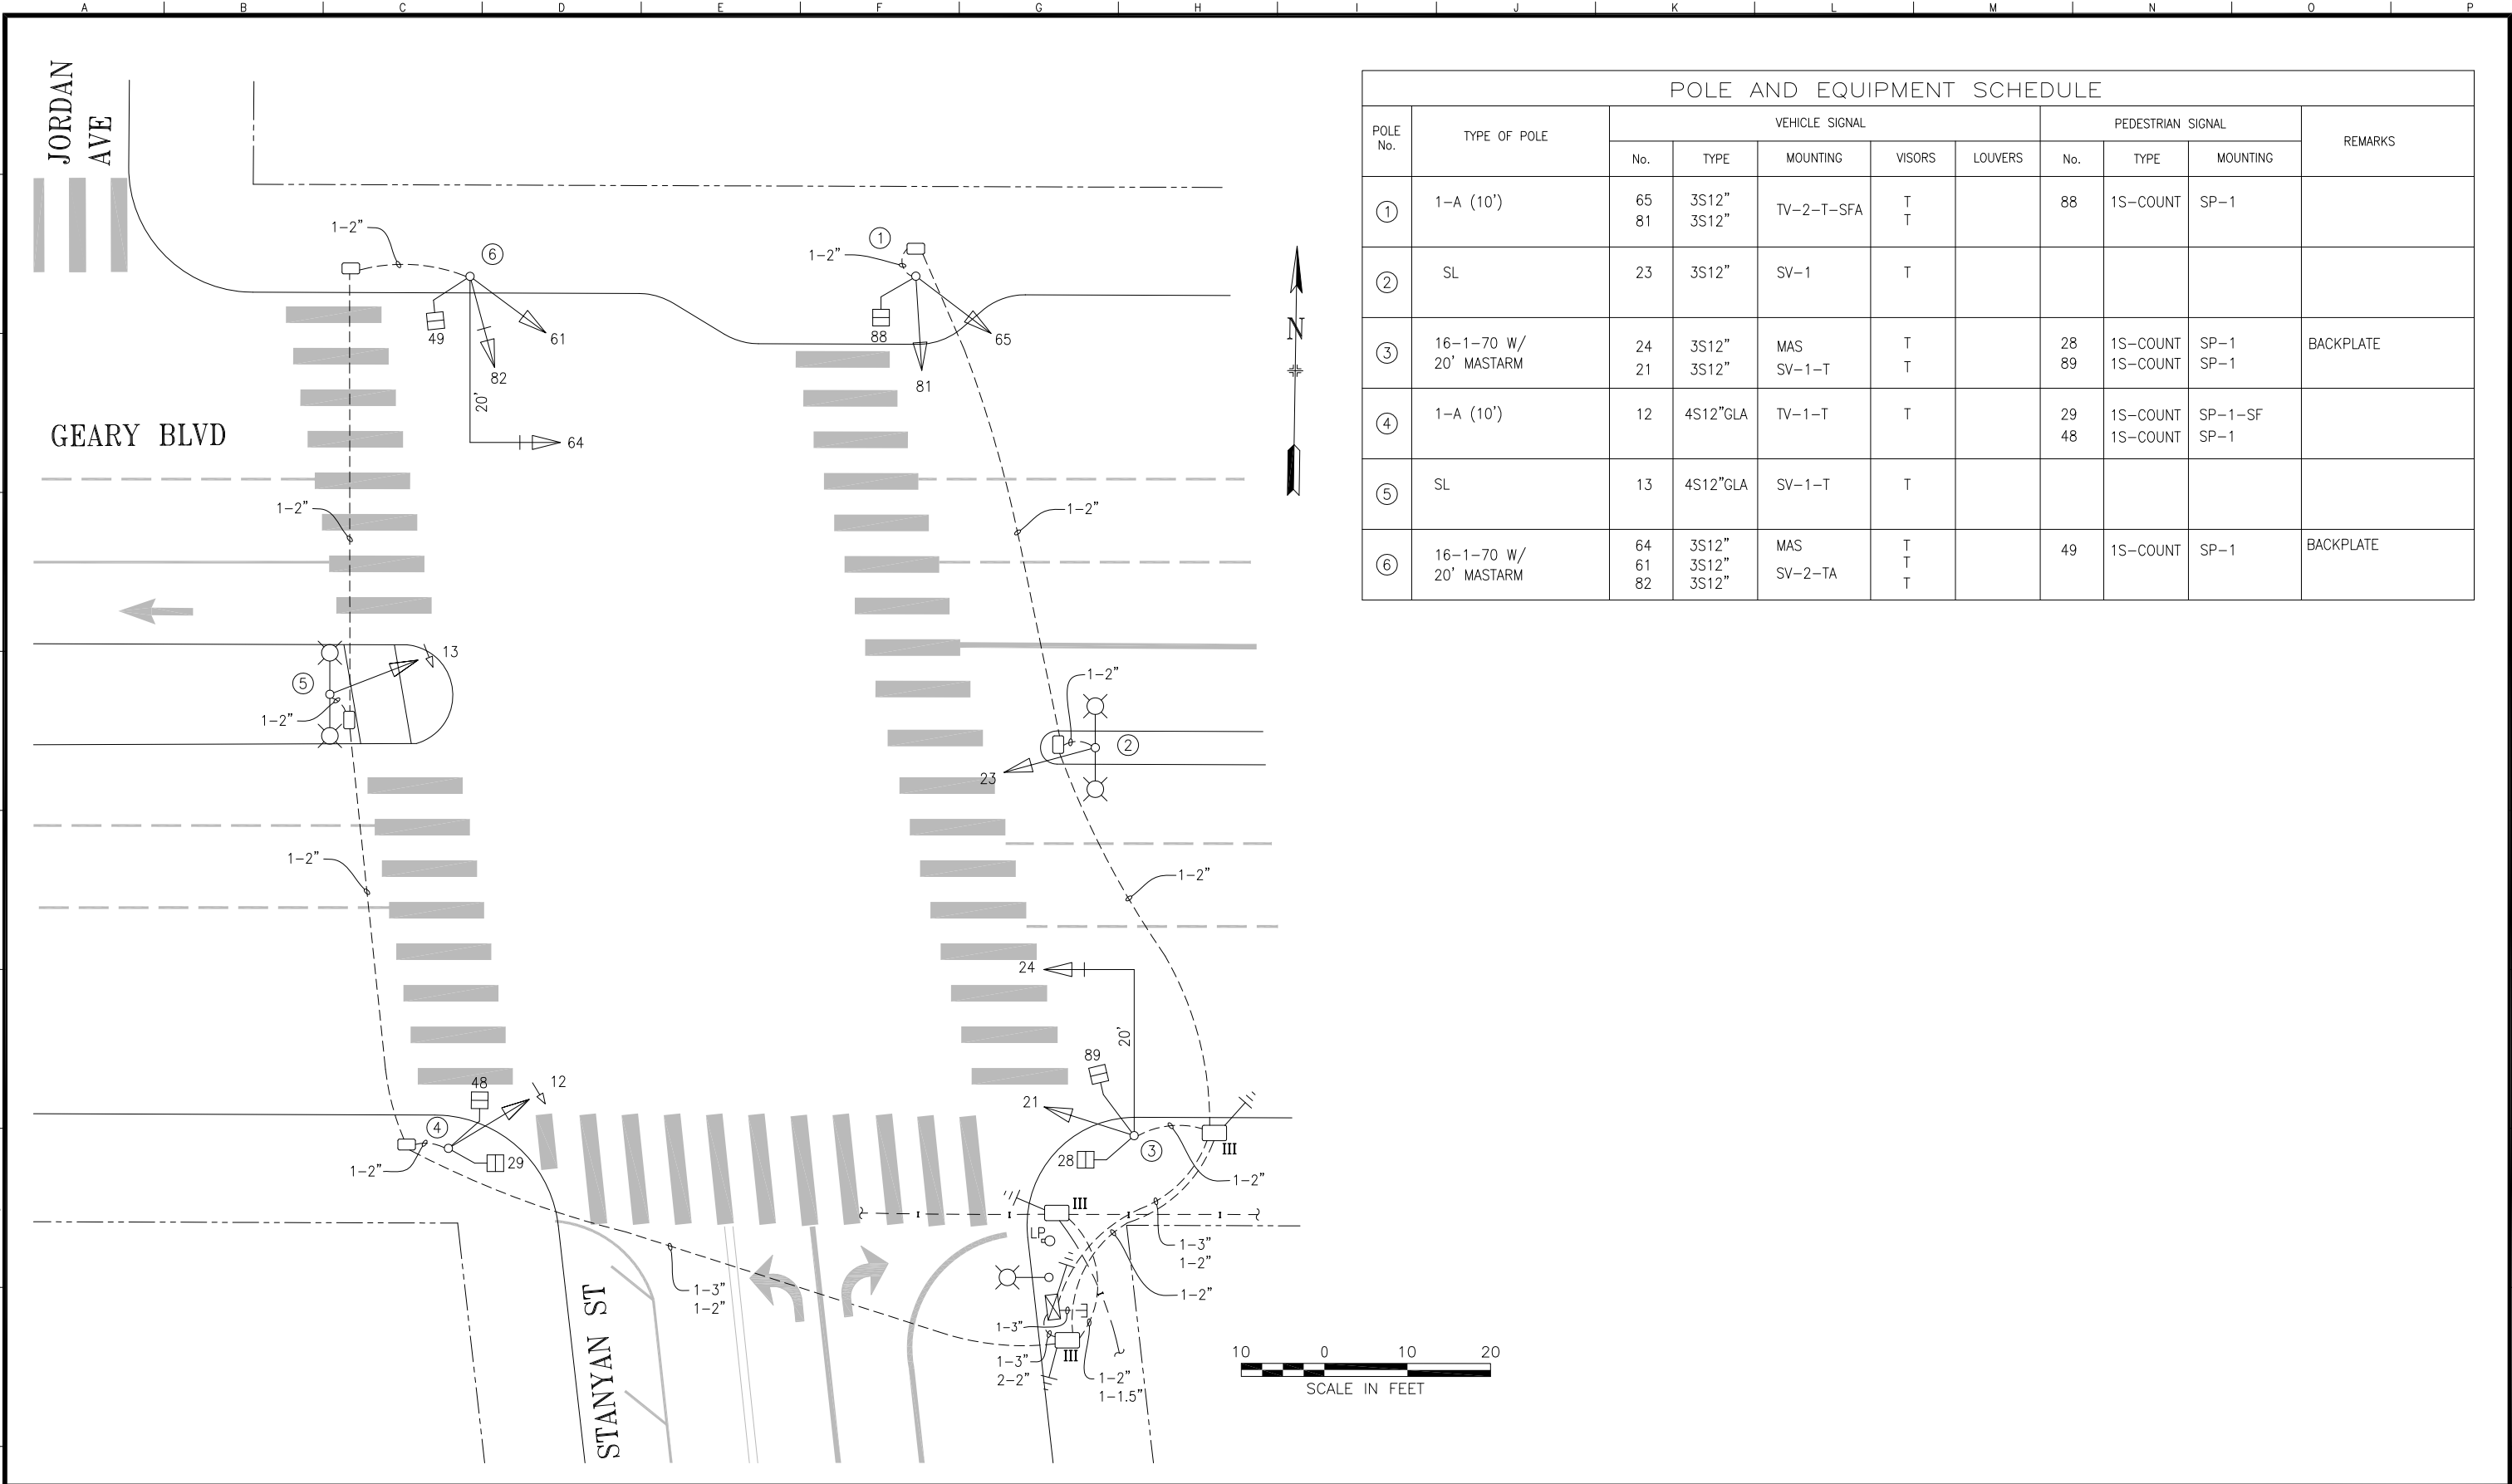

POLE AND EQUIPMENT SCHEDULE										
POLE No.	TYPE OF POLE	VEHICLE SIGNAL					PEDESTRIAN SIGNAL			REMARKS
		No.	TYPE	MOUNTING	VISORS	LOUVERS	No.	TYPE	MOUNTING	
①	1-A (10')	65 81	3S12" 3S12"	TV-2-T-SFA	T T		88	1S-COUNT	SP-1	
②	SL	23	3S12"	SV-1	T					
③	16-1-70 W/ 20' MASTARM	24 21	3S12" 3S12"	MAS SV-1-T	T T		28 89	1S-COUNT 1S-COUNT	SP-1 SP-1	BACKPLATE
④	1-A (10')	12	4S12"GLA	TV-1-T	T		29 48	1S-COUNT 1S-COUNT	SP-1-SF SP-1	
⑤	SL	13	4S12"GLA	SV-1-T	T					
⑥	16-1-70 W/ 20' MASTARM	64 61 82	3S12" 3S12" 3S12"	MAS SV-2-TA	T T T		49	1S-COUNT	SP-1	BACKPLATE

TABLE OF REVISIONS			
NO.	DATE	DESCRIPTION	BY APP.
1	10/26/17	UPDATE SIGNALS TO 12" PER SRC 2017-081	H.YU M.VELASCO
0	4/22/04	NEW SID CONVERTED FROM 2019N AS-BUILTS	H.YU M.VELASCO

REFERENCE INFORMATION & FILE NO. OF SURVEYS	



SAN FRANCISCO MUNICIPAL TRANSPORTATION AGENCY

CITY AND COUNTY OF SAN FRANCISCO

DRAWN:	DATE:
H.YU	3/2017
CHECKED:	DATE:
M.VELASCO	3/2017

SCALE:
AS SHOWN
SHEET OF SHEETS
1 OF 1

TRAFFIC SIGNAL INVENTORY DIAGRAM
GEARY BOULEVARD AND STANYAN STREET

CNN NO.
27221000
REV NO.
1