

					POLE A	AND EQU	IPMEN 7	T SCHE	DULE												
POLE	POLE STANDARD			POLE STANDARD		POLE STANDARD		POLE STANDARD					VEHICLE SIGNAL				PEDESTRIAN	SIGNAL	HPS	SPECIAL REQUIREMENTS	
NO.	TYPE	SIG. MA (FEET)	OCS SL	No.	TYPE	MOUNTING	VISORS	LOUVERS	No.	TYPE	MOUNTING	LUMINAIRE (WATTS)	SPECIAL REQUIREMENTS								
A	SIGNAL, SL & OCS COMBO POLE	30	1102	21 24 27	3S12" 3S12" 3S12"GUA	SV-1-T MAS MAS	T T T		28	1S-COUNT	SP-1	-	STRAIGHT HORIZONTAL SIGNAL MA MOUNT AT 21' HIGH SEE ST PLANS FOR POLE DETAILS APS TENON FOR FUTURE FBC MIDWAY BETWEEN MAS SIGNALS	MOUNT SIGNAL 27 BETWEEN YELLOW AND GREE							
B	1-A (10')	-		85	3S12"	TV-1-T	Т		89	1S-COUNT	SP-1	-	APS 🔷								
©	NEW SL	-	101	-	-	_	_		29 48	1S-COUNT 1S-COUNT		-	APS (22)  SPECIAL POLE FOUNDATION  PIP INSTALL POLE IN PLACE OF EXISTING POLE								
D	SIGNAL, SL & OCS COMBO POLE	_	1060	25	3S12"	SV-1-T	Т		-	_	-	-									
E)	PPBP POLE	-		-	_	_	-		-	_	-	-	APS 🔷								
F	PPBP POLE	_		-	-	_	-			-	-	-	APS 💠								
<u>©</u>	SPECIAL MAST ARM POLE (27-4-100)	40		61 64 67	3S12" 3S12" 3S12"GUA	SV-1-T MAS MAS	T T T		68	1S-COUNT	SP-1	-	STRAIGHT HORIZONTAL SIGNAL MA MOUNT AT 21' HIGH  APS (1) TSP (2) TENON FOR FUTURE FBC MIDWAY BETWEEN MAS SIGNALS	MOUNT SGNAL 67 BETWEEN YELLOW AND GRE							
$\oplus$	1-A (13')	-		82	3S12"	TV-1-T	Т		49	1S-COUNT	SP-1	-	APS 🔷								
(1)	19-2-100	30	112	81 84	3S12" 3S12"	SV-1-T MAS	T T		88	1S-COUNT	SP-1	-	MOUNT SIGNAL 81 AT 13' HIGH APS ★ ♦ TRAFFIC CAMERA  COORDINATE W/ CPMC HOSPITAL CONSTRUCTION								
J	1-A (10')	-		65	3S12"	TV-1-T	Т		69	1S-COUNT	SP-1	-	COORDINATE W/ CPMC HOSPITAL CONSTRUCTION APS								

\*OTHER REQUIREMENTS ARE COVERED BY NOTES, LEGEND, SPECIAL PROVISIONS, AND STANDARD

SPECIFICATIONS.
FOR TYPE OF STANDARD, VEHICLE AND PEDESTRIAN SIGNAL MOUNTING, SEE CALTRANS STANDARD PLANS OR DETAIL DRAWINGS.

- ♦ INSTALL APS WIRING AS SHOWN IN CONDUIT AND WIRING SCHEDULE. CITY FORCES TO INSTALL CITY FURNISHED APS UNIT.
- ♦ INSTALL CITY FURNISHED TSP WIRING FROM TS OR COMBINED POLES WITH 3 FEET OF SLACK TO TS CABINET.
- $\ensuremath{\mathfrak{P}}$  install city furnished traffic camera and contractor furnished wiring.
- FOR STREETLIGHT WORK, SEE SL-SERIES PLANS.

## FOR ORIGINAL SIGNATURES, SEE ET-112.1, REV 0

4	11/10/20	CONFORMED SET AND UPDATED WITH FM#332 & RFI #998	KK	MV	CL
3	7/18/19	LATEST DRAWING	KK	MV	CL
2	03/2018	UPDATED POLE STANDARD AND SPECIAL REQUIREMENT,	KK	MV	CL
		UPDATED POLES A, C, J, I, AND G; ADDED FBC TENON			
4 3 2		NOTE			
1	06/2017	POLE J ON COMBINED OCS/SL POLE, UPDATED POLE I	KK	MV	CL
		AND J			
NO.	DATE	DESCRIPTION	REVISED	CHECKED	APPROVED


DESIGNED	K. KWONG
DRAWN	K. KWONG
CHECKED	R. ZAMORA/C. LIU
REVIEWED	C. LIU
RECOMMENDED	P. WILSON
APPROVED	R. OLEA
DATE	12/4/2015



## CITY AND COUNTY OF SAN FRANCISCO MUNICIPAL TRANSPORTATION AGENCY

for the DIRECTOR OF TRANSPORTATION

MUNI BUS RAPID TRANSIT SYSTEM	1289
VAN NESS CORRIDOR TRANSIT IMPROVEMENT PROJECT	
GEARY STREET  CONDUCTOR POLE AND EQUIPMENT SCHEDULES	ET-112.1 REVISION 4

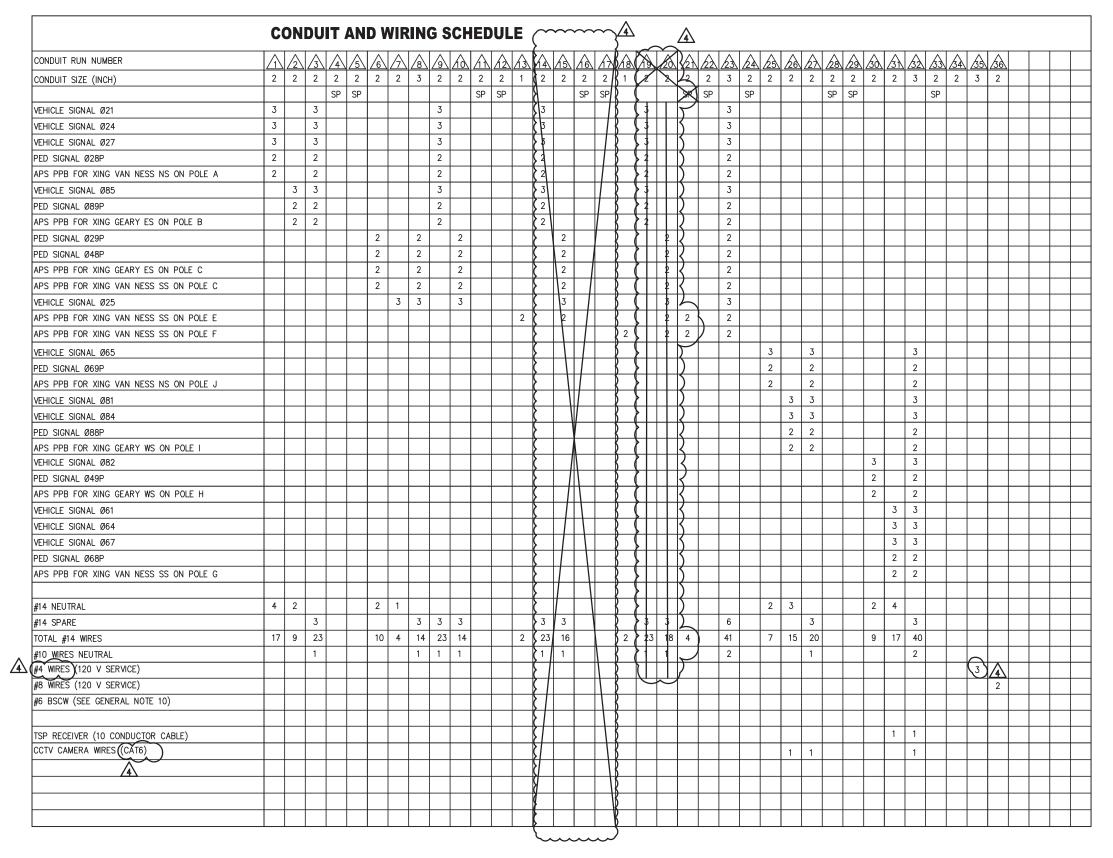

## FOR ORIGINAL SIGNATURES, SEE ET-112.2, REV 0

Ŀ						
	4	11/10/20	CONFORM SET: UPDATED W/ RFI#591,932,948 & FM380R1	KK	MV	CL
Ł	SK	9/11/20	FM#380 UPDATED WIRING WITH WEST MEDIAN PB	KK	MV	CL
			REMOVAL & POLE F CONNECT TO EAST MEDIAN PULLBOX.			
Г	3	7/18/19	LATEST DRAWING	KK	MV	CL
E	2	03/2018	UPDATED APS WIRING TO POLE J	KK	MV	CL
	1	06/2017	UPDATED APS WIRING FROM POLE J TO POLE I	KK	MV	CL
Г	NO.	DATE	DESCRIPTION	REVISED	CHECKED	APPROVED

REVISIONS

DESIGNED	K. KWONG
DRAWN	K. KWONG
CHECKED	R. ZAMORA/C. LIU
REVIEWED	C. LIU
RECOMMENDED	P. WILSON
APPROVED	R. OLEA
DATE	12/4/2015



## CITY AND COUNTY OF SAN FRANCISCO MUNICIPAL TRANSPORTATION AGENCY

APPROVED

for the DIRECTOR OF TRANSPORTATION

MUNI BUS RAPID TRANSIT SYSTEM	1289
VAN NESS CORRIDOR TRANSIT IMPROVEMENT PROJECT	
OCANTI A WIDING COLIFOLILEC	ET-112.2 REVISION 4

BORDER REVISED 11/17/05