


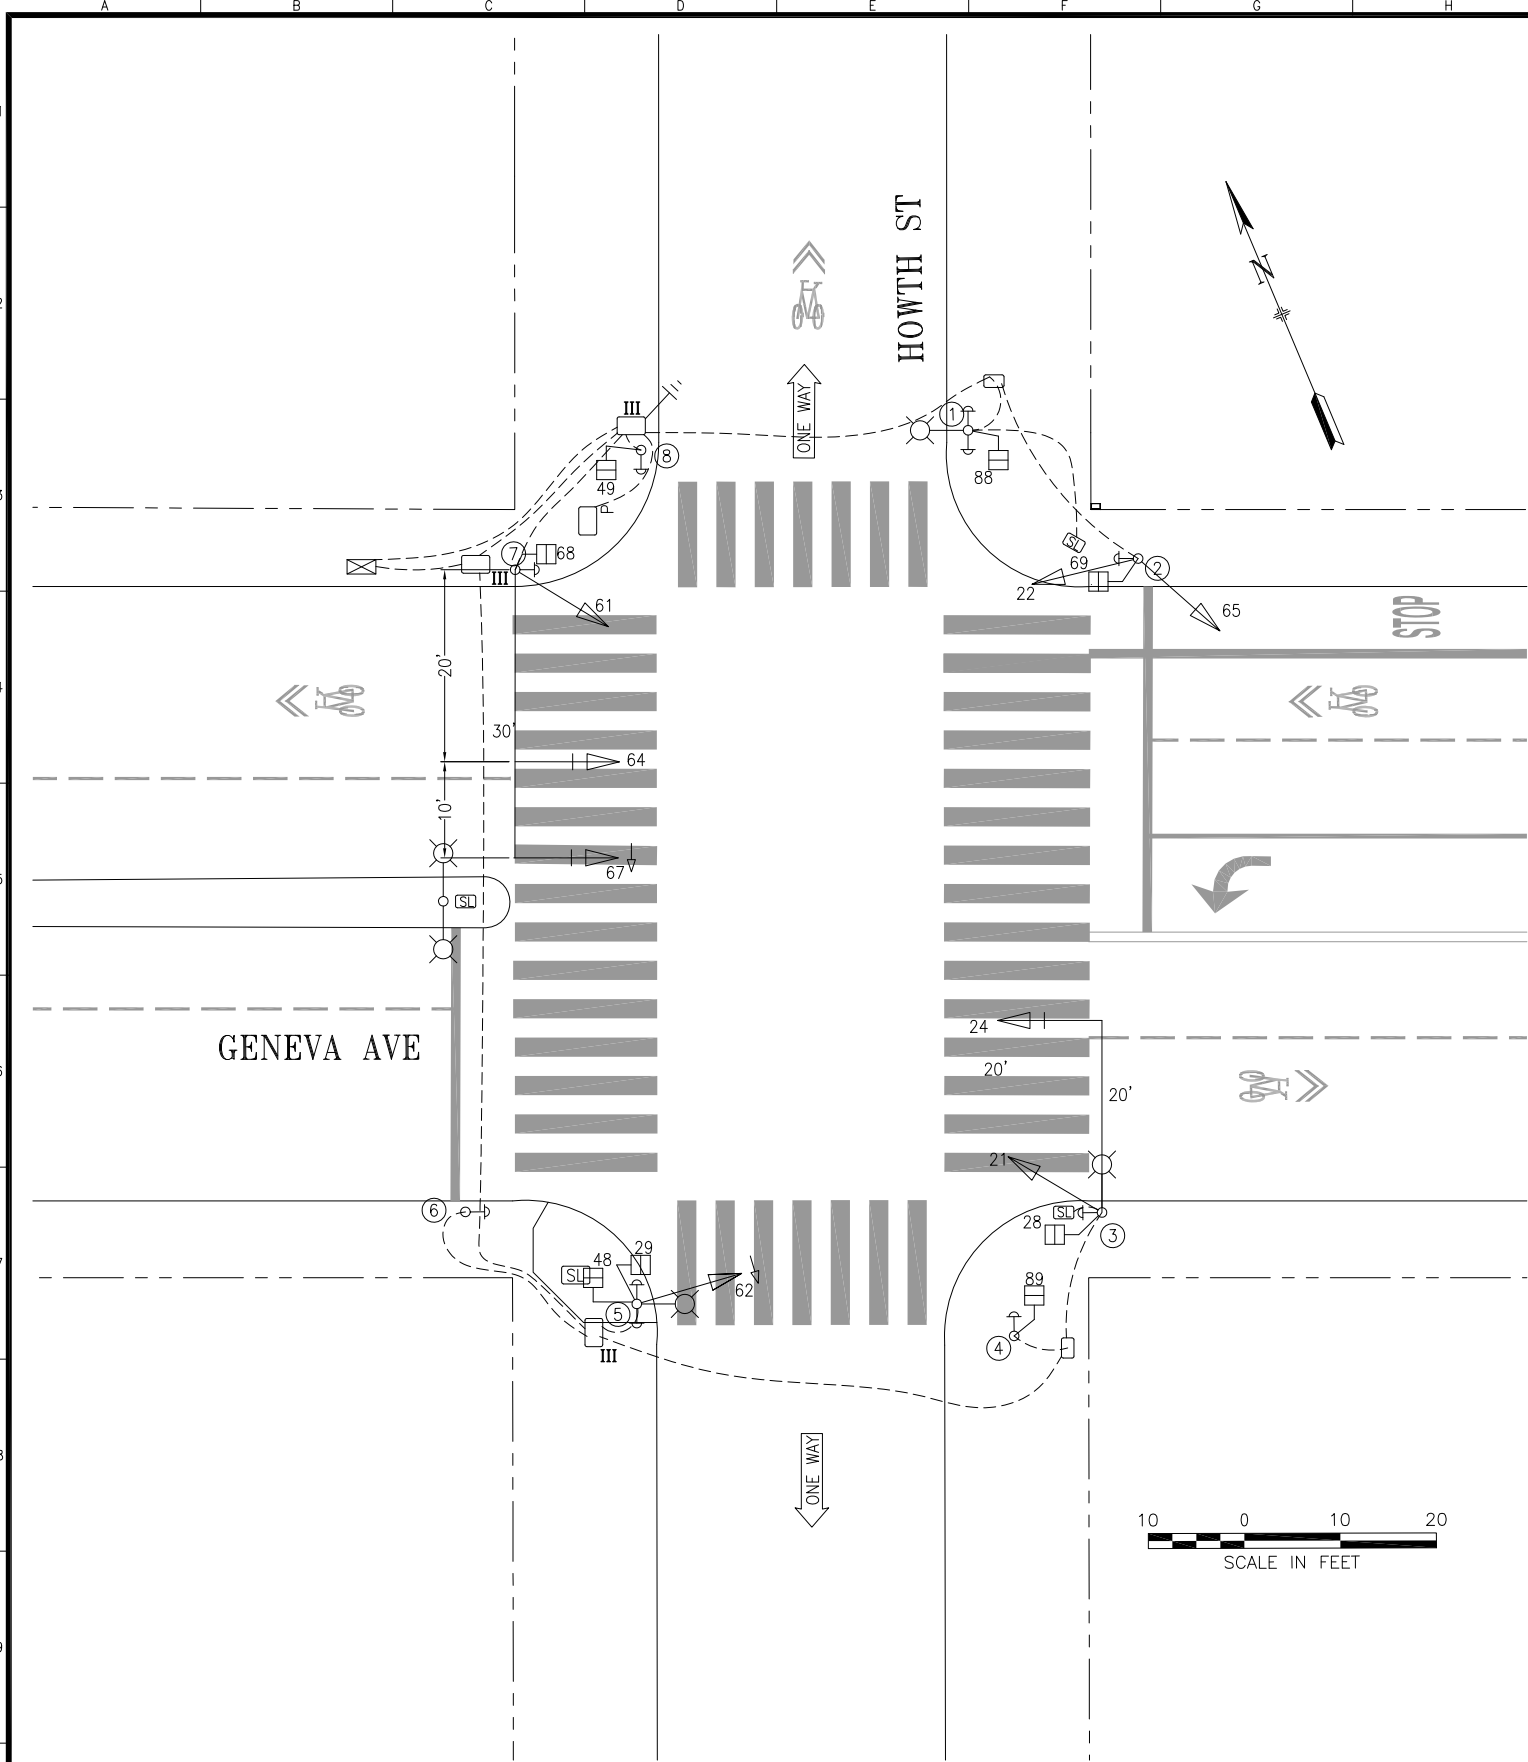

POLE AND EQUIPMENT SCHEDULE											
POLE No.	TYPE OF POLE	LUMINAIRE VOLTAGE/ WATTAGE	VEHICLE SIGNAL					PEDESTRIAN SIGNAL			REMARKS
			No.	TYPE	MOUNTING	VISORS	LOUVERS	No.	TYPE	MOUNTING	
①	EXISTING CITY STANDARD STREETLIGHT							88	1S-COUNT	SP-1	APS + BULLDOG (ACTUATES PED PHASE)
②	1-A (10')		22 65	3S12" 3S12"	TV-2-T	T T		69	1S-COUNT	SP-1	APS (ACTUATES PED PHASE)
③	19-1-100 WITH 20' MAST ARM AND 6' LUMINAIRE ARM		21 24	3S12" 3S12"	SV-1-T MAS	T T		28	1S-COUNT	SP-1	APS (ACTUATES PED PHASE) BACKPLATE
④	1-A (7')							89	1S-COUNT	TP-1	APS (ACTUATES PED PHASE)
⑤	EXISTING CITY STANDARD STREETLIGHT		62	5S12"YGLA	SV-1-T	T		48 29	1S-COUNT 1S-COUNT	SP-1(22") SP-1-SF(12")	APS + BULLDOG (ACTUATES PED PHASE)
⑥	PPB POLE										APS (ACTUATES PED PHASE)
⑦	18-2-100 WITH 30' MAST ARM		61 64 67	3S12" 3S12" 5S12"YGLA	SV-1-T MAS MAS	T T T		68	1S-COUNT	SP-1	APS (ACTUATES PED PHASE) BACKPLATE X 2
⑧	1-A (7')							49	1S-COUNT	TP-1	APS (ACTUATES PED PHASE)

SHEET NOTES

TABLE OF REVISIONS			
1	8/24/17	62 & 67 CHANGED TO 5S12", (N) 65 PER SRC 2017-107	E.CHENB.WOO
0	12/20/13	SIGNALS ACTIVATED THROUGH 2245J	SS. GD
NO.	DATE	DESCRIPTION	BY APP.
CHECK WITH TRACING TO SEE IF YOU HAVE LATEST REVISION			

REFERENCE INFORMATION & FILE NO. OF SURVEYS



SAN FRANCISCO MUNICIPAL TRANSPORTATION AGENCY
CITY AND COUNTY OF SAN FRANCISCO

GD	08/2012
DRAWN:	DATE:
GD	08/2012
CHECKED:	DATE:
MV	03/2013

SCALE:

AS SHOWN

SHEET OF SHEETS

1 OF 1

TRAFFIC SIGNAL INVENTORY DIAGRAM

GENEVA AVENUE AND HOWTH STREET
TRAFFIC SIGNAL WORK

CNN NO.

22190000

REV NO.