


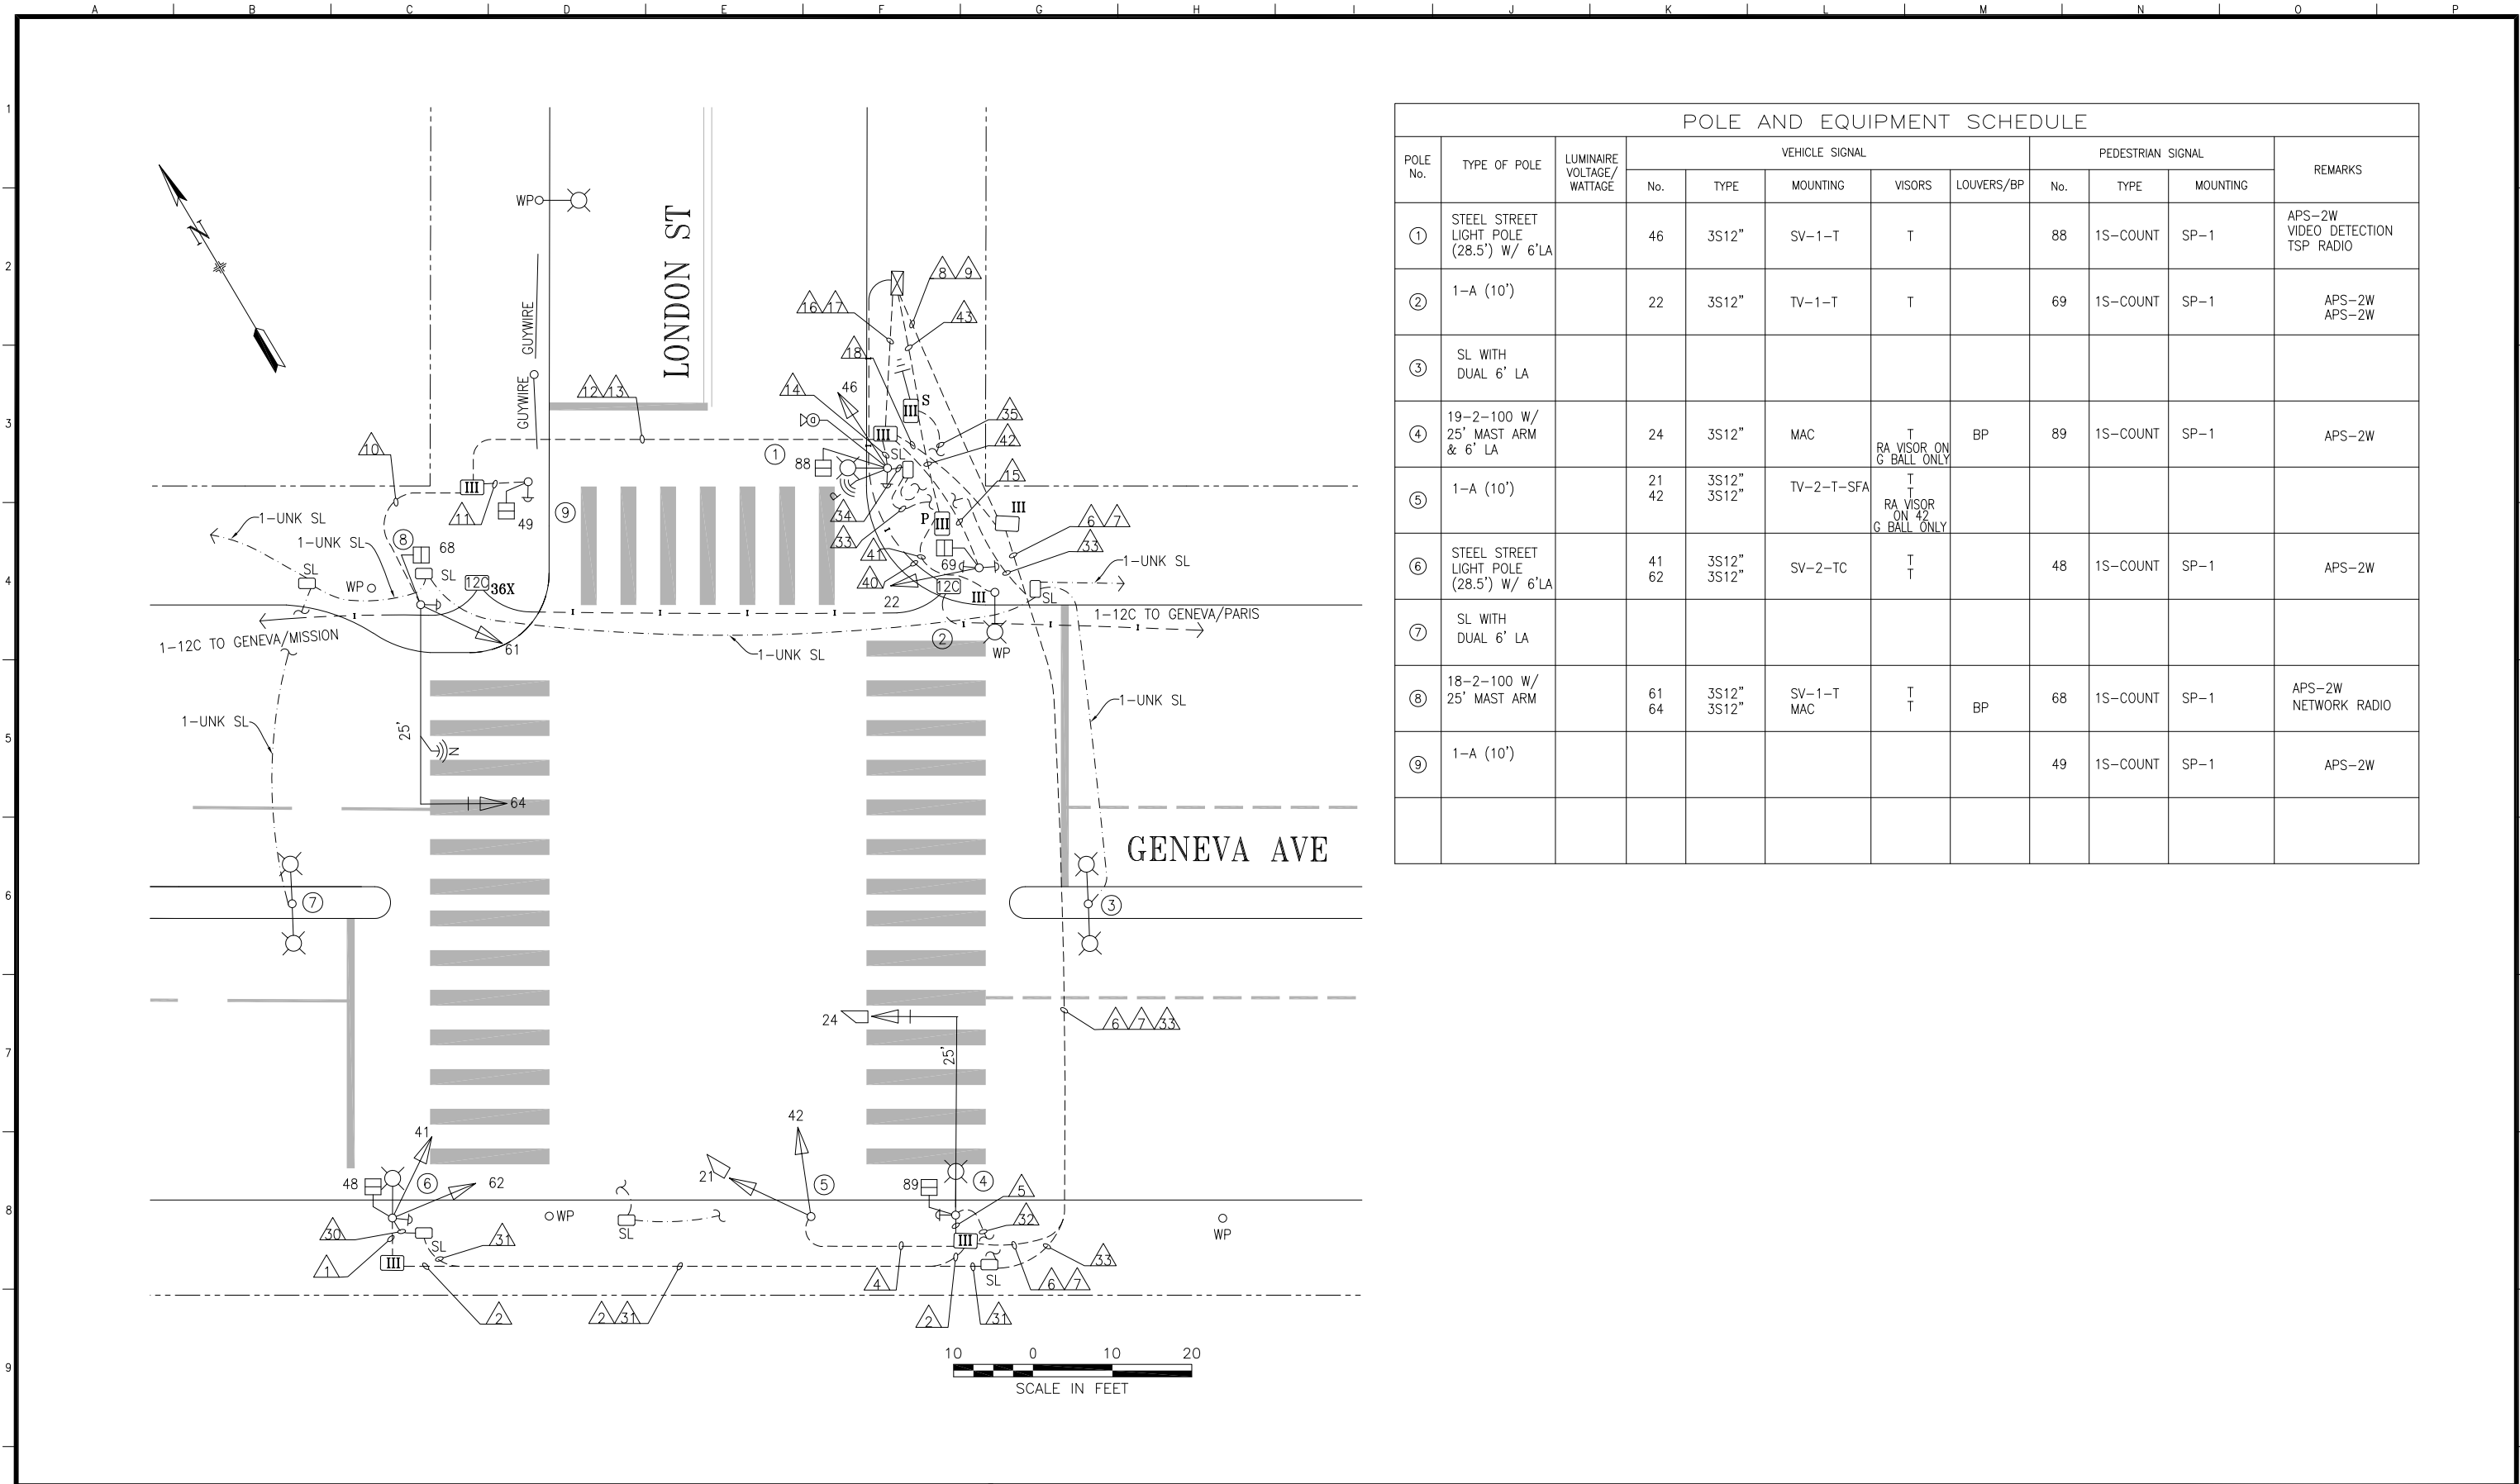

POLE AND EQUIPMENT SCHEDULE											
POLE No.	TYPE OF POLE	LUMINAIRE VOLTAGE/ WATTAGE	VEHICLE SIGNAL					PEDESTRIAN SIGNAL			REMARKS
			No.	TYPE	MOUNTING	VISORS	LOUVERS/BP	No.	TYPE	MOUNTING	
①	STEEL STREET LIGHT POLE (28.5') W/ 6'LA		46	3S12"	SV-1-T	T		88	1S-COUNT	SP-1	APS-2W VIDEO DETECTION TSP RADIO
②	1-A (10')		22	3S12"	TV-1-T	T		69	1S-COUNT	SP-1	APS-2W APS-2W
③	SL WITH DUAL 6' LA										
④	19-2-100 W/ 25' MAST ARM & 6' LA		24	3S12"	MAC	T RA VISOR ON G BALL ONLY	BP	89	1S-COUNT	SP-1	APS-2W
⑤	1-A (10')		21 42	3S12" 3S12"	TV-2-T-SFA	T RA VISOR ON 42 G BALL ONLY					
⑥	STEEL STREET LIGHT POLE (28.5') W/ 6'LA		41 62	3S12" 3S12"	SV-2-TC	T T		48	1S-COUNT	SP-1	APS-2W
⑦	SL WITH DUAL 6' LA										
⑧	18-2-100 W/ 25' MAST ARM		61 64	3S12" 3S12"	SV-1-T MAC	T T	BP	68	1S-COUNT	SP-1	APS-2W NETWORK RADIO
⑨	1-A (10')							49	1S-COUNT	SP-1	APS-2W

Δ	4/13/23	CONVERTED FROM CONTRACT 1000016818 AS-BUILTS	D. YEUNG	G. DE LEON	
NO.	DATE	DESCRIPTION	BY	APPROVED	
TABLE OF REVISIONS CHECKOUT DRAWING THROUGH THE SID CUSTODIAN FOR THE LATEST REVISION					



SFMTA

DRAWN BY: D. YEUNG	DATE: AUG 2023
CHECKED BY: G. DE LEON	DATE: AUG 2023

SCALE AS SHOWN
SHEET OF SHEETS 1 OF 2

TRAFFIC SIGNAL INVENTORY DIAGRAM
GENEVA AVE AND LONDON ST

CNN NO: 21475000
REV NO: 0

SHEET NOTES

 PG&E-FURNISHED 1/0A TPX CABLES



DRAWN BY: D. YEUNG	DATE: AUG 2023
CHECKED BY: G. DE LEON	DATE: AUG 2023

SCALE NONE
SHEET OF SHEETS 2 OF 2

TRAFFIC SIGNAL INVENTORY DIAGRAM
GENEVA AVE AND LONDON ST CONDUIT AND WIRING SCHEDULE

CNN NO: 21475000
REV NO: 0