




POLE AND EQUIPMENT SCHEDULE											
POLE No.	TYPE OF POLE	LUMINAIRE VOLTAGE/ WATTAGE	VEHICLE SIGNAL					PEDESTRIAN SIGNAL			REMARKS
			No.	TYPE	MOUNTING	VISORS	LOUVERS/BP	No.	TYPE	MOUNTING	
①	STEEL STREET LIGHT POLE (28.5') W/ 6' LA		81	3S12"	SV-1-T	T		88	1S-COUNT	SP-1	APS-2W VIDEO DETECTION TSP RADIO
②	1-A (10')		22	3S12"	TV-1-T	T		69	1S-COUNT	SP-1	
②A	PPB POLE										APS-2W
③	19-2-100 W/ 25' MAST ARM & 6' LA		21 24	3S12" 3S12"	SV-1-T MAC	T T	BP HORIZ LOUVER ON 24 G BALL	28	1S-COUNT	SP-1	APS-2W
④	1-A (13')		42 85	3S12" 3S12"	TV-2-T	T T		89	1S-COUNT	SP-1	APS-2W
⑤	28.5' STEEL STREET LIGHT POLE W/ DUAL 6' LA		43	3S12"	SV-1-T	T					
⑥	1-A (10')		41	3S12"	TV-1-T	T		48	1S-COUNT	SP-1	APS-2W
⑦	STEEL STREET LIGHT POLE (28.5') W/ 6' LA		62	3S12"	SV-1-T	T		29	1S-COUNT	SP-1	APS-2W
⑧	18-2-100 W/ 25' MAST ARM		61 64	3S12" 3S12"	SV-1-T MAC	T T	BP	68	1S-COUNT	SP-1	APS-2W NETWORK RADIO x2
⑨	1-A (10')		82 45	3S12" 3S12"	TV-2-T	T T	BP	49	1S-COUNT	SP-1	APS-2W
⑩	28.5' STEEL SL W/ DUAL 6' LA & SPECIAL SPREAD FOOTING OF LIGHTWEIGHT CONCRETE										
⑪	28.5' STEEL STREET LIGHT POLE W/ DUAL 6' LA										

Δ	4/13/23	CONVERTED FROM CONTRACT 1000016818 AS-BUILTS	D. YEUNG	G. DE LEON
NO.	DATE	DESCRIPTION	BY	APPROVED
TABLE OF REVISIONS CHECKOUT DRAWING THROUGH THE SID CUSTODIAN FOR THE LATEST REVISION				

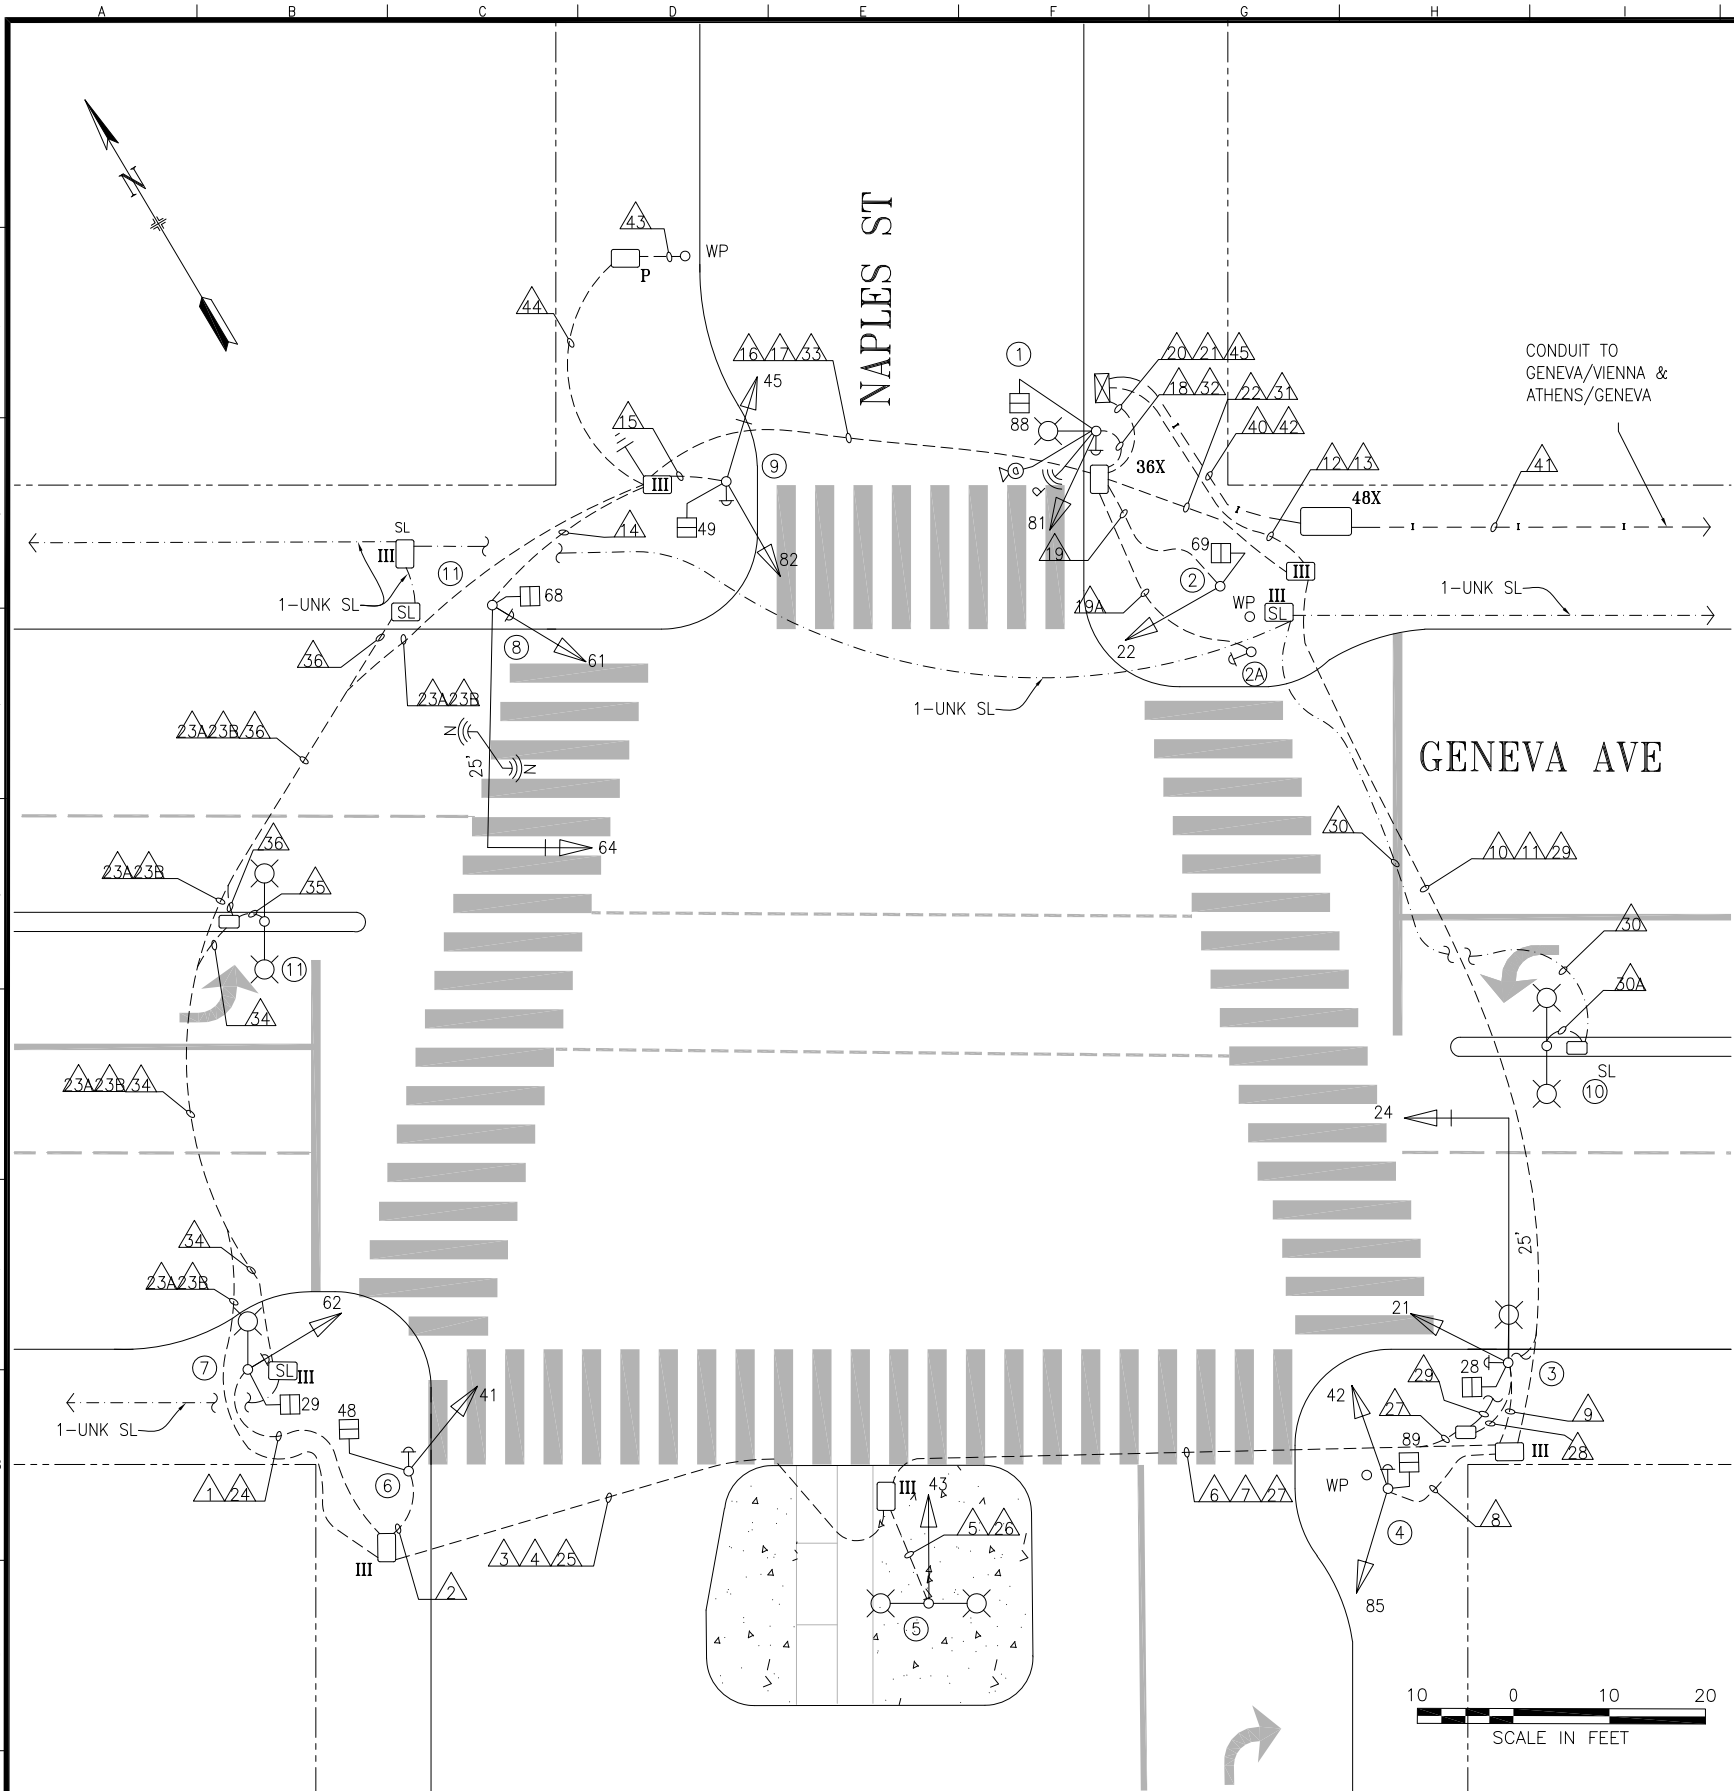

DRAWN BY: D. YEUNG	DATE: AUG 2023
CHECKED BY: G. DE LEON	DATE: AUG 2023

SCALE AS SHOWN
SHEET OF SHEETS 1 OF 2

TRAFFIC SIGNAL INVENTORY DIAGRAM
GENEVA AVE AND NAPLES ST

CNN NO: 21426000
REV NO: 0

[illegible]

1 4-2" HDPE SCHEDULE 80 CONDUIT WITH 3/8" PULL TAPE IN EACH CONDUIT. IN ONE OF THE EMPTY CONDUITS, THERE ARE THREE #8 AWG UF STRANDED COPPER WIRES (ONE WITH RED, ONE WITH WHITE AND THE OTHER WITH GREEN INSULATION). IN A SEPARATE EMPTY CONDUIT, THERE IS ONE #10 AWG UF STRANDED LOCATING WIRE WITH GREEN INSULATION.

2 PG&E-INSTALLED 1/0 TPX CABLE

△	4/13/23	CONVERTED FROM CONTRACT 1000016818 AS-BUILTS	D. YEUNG	G. DE LEON
NO.	DATE	DESCRIPTION	BY	APPROVED
TABLE OF REVISIONS				
CHECKOUT DRAWING THROUGH THE SID CUSTODIAN FOR THE LATEST REVISION				



SFMTA

DRAWN BY: D. YEUNG DATE: AUG 2023

CHECKED BY:	DATE:
G. DE LEON	AUG 2023

SCALE

NONE

SHEET OF SHEETS

2 OF 2

TRAFFIC SIGNAL INVENTORY DIAGRAM

GENEVA AVE AND NAPLES ST CONDUIT AND WIRING SCHEDULE

CNN NO:

21426000

REV NO:

0