


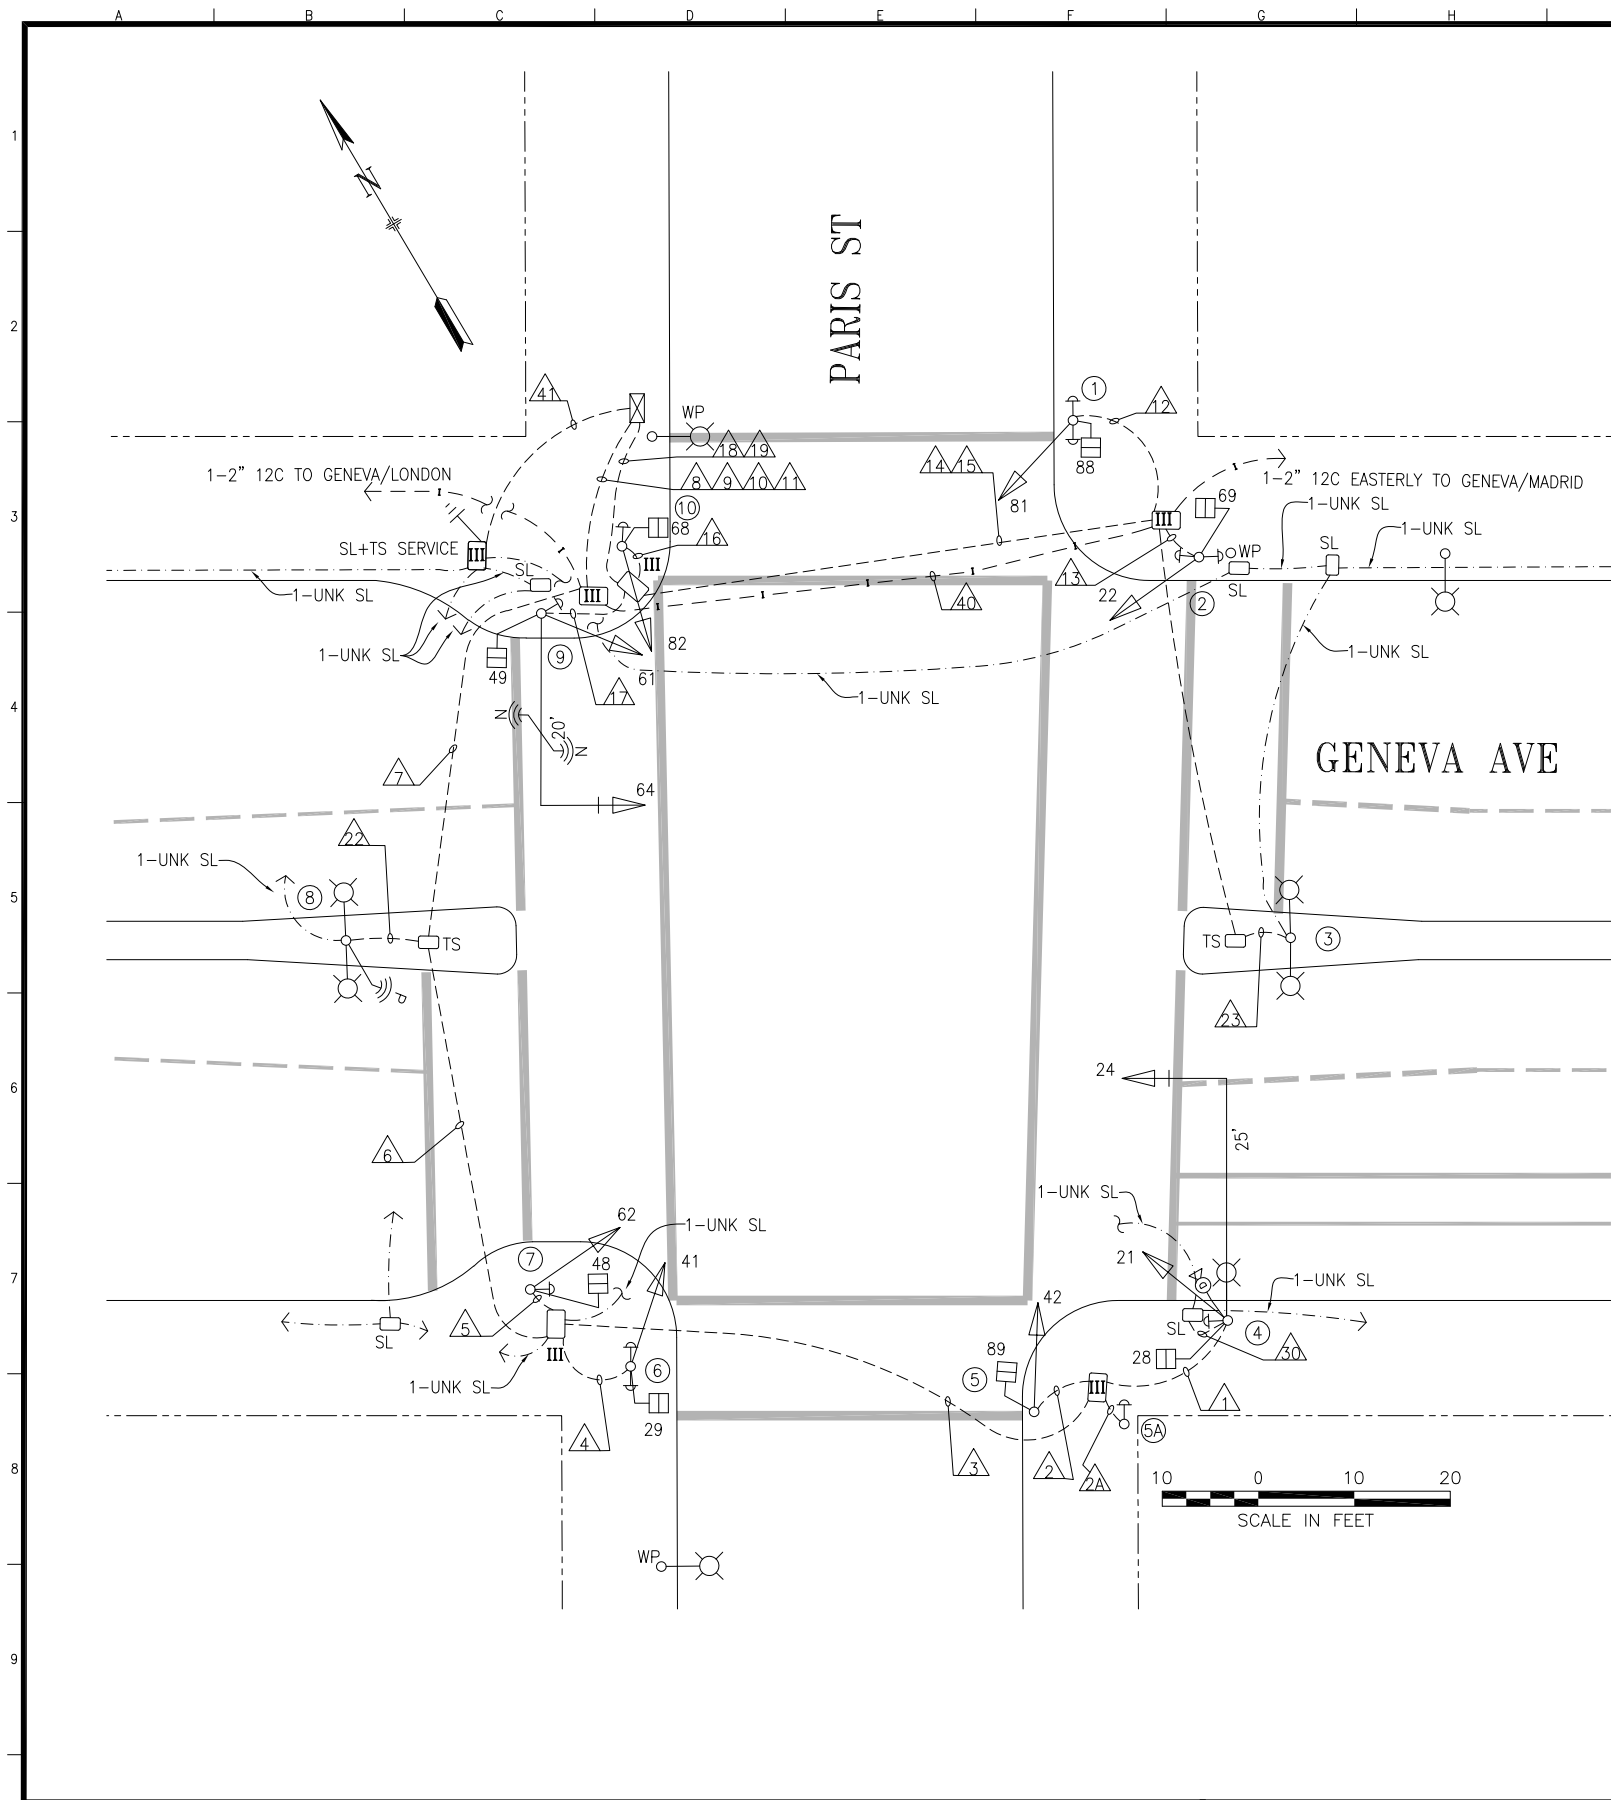

POLE AND EQUIPMENT SCHEDULE											
POLE No.	TYPE OF POLE	LUMINAIRE VOLTAGE/ WATTAGE	VEHICLE SIGNAL					PEDESTRIAN SIGNAL			REMARKS
			No.	TYPE	MOUNTING	VISORS	LOUVERS/BP	No.	TYPE	MOUNTING	
①	1-A (10')		81	3S12"	TV-1-T	T		88	1S-COUNT	SP-1	APS-2W APS-2W
②	1-A (10')		22	3S12"	TV-1-T	T		69	1S-COUNT	SP-1	APS-2W APS-2W
③	SL WITH DUAL 6' LA										
④	19-2-100 W/ 25' MAST ARM & 6' LA		21 24	3S12" 3S12"	SV-1-T MAC	T T	BP	28	1S-COUNT	SP-1	APS-2W VIDEO DETECTION
⑤	1-A (10')		42	3S12"	TV-1-T	T		89	1S-COUNT	SP-1	
⑤A	PPB POLE										APS-2W
⑥	1-A (10')		41	3S12"	TV-1-T	T		29	1S-COUNT	SP-1	APS-2W APS-2W
⑦	1-A (10')		62	3S12"	TV-1-T	T		48	1S-COUNT	SP-1	APS-2W
⑧	SL WITH DUAL 6' LA										TSP RADIO
⑨	16-2-100 W/ 20' MAST ARM		61 64	3S12" 3S12"	SV-1-T MAC	T T	BP HORIZ LOUVER ON 64' G BALL	49	1S-COUNT	SP-1	APS-2W NETWORK RADIO x2
⑩	1-A (10')		82	3S12"	TV-1-T	T		68	1S-COUNT	SP-1	APS-2W

Δ	4/13/23	CONVERTED FROM CONTRACT 1000016818 AS-BUILTS	D. YEUNG	G. DE LEON	
NO.	DATE	DESCRIPTION	BY	APPROVED	
TABLE OF REVISIONS					
CHECKOUT DRAWING THROUGH THE SID CUSTODIAN FOR THE LATEST REVISION					



DRAWN BY:
D. YEUNG

DATE:
AUG 2023

CHECKED BY:
G. DE LEON

DATE:
AUG 2023

SCALE
AS SHOWN

SHEET OF SHEETS
1 OF 2

TRAFFIC SIGNAL INVENTORY DIAGRAM

GENEVA AVE AND PARIS ST

CNN NO:
21444000

REV NO:
0

[illegible][illegible]