


*Z*

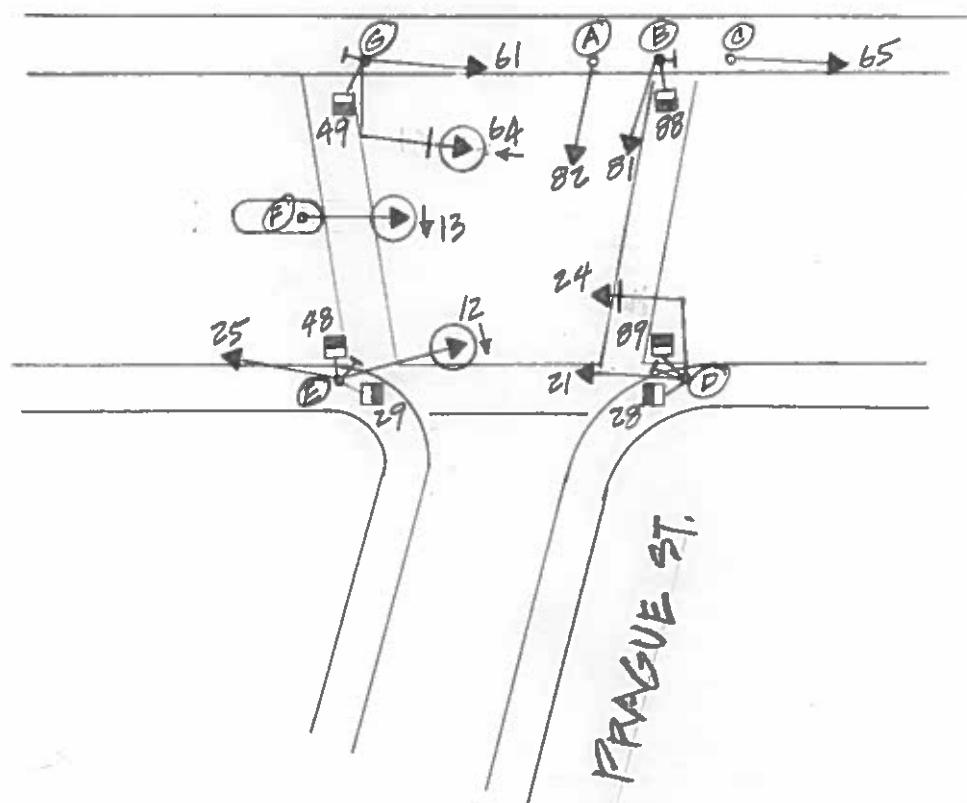

9-18-13

[illegible]

COMMENTS: UPGRADED 21 AND 25 TO 12" - ET