


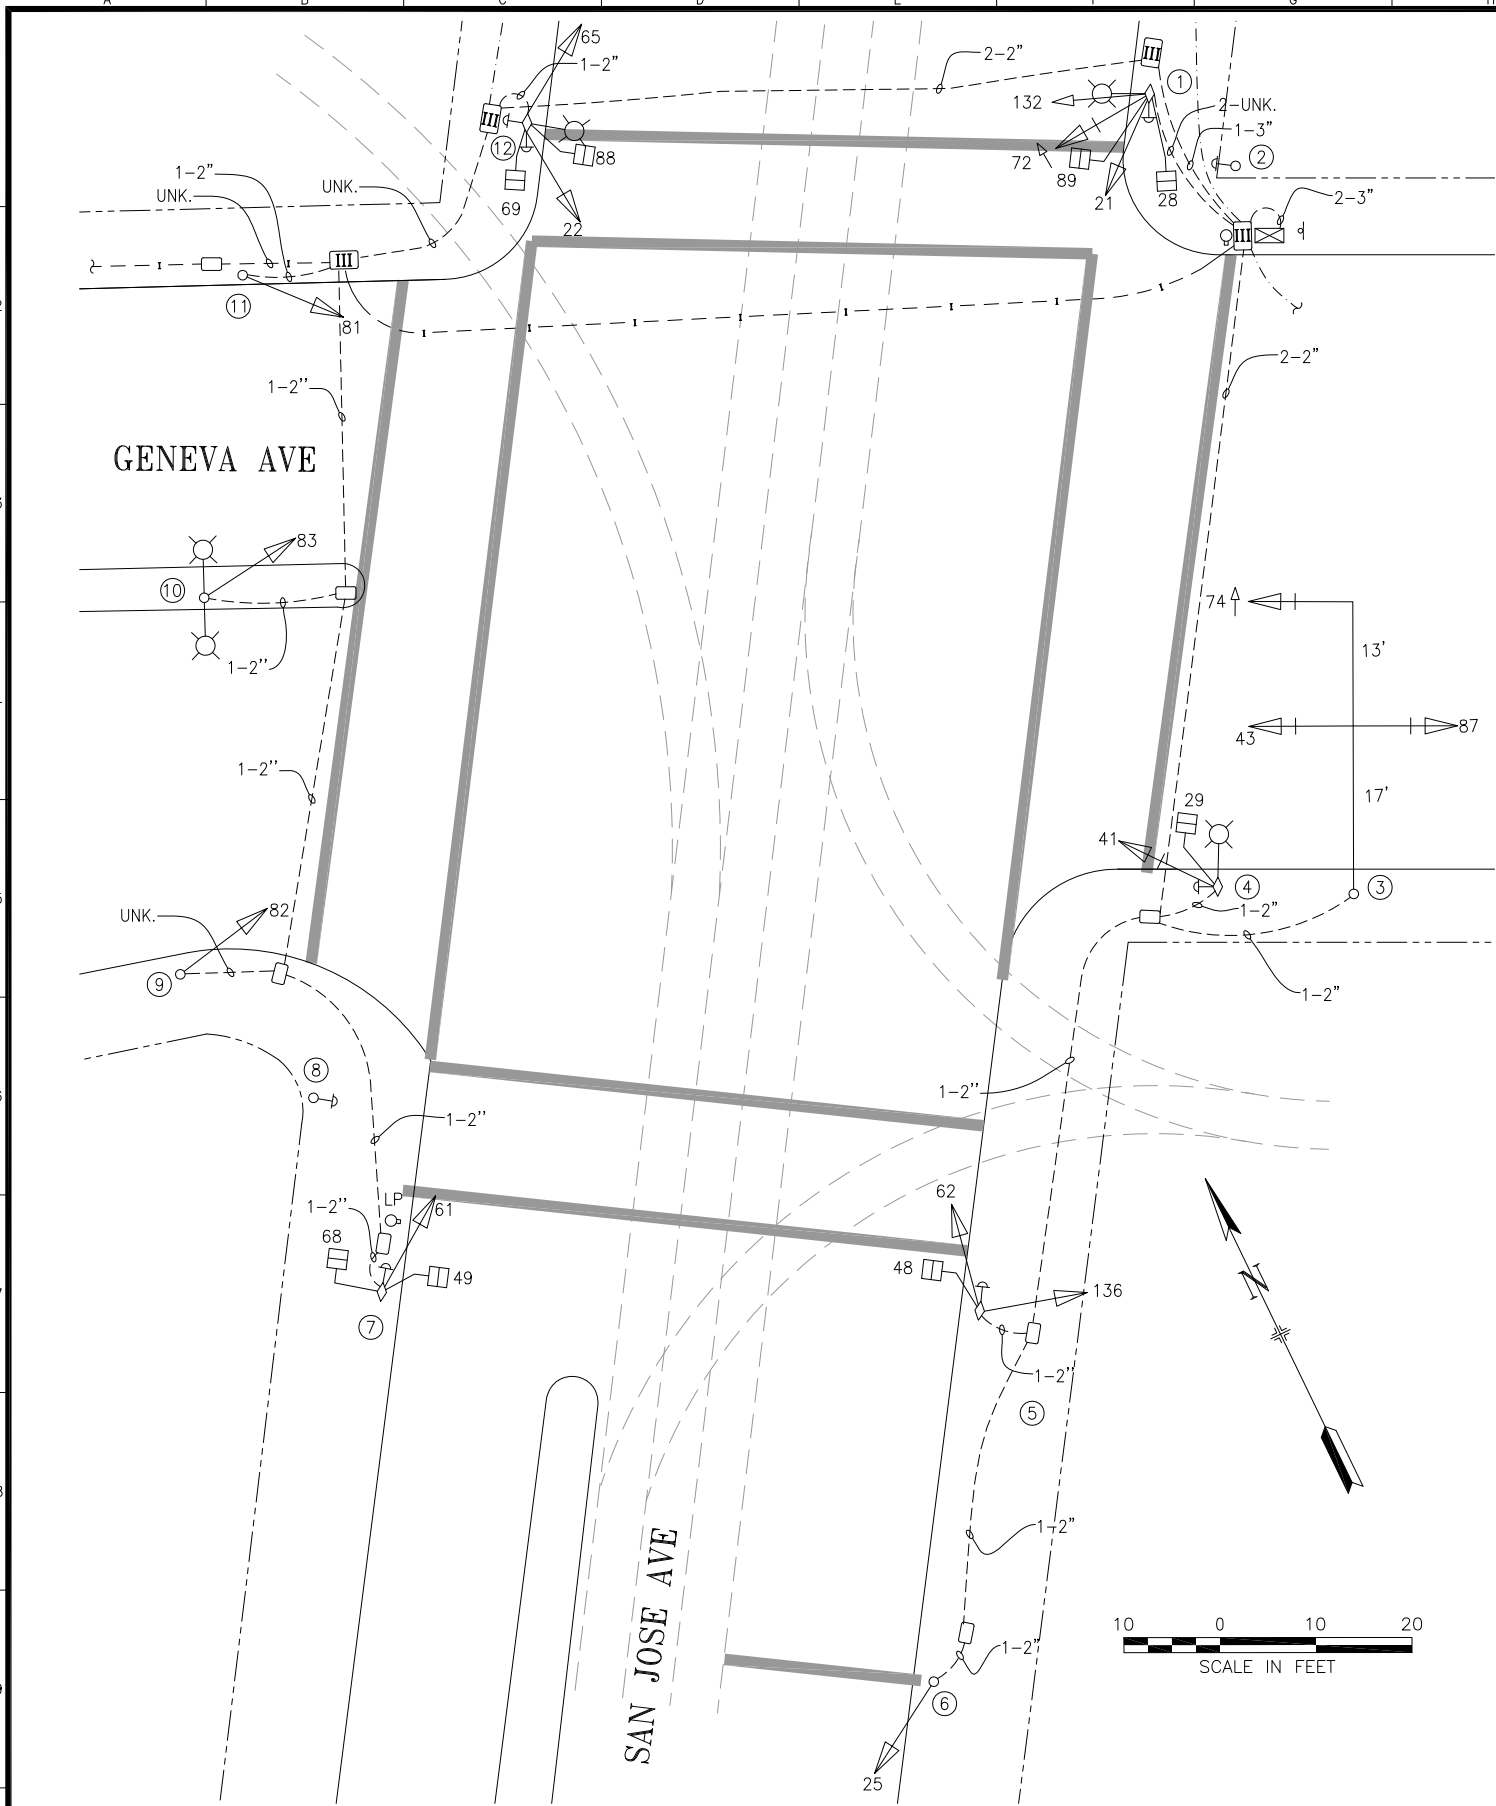

POLE AND EQUIPMENT SCHEDULE										
POLE No.	TYPE OF POLE	VEHICLE SIGNAL					PEDESTRIAN SIGNAL			REMARKS
		No.	TYPE	MOUNTING	VISORS	LOUVERS	No.	TYPE	MOUNTING	
①	MUNI	21 72 132	3S12" 3S12"LA 2S8"-X	SV-2-TA SV-1	T T		28 89	1S-COUNT 1S-COUNT	SP-1 (22") SP-1-SF (12")	APS PPB
②	PPB POLE									APS PPB
③	18-3-100 W/30' MAST ARM	43 74 87	3S12" 3S12"LA 3S12"	MAS MAS MAS	T T T					BACKPLATE BACKPLATE BACKPLATE
④	MUNI POLE WITH LUMINAIRE	41	3S12"	SV-1			29	1S-COUNT	SP-1	BACKPLATE APS PPB
⑤	MUNI	62 136	3S12" 2S12"-T	SV-2A			48	1S-COUNT	SP-1-SF	APS PPB
⑬	1-A (10')	25	3S12"	TV-1-T	T					
⑦	MUNI	61	3S12"	SV-1			49 68	1S-COUNT 1S-COUNT	SP-1 SP-1	APS PPB
⑧	PPB POLE									APS PPB
⑨	PEDESTAL BASE POLE	82	3S12"	TV-1-T	T					
⑩	CITY STANDARD STREETLIGHT	83	3S12"	SV-1	T					MOUNT 83 AT 13'
⑪	1-A (10')	81	3S12"	TV-1-T						VEH. SIGNAL 81 MOUNTING EXTENDS NORTH AWAY FROM THE CURB
⑫	MUNI POLE WITH LUMINAIRE	22 65	3S12" 3S12"	SV-2-TA	T T		69 88	1S-COUNT 1S-COUNT	SP-1 (22") SP-1-SF (12")	APS PPB APS PPB

						REFERENCE INFORMATION & FILE NO. OF SURVEYS	
0	8/7/14	MOD ACTIVATED THRU 2108J; CONVERTED FROM CONTRACT PLANS				JH	MV
NO.	DATE	DESCRIPTION				BY	APP.
TABLE OF REVISIONS							
CHECK WITH TRACING TO SEE IF YOU HAVE LATEST REVISION							



SAN FRANCISCO MUNICIPAL TRANSPORTATION AGENCY

CITY AND COUNTY OF SAN FRANCISCO

DRAWN: JH CHECKED: MV	DATE: 09/2015	SCALE: AS SHOWN SHEET OF SHEETS 1 OF 1	TRAFFIC SIGNAL INVENTORY DIAGRAM	CNN NO. 22105000
			GENEVA AVE & SAN JOSE AVE	REV NO. 0