




POLE AND EQUIPMENT SCHEDULE											
POLE No.	TYPE OF POLE	LUMINAIRE VOLTAGE/WATTAGE	VEHICLE SIGNAL					PEDESTRIAN SIGNAL			REMARKS
			No.	TYPE	MOUNTING	VISORS	LOUVERS	No.	TYPE	MOUNTING	
①	CITY STANDARD STREET LIGHT							88	1S-COUNT	SP-1	
②	1-A (10')		22	4S12"GRA	TV-1-T	T		69 130	1S-COUNT 1S-COUNT	SP-2 (CUSTOM)	MOUNT SIGNAL 22 ON BUILDING SIDE OF POLE
③	CITY STANDARD STREET LIGHT		21	4S12"GRA	SV-1-T	T		28	1S-COUNT	SP-1	
④	1-A (10')		42	4S12"GLA	TV-1-T	T		89 138	1S-COUNT 1S-COUNT	SP-2-T-SF	
⑤	CITY STANDARD STREET LIGHT		41	4S12"GLA	SV-1-T	T		48 29 137	1S-COUNT 1S-COUNT 1S-COUNT	SP-3 (CUSTOM)	
⑥	CITY STANDARD STREET LIGHT							49 68 139	1S-COUNT 1S-COUNT 1S-COUNT	SP-3 (CUSTOM)	NETWORK RADIO

4	8/31/23	PUNCHLIST 198 MCALLISTER CONSTRUCTION AT SE: NEW III BOX & RELOC 138. NETWORK RADIO PER FIELD	D. YEUNG	N. WONG
3	5/13/21	ADD DIAGONAL PED SIGNALS (SRC 2021-056)	D. Yeung	B.Woo
2	6/13/19	CHANGED ALL VEHICLE HEADS TO 4S12" WITH GREEN ARROW	JShahmiri	R.Oleo
1	8/06/15	2543J PUNCHLIST WALKTHROUGH; UPGRADE TO 12"	DYeung	MVelasco
0	3/29/05	TENDERLOIN TRAFFIC SIGNAL UPGRADE; CONVERTED FROM CONTRACT PLANS	AScales	MVelasco
NO.	DATE	DESCRIPTION	BY	APPROVED
TABLE OF REVISIONS				
CHECKOUT DRAWING THROUGH THE SID CUSTODIAN FOR THE LATEST REVISION				

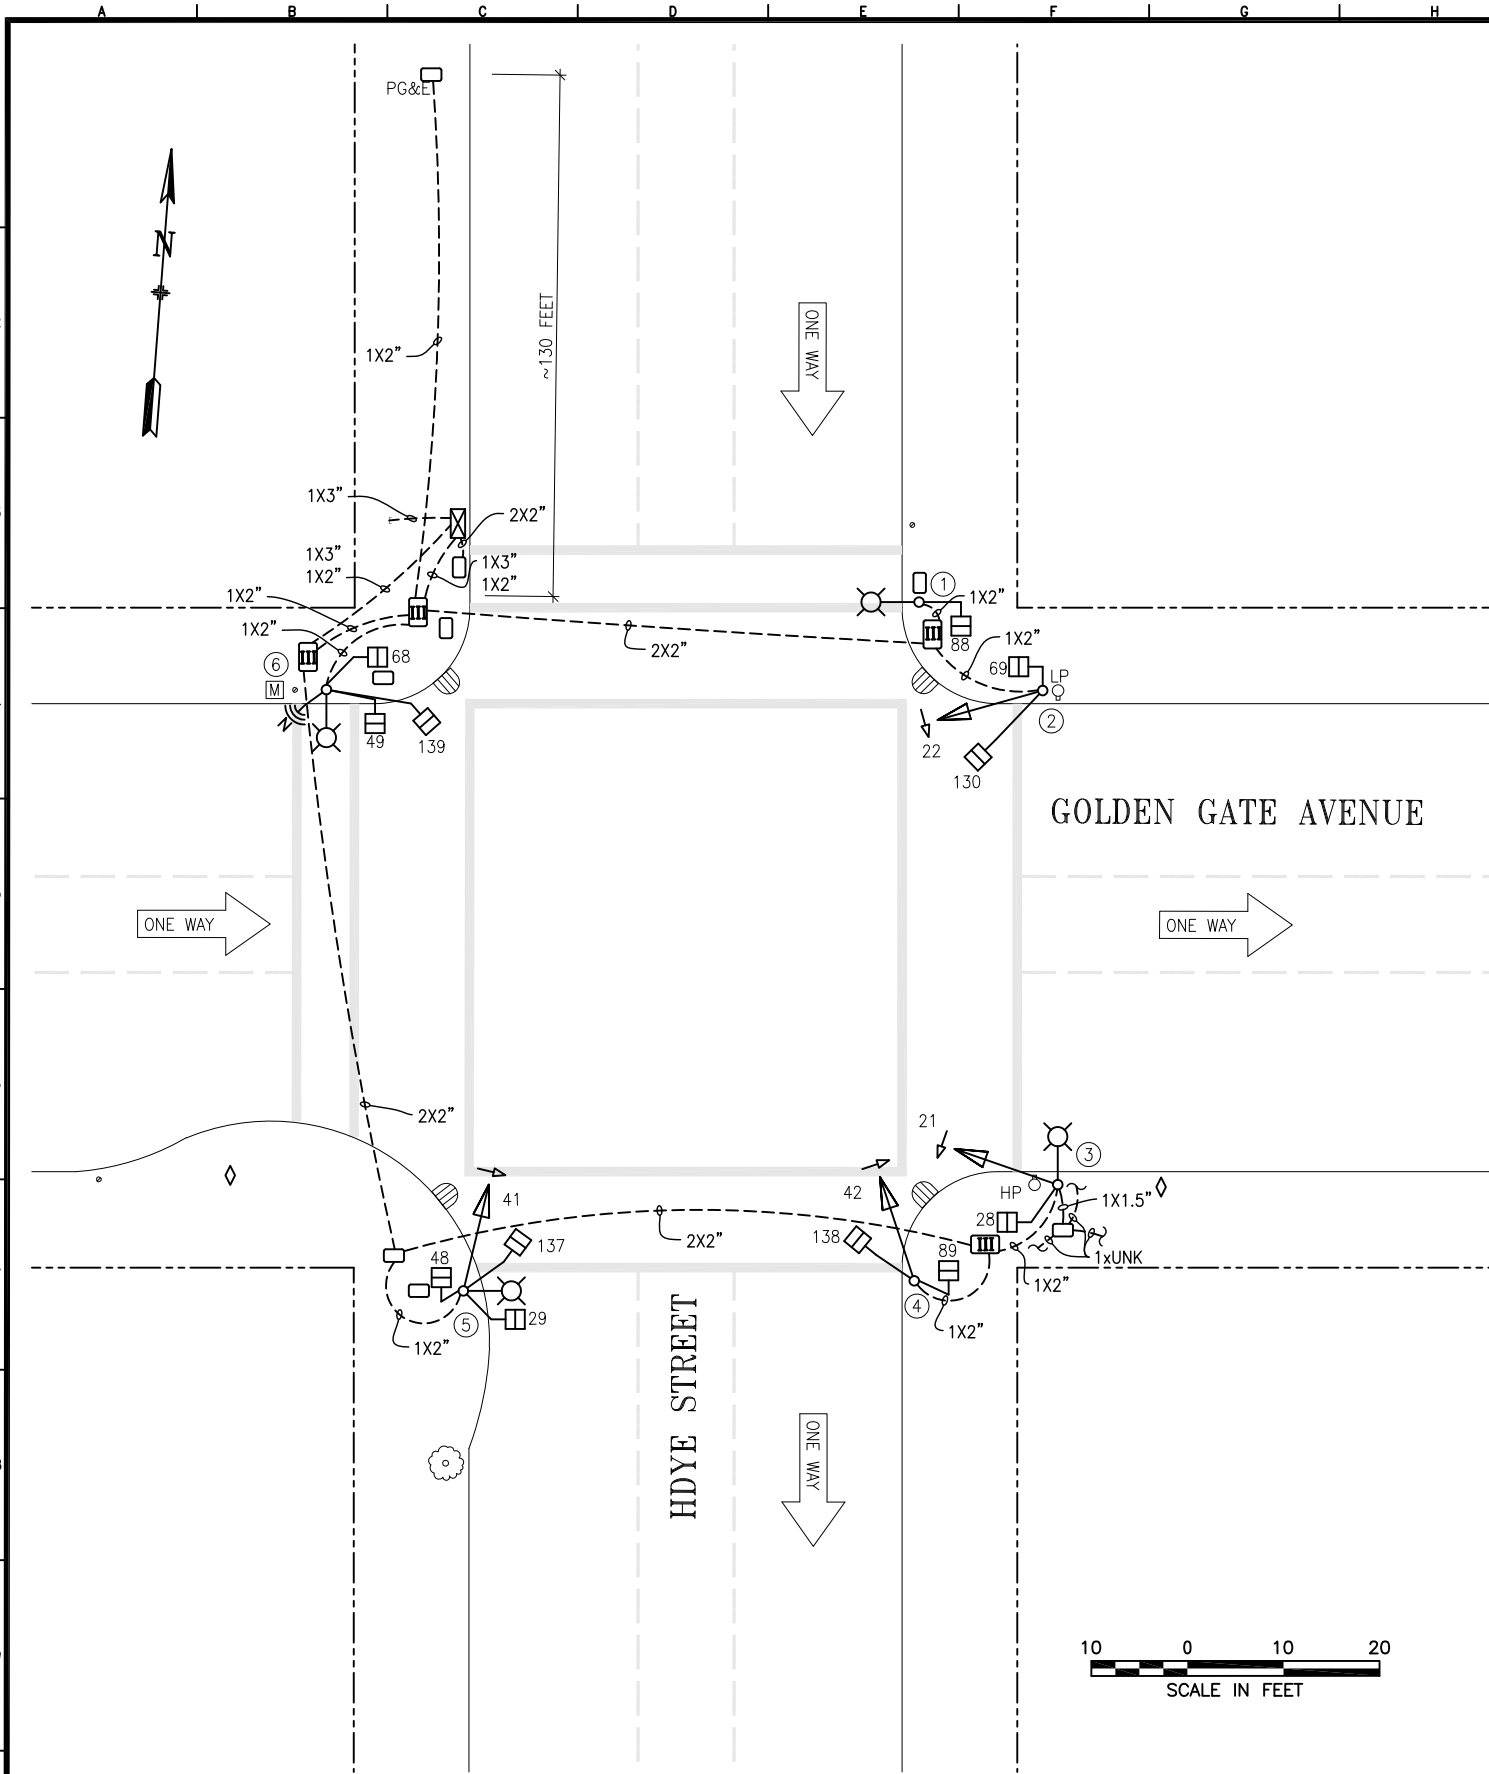

SFMTA

DRAWN BY:	DATE:
AScales	12/2015
CHECKED BY:	DATE:
MVelasco	12/2015

SCALE
AS SHOWN
SHEET OF SHEETS
1 OF 1

TRAFFIC SIGNAL INVENTORY DIAGRAM
GOLDEN GATE AVENUE AND HYDE STREET

CNN NO:
24431000
REV NO:
4