


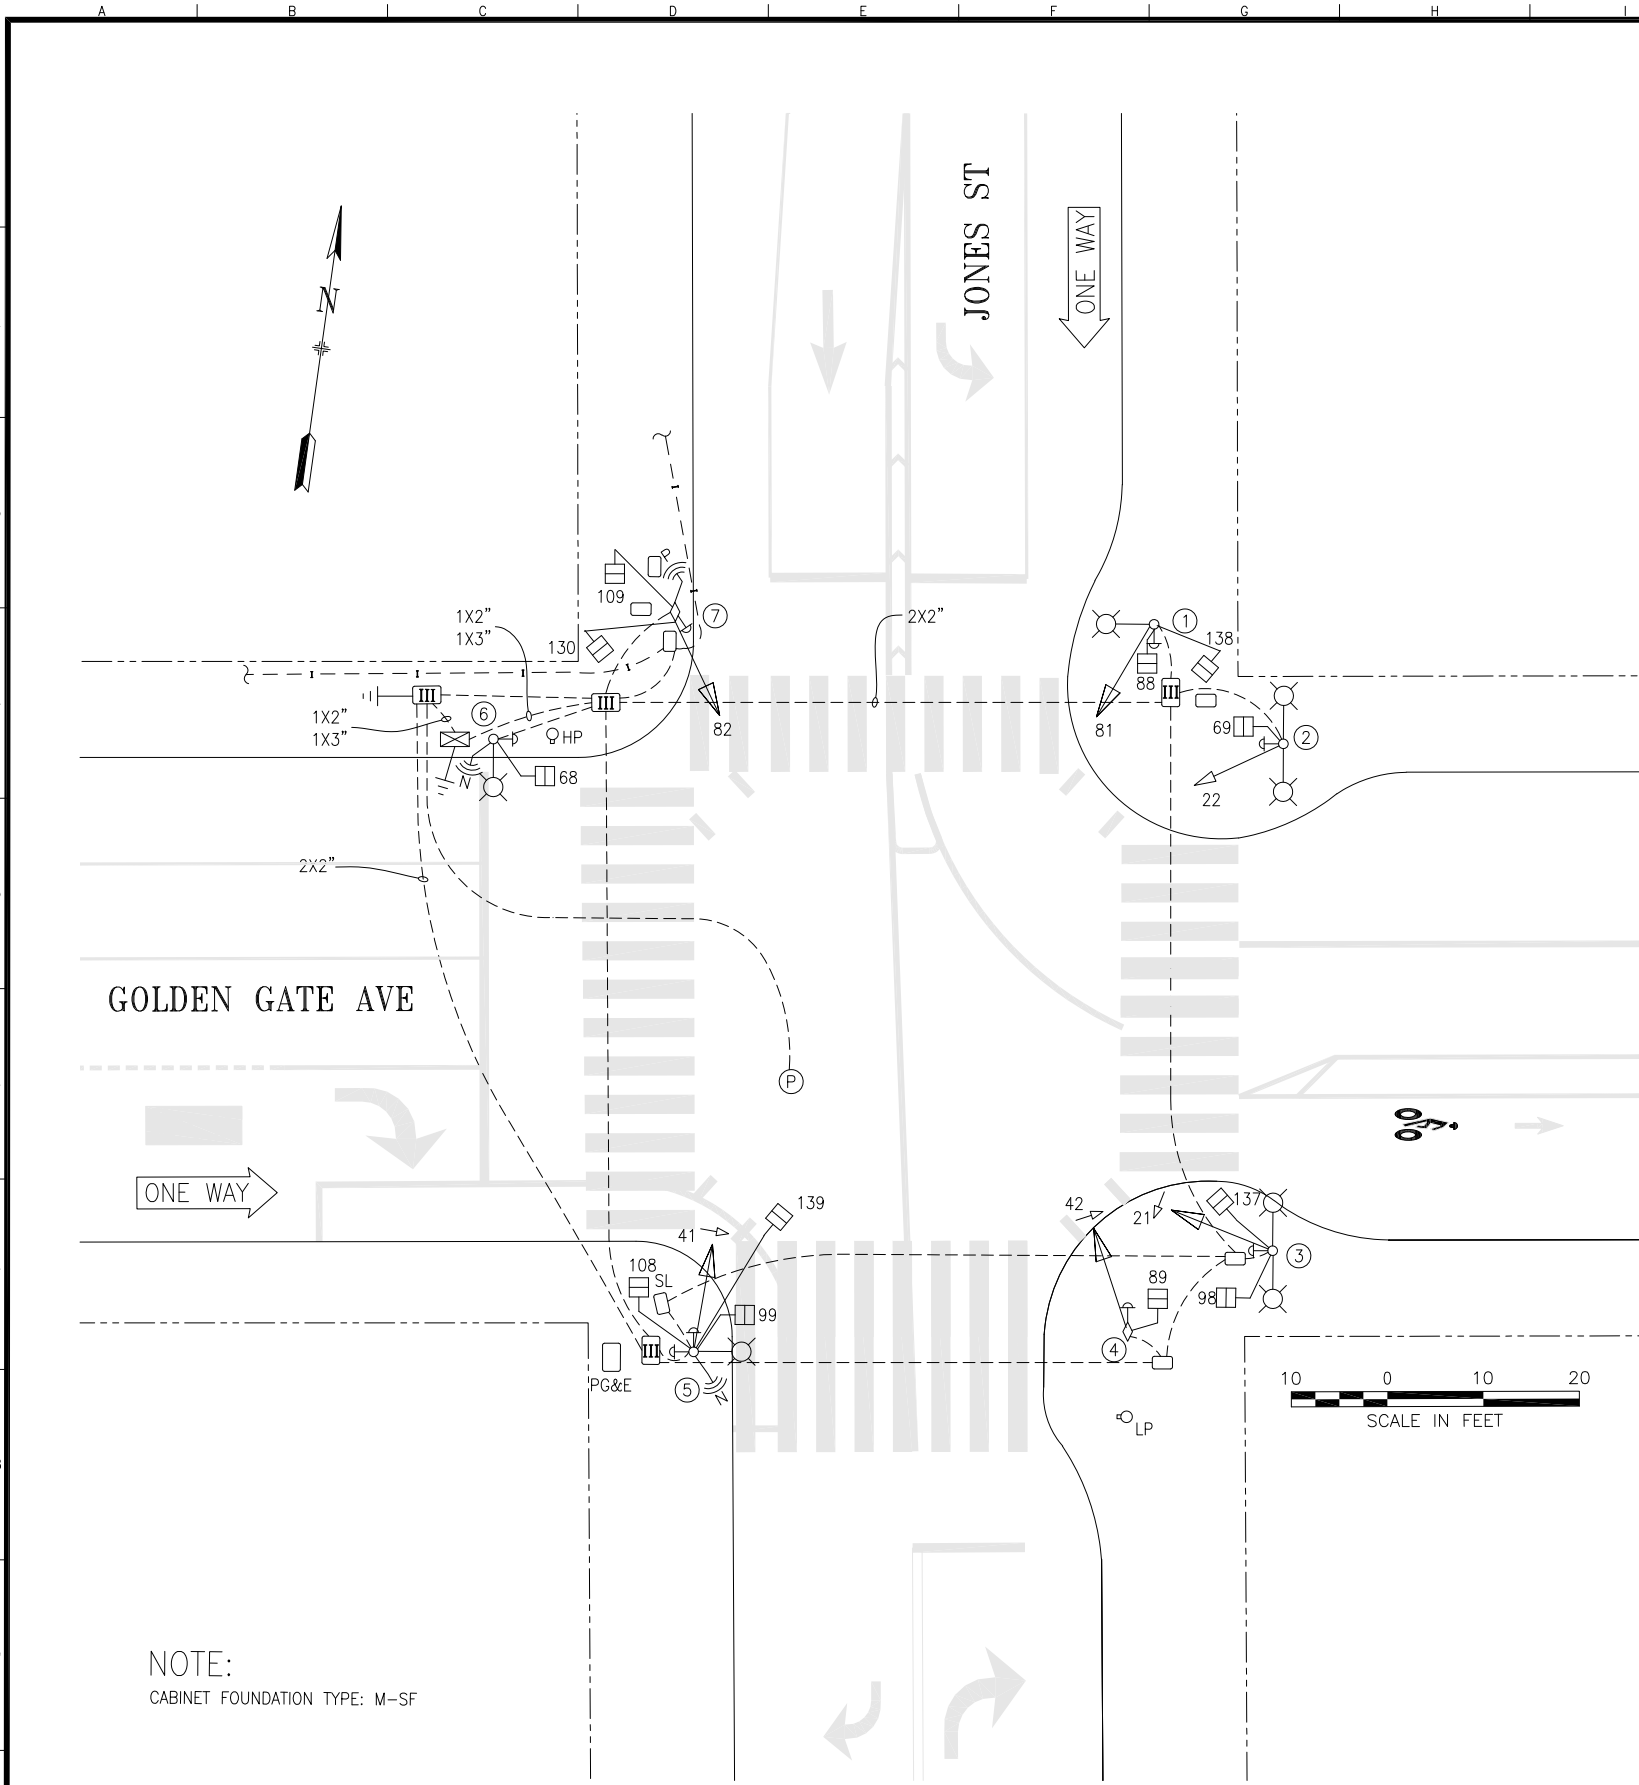

POLE AND EQUIPMENT SCHEDULE											
POLE No.	TYPE OF POLE	LUMINAIRE VOLTAGE/ WATTAGE	VEHICLE SIGNAL					PEDESTRIAN SIGNAL			REMARKS
			No.	TYPE	MOUNTING	VISORS	LOUVERS	No.	TYPE	MOUNTING	
①	STREET LIGHT		81	3S12"FR	SV-1-T	T		88 138	1S-COUNT 1S-COUNT	SP-2-T-SF	APS-3W
②	ORNAMENTAL STREET LIGHT		22	3S8"	SV-1-T	T		69	1S-COUNT	SP-1	APS-3W
③	STREET LIGHT		21	4S12"GRA	SV-1-T	T		98 137	1S-COUNT 1S-COUNT	SP-2-T-SF	APS-3W
④	MUNI		42	4S12"GLA	SV-1-T	T		89	1S-COUNT	SP-1	APS-3W EXTERNAL CONDUIT
⑤	STREET LIGHT		41	4S12"GLA	SV-1-T	T		99 108 139	1S-COUNT 1S-COUNT 1S-COUNT	SP-1-SF (12") SP-2-T-SF	NETWORK RADIO APS-3W APS-3W
⑥	STREET LIGHT							68	1S-COUNT	SP-1	APS-3W NETWORK RADIO
⑦	MUNI		82	3S12"FR	SV-1-T	T		109 130	1S-COUNT 1S-COUNT	SP-2-T-SF	APS-3W TSP RADIO

NO.	DATE	DESCRIPTION	BY	APPROVED
4	4/20/23	INSTALL NEW APS PER SRC 2022-199. CLARIFY EXISTING NETWORK/TSP RADIOS	D. YEUNG	G. DE LEON
3	10/07/20	PED SCRAMBLE & TWO-WAY JONES CONVERSION: NEW PHASES 8 & 13P (SRC 2019-392)	I. R. TROUT	K. KWONG
2	10/20/19	NOMA/SOMA RETIMING: UPDATE PED PHASE LABELS (SRC 2019-312) PER FIELD: MOVED 109 TO POLE 7	E. LUU	G. DE LEON
1	10/2/13	UPGRADE 21, 41, 42 TO 4S12" W/ GLA OR GRA. MOVE 49 TO POLE 6 PER FIELD.	D. YEUNG	B. WOO
NO.	DATE	DESCRIPTION	BY	APPROVED
TABLE OF REVISIONS				
CHECKOUT DRAWING THROUGH THE SID CUSTODIAN FOR THE LATEST REVISION				



SFMTA

DRAWN BY: GD/RT	DATE: 07/02
CHECKED BY: BW/BC	DATE: 07/02

SCALE AS SHOWN
SHEET OF SHEETS 1 OF 1

TRAFFIC SIGNAL INVENTORY DIAGRAM
GOLDEN GATE AVENUE AND JONES STREET

CNN NO: 24326000
REV NO: 4