


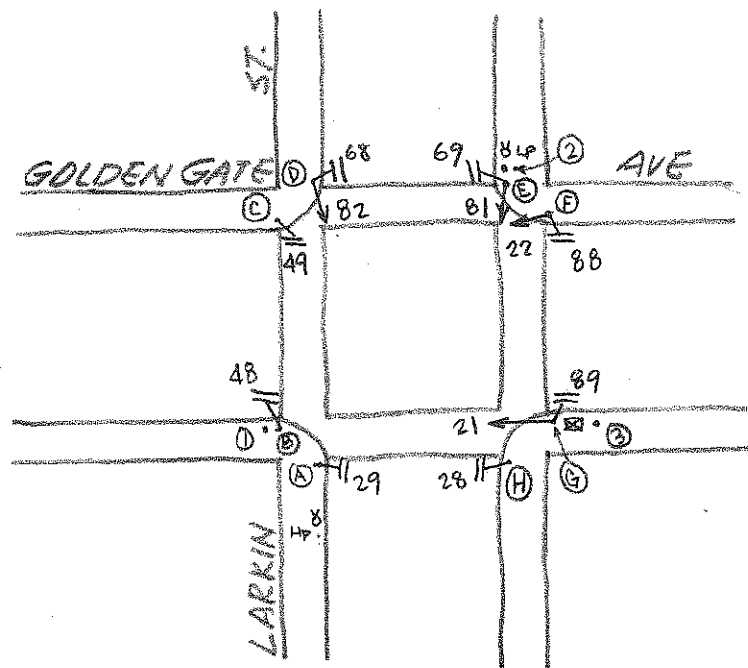

φ2 →

10-14-09

POLE	FUNC.	MAT'L	SIGNAL NO.	MAKE	NO. OF SECT.	SIZE	VISOR	B.P. OR LOUVERS	MOUNT	PED SIGNAL NO.	LEGEND	MESSAGE		MAKE	MOUNT
												ELEMENT	COLOR		
A	L	C	82	EA	3	12"	FL 12"	No	T	29	W/DW	IS-I	OR/W	ICC	S
B	S	C	81	GA	3	8"	FL 12"	No	T	48	W/DW	IS-I	OR/W	ICC	T
C	L	C	22	EA	3	8"	FL 8"	No	T	49	W/DW	IS-I	OR/W	ICC	S
D	S	C	21	EO	3	8"	FL 12"	No	T	68	W/DW	IS-I	OR/W	ICC	S
E	S	C								69	W/DW	IS-I	OR/W	ICC	S
F	S	C								88	W/DW	IS-I	OR/W	ICC	S
G	S	C								89	W/DW	IS-I	OR/W	ICC	S
H	S	C								28	W/DW	IS-I	OR/W	ICC	T
I	M	S													
J	M	S													
K	M	S													

CONTROLLER CABINET SIZE : LARGE BASE CABINET: NO

COMMENTS: SIGNAL 82 TO 12" - ET