


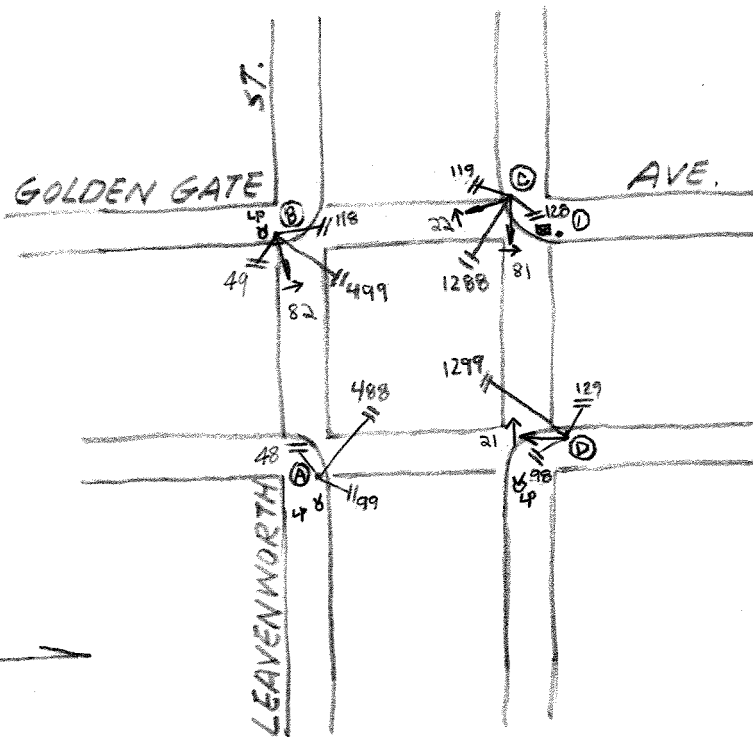

5-5-2021

POLE	FUNC.	MAT'L	SIGNAL NO.	MAKE	NO. OF SECT.	SIZE	VISOR	B.P. OR LOUVERS	MOUNT	PED SIGNAL NO.	LEGEND	MESSAGE		MAKE	MOUNT
												ELEMENT	COLOR		
A	M/L	S	82	ED	4	12" GRA	T	NO	SV-1-T	99	COUNT	LED	W/OR	ICC	SP-2-T-3
B	L	S	22	EA	4	12" GLA	T	NO	SV-2-TC	48	COUNT	LED	W/OR	ICC	SP-2-T-3
C	L	S	81	ED	4	12" GRA	T	NO	SV-2-TC	49	COUNT	LED	W/OR	ICC	SP-1
D	L	S	21	ED	4	12" GLA	T	NO	SV-1-T	118	COUNT	LED	W/OR	ICC	SP-1
										119	COUNT	LED	W/OR	ICC	SP-1
										128	COUNT	LED	W/OR	ICC	SP-1
										129	COUNT	LED	W/OR	ICC	SP-1
										98	COUNT	LED	W/OR	ICC	SP-1
										488	COUNT				
										499	COUNT				
										1288	COUNT				
										1299	COUNT				

CONTROLLER CABINET SIZE : G BASE CABINET: NO

COMMENTS: Add Diagonal Ped signals

SRC 2021-046

D.YEUNG

5-5-2021