


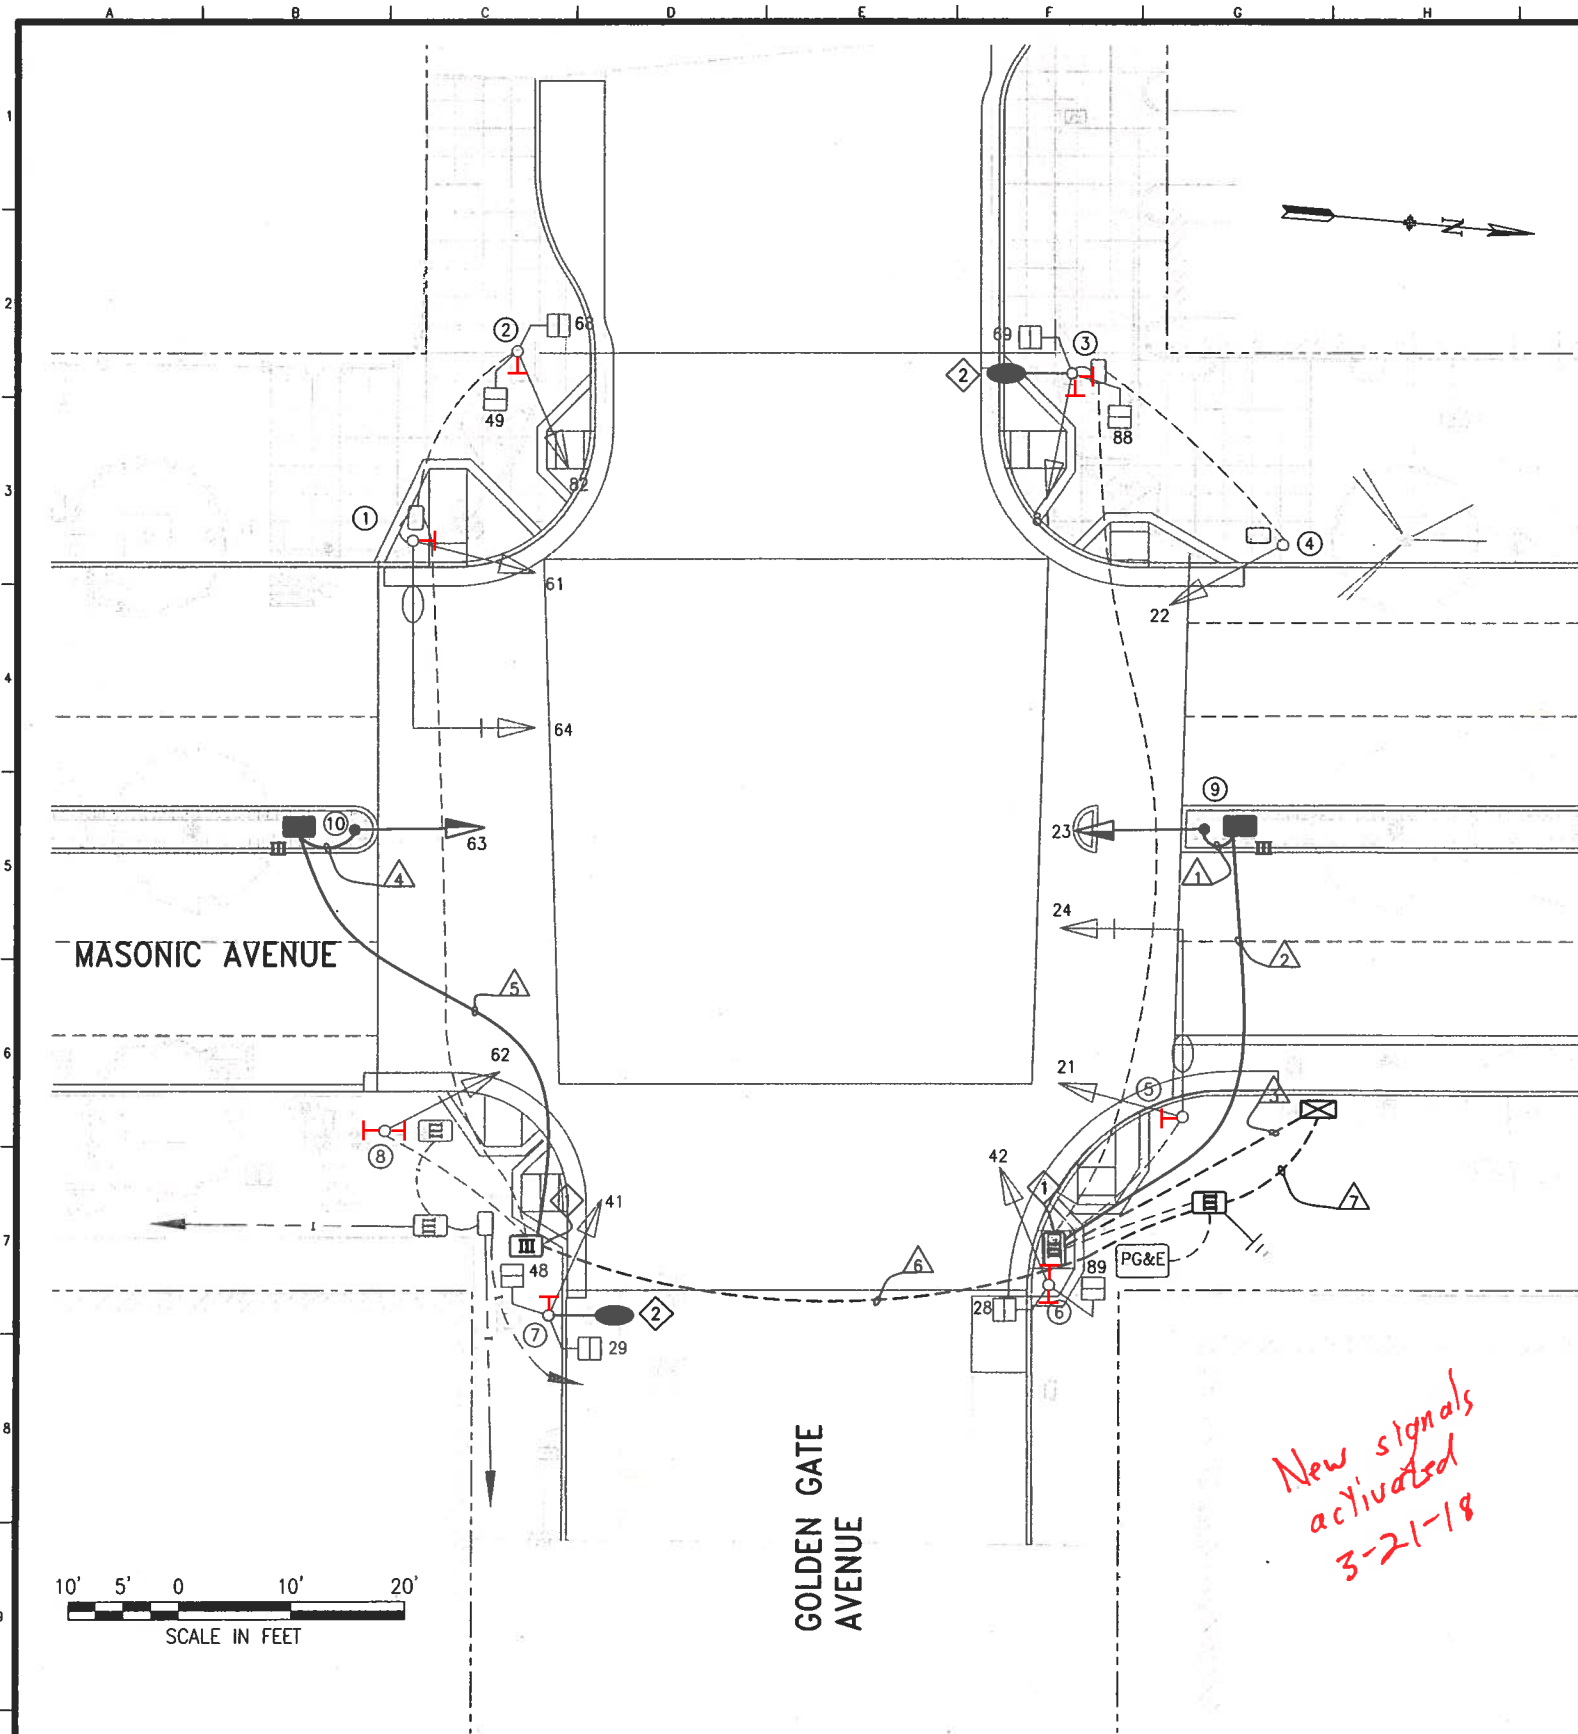

POLE AND EQUIPMENT SCHEDULE											
POLE No.	TYPE OF POLE	LUMINAIRE VOLTAGE/WATTAGE	VEHICLE SIGNAL					PEDESTRIAN SIGNAL			REMARKS
			No.	TYPE	MOUNTING	VISORS	LOUVERS/BP	No.	TYPE	MOUNTING	
①	17-2-100 WITH 20' MAST ARM AND 6' LUMINAIRE ARM	150W	61 64	3S12" 3S12"	SV-1-T MAS	T T	BP				APS-2W
②	POLE (10')		82	3S12"	TV-1-T	T		49 68	1S-COUNT 1S-COUNT	SP-2-CUSTOM	APS-2W
③	SL		81	3S12"	SV-1-T	T		69 88	1S-COUNT 1S-COUNT	SP-2-CUSTOM	APS-2W x 2
④	POLE (10')		22	3S12"	TV-1-T	T					
⑤	17-2-100 WITH 20' MAST ARM AND 6' LUMINAIRE ARM	150W	21 24	3S12" 3S12"	SV-1-T MAS	T T	BP				APS-2W
⑥	POLE (10')		42	3S12"	TV-1-T	T		28 89	1S-COUNT 1S-COUNT	SP-2-CUSTOM	APS-2W x 2
⑦	SL		41	3S12"	SV-1-T	T		29 48	1S-COUNT 1S-COUNT	SP-2-CUSTOM	APS-2W
⑧	POLE (10')		62	3S12"	TV-1-T	T					APS-2W x 2
⑨	1-A (15')		23	3S12"	SV-1-T	T					VEHICLE HEAD MOUNTED @ 10'
⑩	1-A (15')		63	3S12"	SV-1-T	T					VEHICLE HEAD MOUNTED @ 10'

SHEET NOTES:

- SPlice NEW #14 NEUTRAL WIRES TO EXISTING #10 NEUTRAL.
- STREETLIGHT FIXTURE TO BE PROVIDED BY STREETLIGHT CONTRACTOR SEE E-1.3 DRAWINGS FOR STREETLIGHT FIXTURE DETAILS.

CONDUIT AND WIRING SCHEDULE
(FURNISH AND INSTALL CONDUIT)

CONDUIT RUN NUMBER		1	2	3	4	5	6	7
CONDUIT SIZE (INCH)		2	2	2 EX	2	2	2 EX	2 EX
NOTES	VEHICLE SIGNAL 23	3	3	3				
	VEHICLE SIGNAL 63				3	3	3	3
	#14 NEUTRAL	1			1			
	#14 SPARE		3			3		
	TOTAL #14 WIRES	4	6	3	4	6	3	3
	#10 NEUTRAL		1			1		
	#10 WIRES STREET LIGHT							
	#6 BSCW (SEE DRAWING E-0.6)							


(1) 7/3/2023: INSTALL APS (SRC 2023-028). E.LUU, G.DELEON
PER FIELD: UPDATE 22, 62 MOUNTING, PED SIGNAL MOUNTING

NO.	DATE	DESCRIPTION	BY	APP.
TABLE OF REVISIONS				

REFERENCE INFORMATION
& FILE NO. OF SURVEYS



INFRASTRUCTURE DIVISION
DEPARTMENT OF PUBLIC WORKS
CITY AND COUNTY OF SAN FRANCISCO

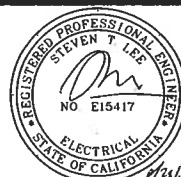

DESIGNED: DATE: 8/21/2015
W.CHAN
DRAWN: DATE: 8/21/2015
W.CHAN
CHECKED: DATE: 8/21/2015
S.LEE

APPROVED
SECTION MANAGER
DEPUTY DIVISION MANAGER
DIVISION MANAGER

SCALE:
AS SHOWN
SHEET OF SHEETS
OF

MASONIC AVENUE
STREETSCAPE IMPROVEMENTS

MASONIC AVENUE AND GOLDEN GATE AVENUE
TRAFFIC SIGNAL WORK

CONTRACT NO.
2370J
DRAWING NO.
ET-4.0
FILE NO.
101,272
REV. NO.
1