


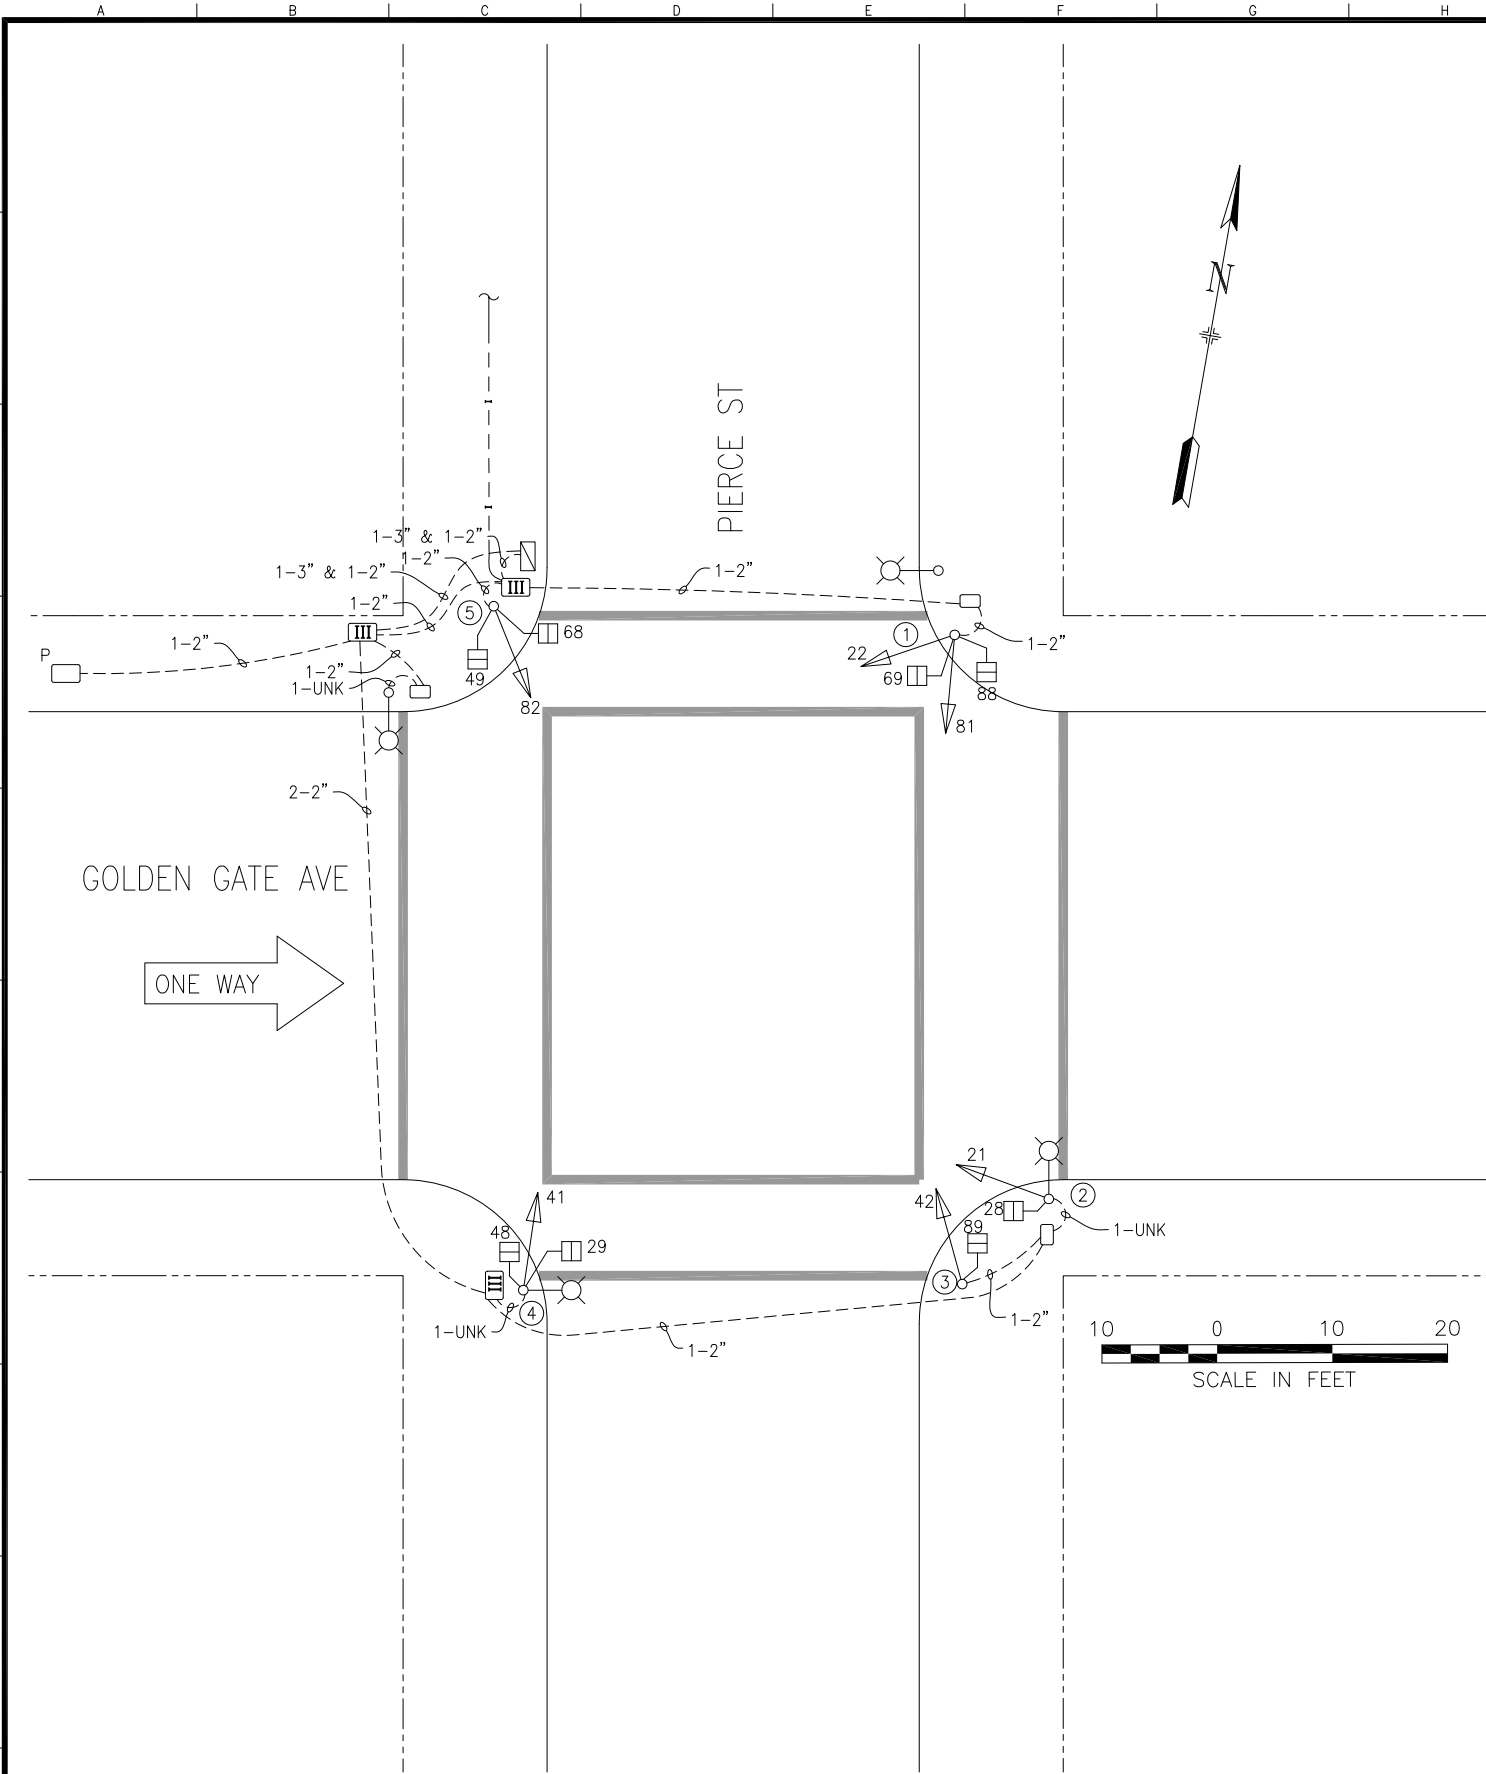

POLE AND EQUIPMENT SCHEDULE										
POLE No.	TYPE OF POLE	VEHICLE SIGNAL					PEDESTRIAN SIGNAL			REMARKS
		No.	TYPE	MOUNTING	VISORS	LOUVERS	No.	TYPE	MOUNTING	
①	EX MARBLELITE (10')	22 81	3S12" 3S12"	TV-2-T-SFA	T T		69 88	1S-COUNT 1S-COUNT	SP-1-SF (12") SP-1 (22")	
②	EX MARBLELITE SL	21	3S12"	SV-1-T	T		28	1S-COUNT	SP-1	
③	EX 1-A (10')	42	3S12"	TV-1-T	T		89	1S-COUNT	SP-1	
④	EX MARBLELITE SL	41	3S12"	SV-1-T	T		29 48	1S-COUNT 1S-COUNT	SP-1-SF (12") SP-1 (22")	
⑤	EX 1-A (10')	82	3S12"	TV-1-T	T		49 68	1S-COUNT 1S-COUNT	SP-1 (22") SP-1-SF (12")	

TABLE OF REVISIONS			
NO.	DATE	DESCRIPTION	BY APP.
1	8/31/17	SRC 2017-217, UPGRADE ALL LENSES TO 12"	CS2 BW
0	12/9/08	MOD ACTIVATED BY 0895J; CONVERTED FROM AS-BUILTS	JH GD

REFERENCE INFORMATION & FILE NO. OF SURVEYS	



SAN FRANCISCO MUNICIPAL TRANSPORTATION AGENCY
CITY AND COUNTY OF SAN FRANCISCO

DRAWN:	DATE:
JH	11/17
CHECKED:	DATE:
GD	11/17

SCALE:
AS SHOWN
SHEET OF SHEETS
01 OF 01

TRAFFIC SIGNAL INVENTORY DIAGRAM
GOLDEN GATE AVE & PIERCE ST

CNN NO.
26062000
REV NO.
1