


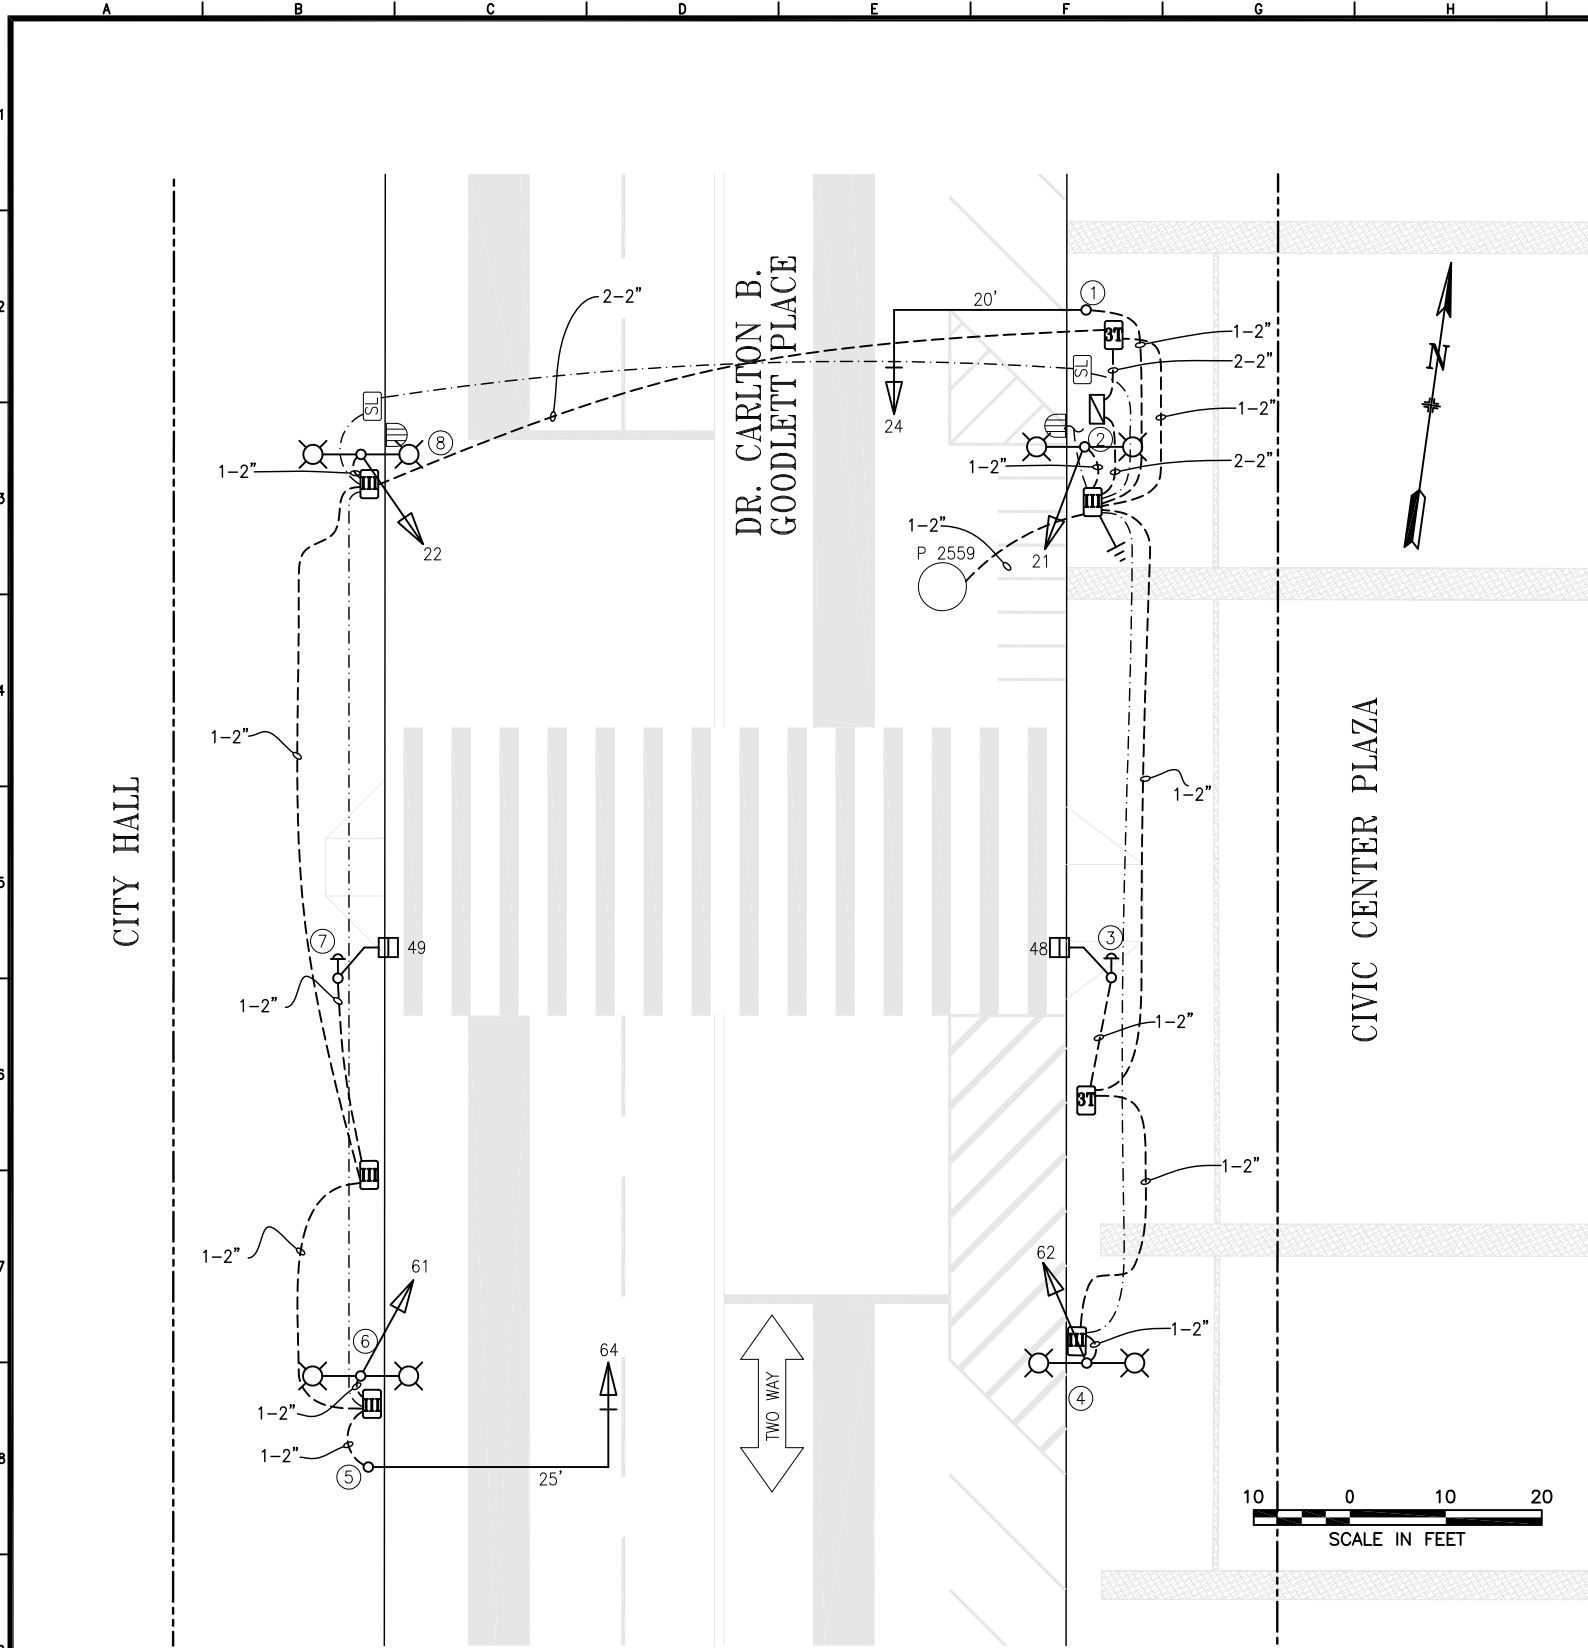

POLE AND EQUIPMENT SCHEDULE											
POLE No.	TYPE OF POLE	LUMINAIRE VOLTAGE/WATTAGE	VEHICLE SIGNAL					PEDESTRIAN SIGNAL			REMARKS
			No.	TYPE	MOUNTING	VISORS	LOUVERS	No.	TYPE	MOUNTING	
①	16-2-100 W/ 20' MAST ARM		24	3S12"	MAS	T					BACKPLATE
②	ORNAMENTAL STREET LIGHT		21	3S12"	SV-1	T					
③	1-A (7')							48	1S-COUNT	TP-1	APS
④	ORNAMENTAL STREET LIGHT		62	3S12"	SV-1-T	T					
⑤	18-2-100 W/ 25' MAST ARM		64	3S12"	MAS	T					BACKPLATE
⑥	ORNAMENTAL STREET LIGHT		61	3S12"	SV-1-T	T					
⑦	1-A (7')							49	1S-COUNT	TP-1	APS
⑧	ORNAMENTAL STREET LIGHT		22	3S12"	SV-1-T	T					

NO.		DATE	DESCRIPTION	BY	APP.
TABLE OF REVISIONS					
CHECK WITH TRACING TO SEE IF YOU HAVE LATEST REVISION					
2	6/2/20		SIGNAL 21 ADDED PER SRC 2020-093	JH	GD
1	8/13/15		SIGNAL 61 ADDED PER SRC 2015-183	JH	MV
0	4/9/15		ACTIVATED BY CHANGE ORDER TO 2246J: CONVERTED FROM CONTRACT PLANS	JH	MV

REFERENCE INFORMATION & FILE NO. OF SURVEYS	



SAN FRANCISCO MUNICIPAL TRANSPORTATION AGENCY

CITY AND COUNTY OF SAN FRANCISCO

DRAWN: JH CHECKED: MV	DATE: 8/2015 DATE: 8/2015	SCALE: AS SHOWN	TRAFFIC SIGNAL INVENTORY DIAGRAM	CNN NO. 10549000
		SHEET OF SHEETS 1 OF 1	GOODLETT PL MIDBLOCK CROSSWALK	REV NO. 2