




POLE AND EQUIPMENT SCHEDULE												
POLE No.	TYPE OF POLE	VEHICLE SIGNAL					PEDESTRIAN SIGNAL				ITS DEVICE	REMARKS
		No.	TYPE	MOUNTING	VISORS	LOUVERS/BP	No.	TYPE	MOUNTING	BUTTON		
①	17-3-129	85 21 24	3S12" 3S12" 3S12"GVA	SV-1-T SV-1-T MAS	FULL T CAP	BP	28 89	1S-COUNT 1S-COUNT	SP-2-T		APS (2W)	SIGNAL #21 MOUNTED AT 15'
②	17-3-129	86 44	3S12" 3S12"	SV-1-T MAS	T T	BP	29	1S-COUNT	SP-1		APS (2W)	
③	1-A (10')	41 25	3S12" 3S12"	TV-2-T	T T	BP BP	48	1S-COUNT	SP-1		APS (2W)	
④	17-3-129	64 61	3S12" 3S12"	MAS SV-1-T	T T	BP BP	68	1S-COUNT	SP-1-T		APS (2W) VIDEO DETECTION 4 TSP EQUIPMENT PREEMPTION	
⑤	1-A (10')	45	3S8"	TV-1-T	T	BP	49	1S-COUNT	SP-1-T		APS (2W)	
⑥	1-A (10')	63 83	3S12" 3S8"	TV-2-T	T T	BP BP						
⑦	17-3-129	81 84	3S12" PV3S12"VA	SV-1-TA MAS	T T	BP					APS (2W) VIDEO DETECTION 4	
⑧	1-A (10')	65	3S12"	TV-1-T	T	BP	88 69	1S-COUNT 1S-COUNT	SP-2-T		APS (2W)	

0	3/20/24	CONVERTED FROM PREVIOUS SID AND PER FIELD	J. ANNINOS	D. VALLE-SCHWENK	
NO.	DATE	DESCRIPTION	BY	APPROVED	
TABLE OF REVISIONS					
CHECKOUT DRAWING THROUGH THE SID CUSTODIAN FOR THE LATEST REVISION					

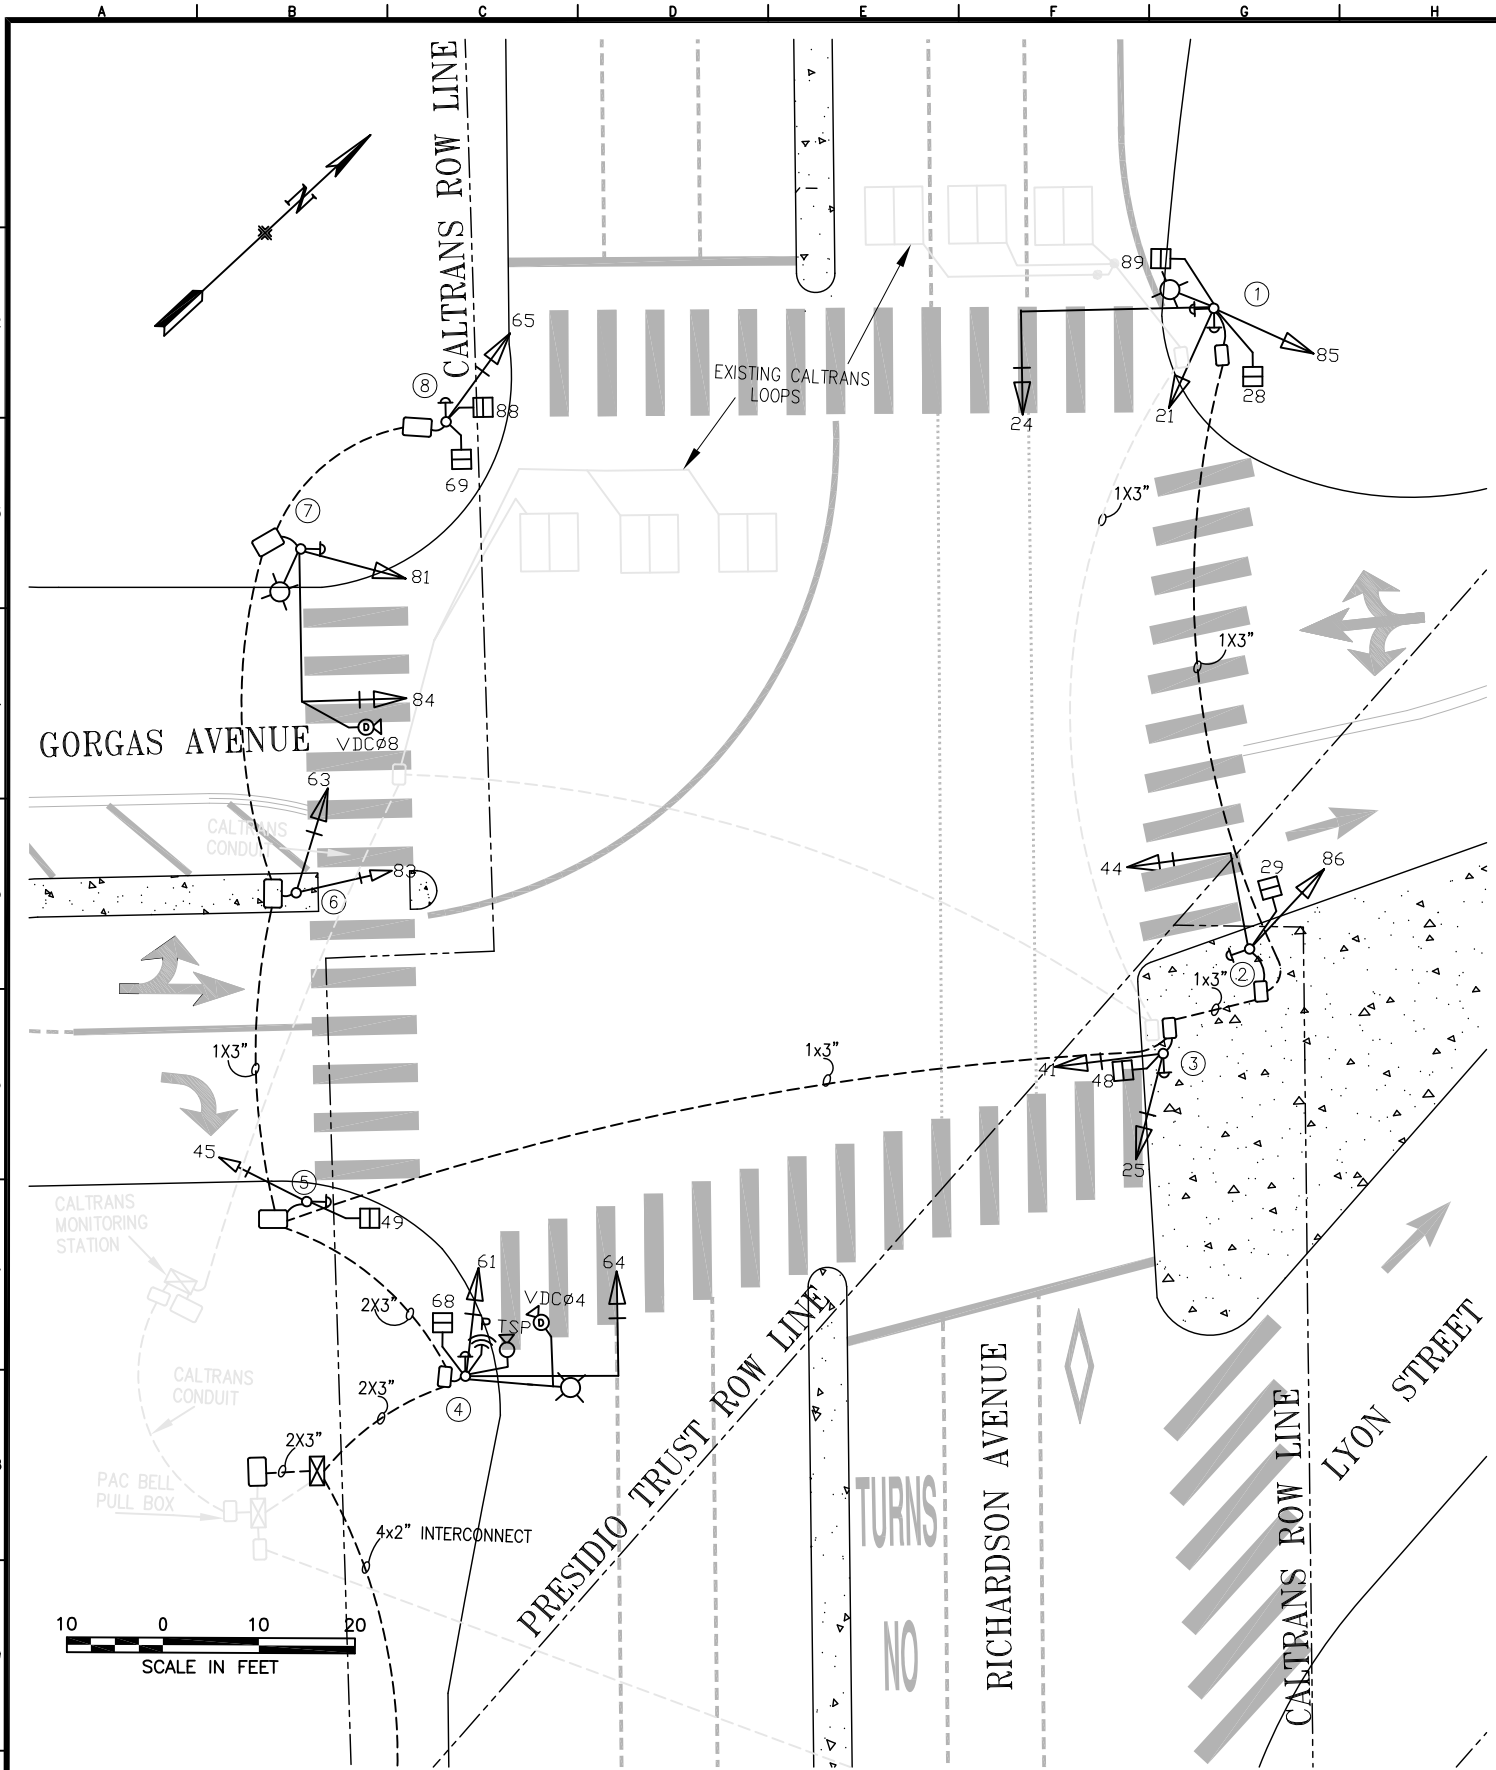

DRAWN BY: J. ANNINOS	DATE: 3/20/2024
CHECKED BY: D. VALLE-SCHWENK	DATE: 3/20/2024

SCALE AS SHOWN
SHEET OF SHEETS 01 of 01

TRAFFIC SIGNAL INVENTORY DIAGRAM
GORGAS AVENUE, LYON STREET, & RICHARDSON AVENUE

CNN NO: 27025000
REV NO: 0