


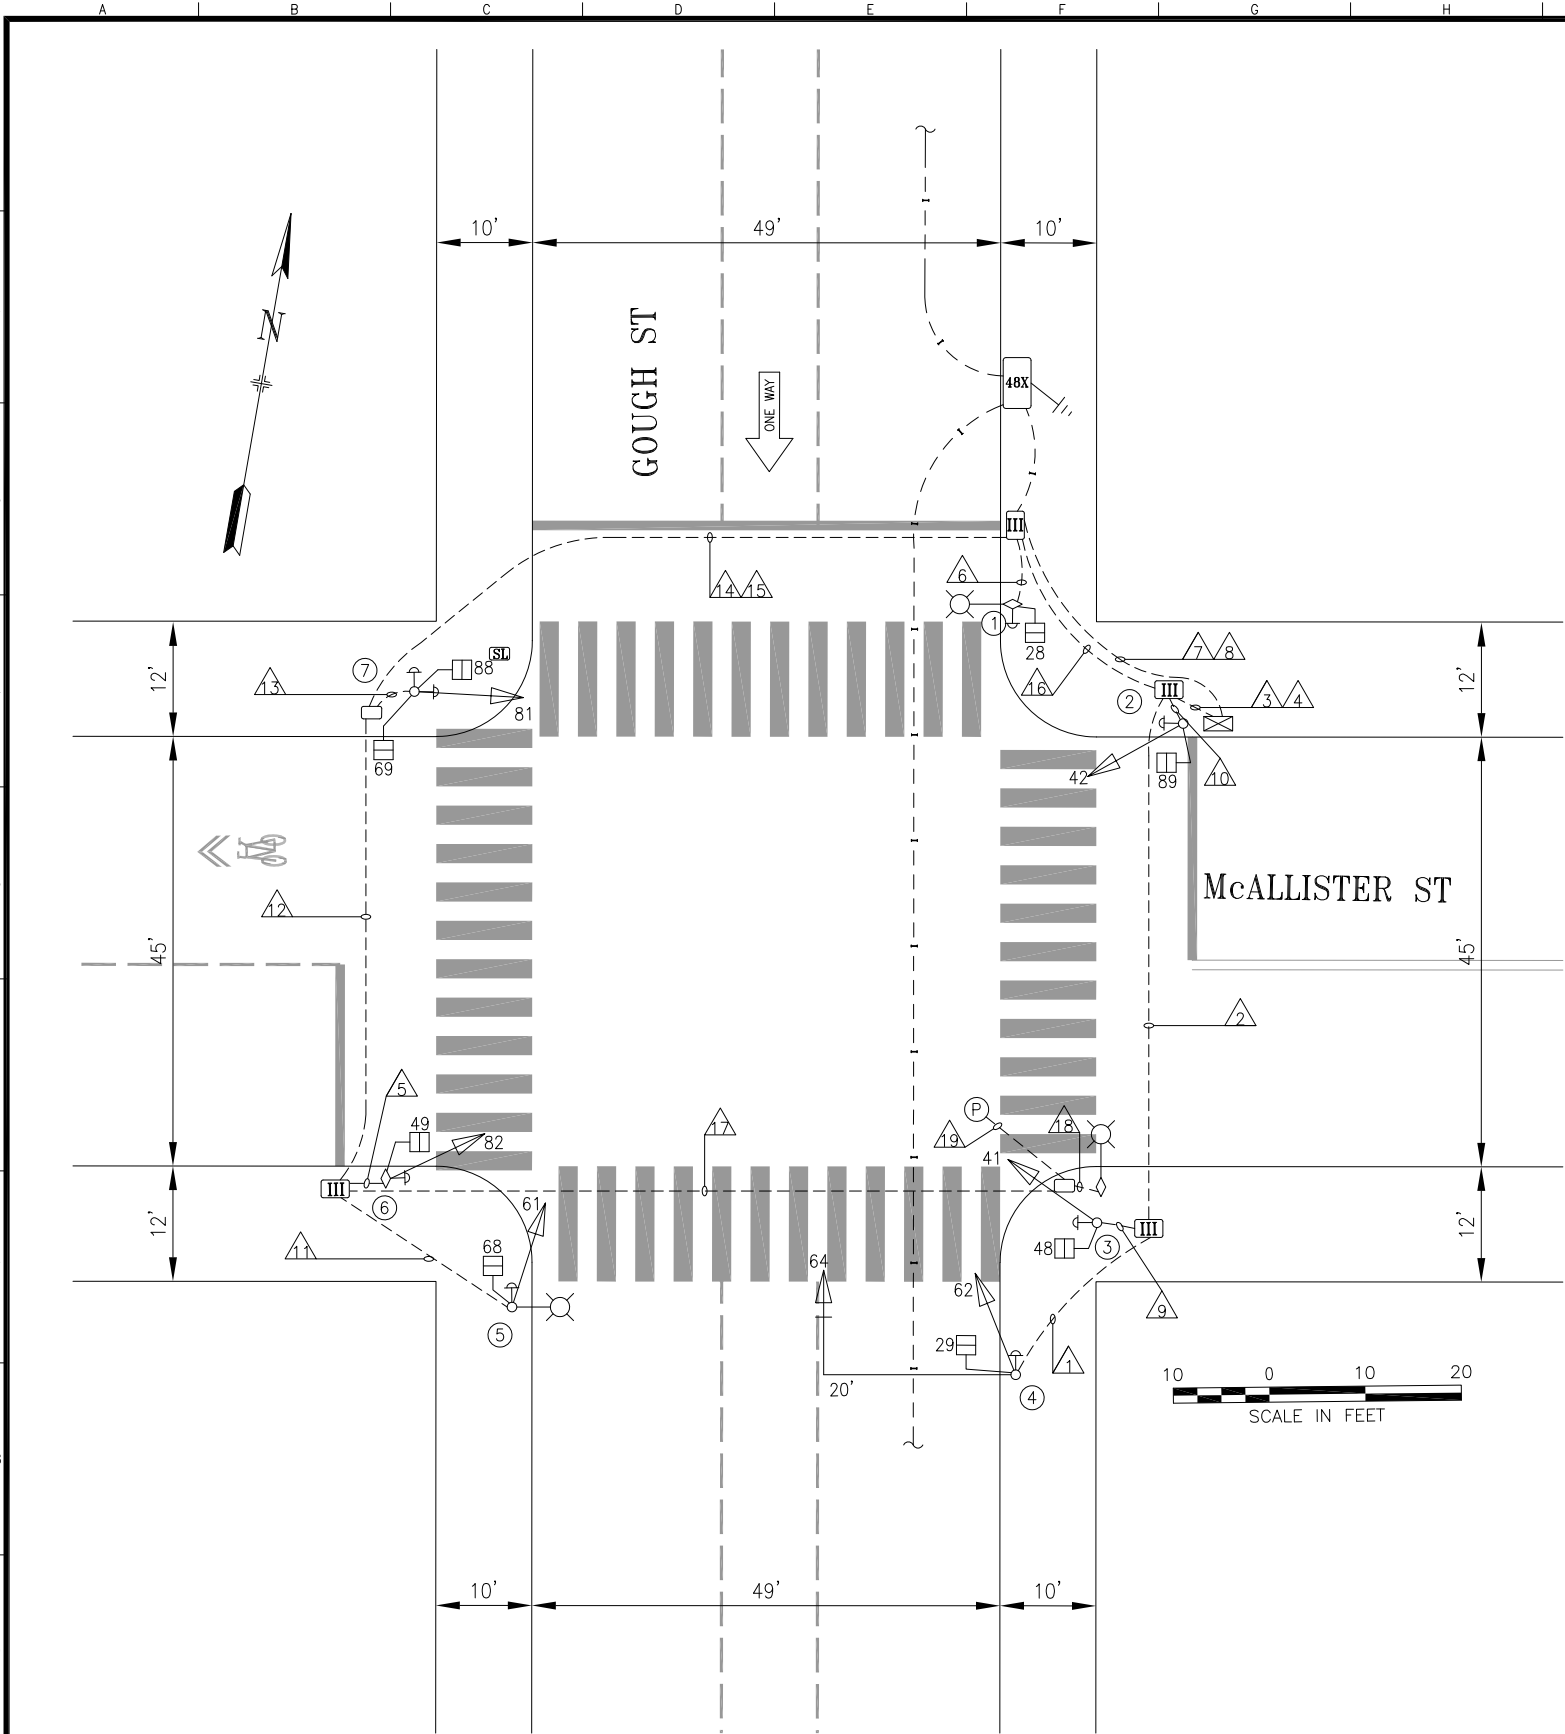

POLE AND EQUIPMENT SCHEDULE											
POLE No.	TYPE OF POLE	LUMINARE VOLTAGE/WATTAGE	VEHICLE SIGNAL					PEDESTRIAN SIGNAL			REMARKS
			No.	TYPE	MOUNTING	VISORS	LOUVERS/BP	No.	TYPE	MOUNTING	
①	MUNI POLE W/ LUMINARE ARM	LED						28	1S-COUNT	SP-1 (18")	EXTERNAL CONDUIT APS-3W
②	1-A (10')		42	3S12"	TV-1-T	T		89	1S-COUNT	SP-1 (22")	APS-3W
③	1-A (10')		41	3S12"	TV-1-T	T		48	1S-COUNT	SP-1	APS-3W
④	16-2-100 W/ 20' MAST ARM		62 64	3S12" 3S12"	SV-1-T MAS	T T	BP	29	1S-COUNT	SP-1	APS-3W
⑤	STREET LIGHT	LED	61	3S12"	SV-1-T	T		68	1S-COUNT	SP-1	APS-3W
⑥	MUNI POLE		82	3S12"	SV-1-T	T		49	1S-COUNT	SP-1-T	EXTERNAL CONDUIT W/ "1" CONDULET POINTING EAST APS-3W
⑦	1-A (10')		81	3S12"	TV-1-T	T		69 88	1S-COUNT 1S-COUNT	SP-2-T	SPECIAL PED SGNL MOUNTING APS-3W x 2

NO.	DATE	DESCRIPTION	BY	APP.
TABLE OF REVISIONS				
CHECK WITH TRACING TO SEE IF YOU HAVE LATEST REVISION				
2	04/07/21	PER SRC 2020-063, INSTALL APS	C SKERRIT	G DELEON
1	05/20/20	SIGNAL UPGRADE BY 3003J, UPDATE PCS #28 MOUNTING PER AS-BUILTS	C SKERRIT	G DELEON
0	09/12/19	SIGNAL UPGRADE BY 3003J, CONVERTED FROM CONTRACT PLAN AND CT-32 AS-BUILTS	C SKERRIT	G DELEON

REFERENCE INFORMATION & FILE NO. OF SURVEYS
--



SAN FRANCISCO MUNICIPAL TRANSPORTATION AGENCY

CITY AND COUNTY OF SAN FRANCISCO

DRAWN:	DATE:
C SKERRIT	12/2019
CHECKED:	DATE:
G DELEON	12/2019

--

SCALE:
AS SHOWN
SHEET OF SHEETS
1 OF 2

TRAFFIC SIGNAL INVENTORY DIAGRAM
GOUGH STREET AND McALLISTER STREET

CNN NO.
25941000
REV NO.
2

[illegible]

1 BELDEN CABLE 8489 (OR EQUIVALENT) WIRING PULLED FROM APS PPB TO PED SIGNAL

[illegible]