


COUGH, MCCOPPIN, DTIS

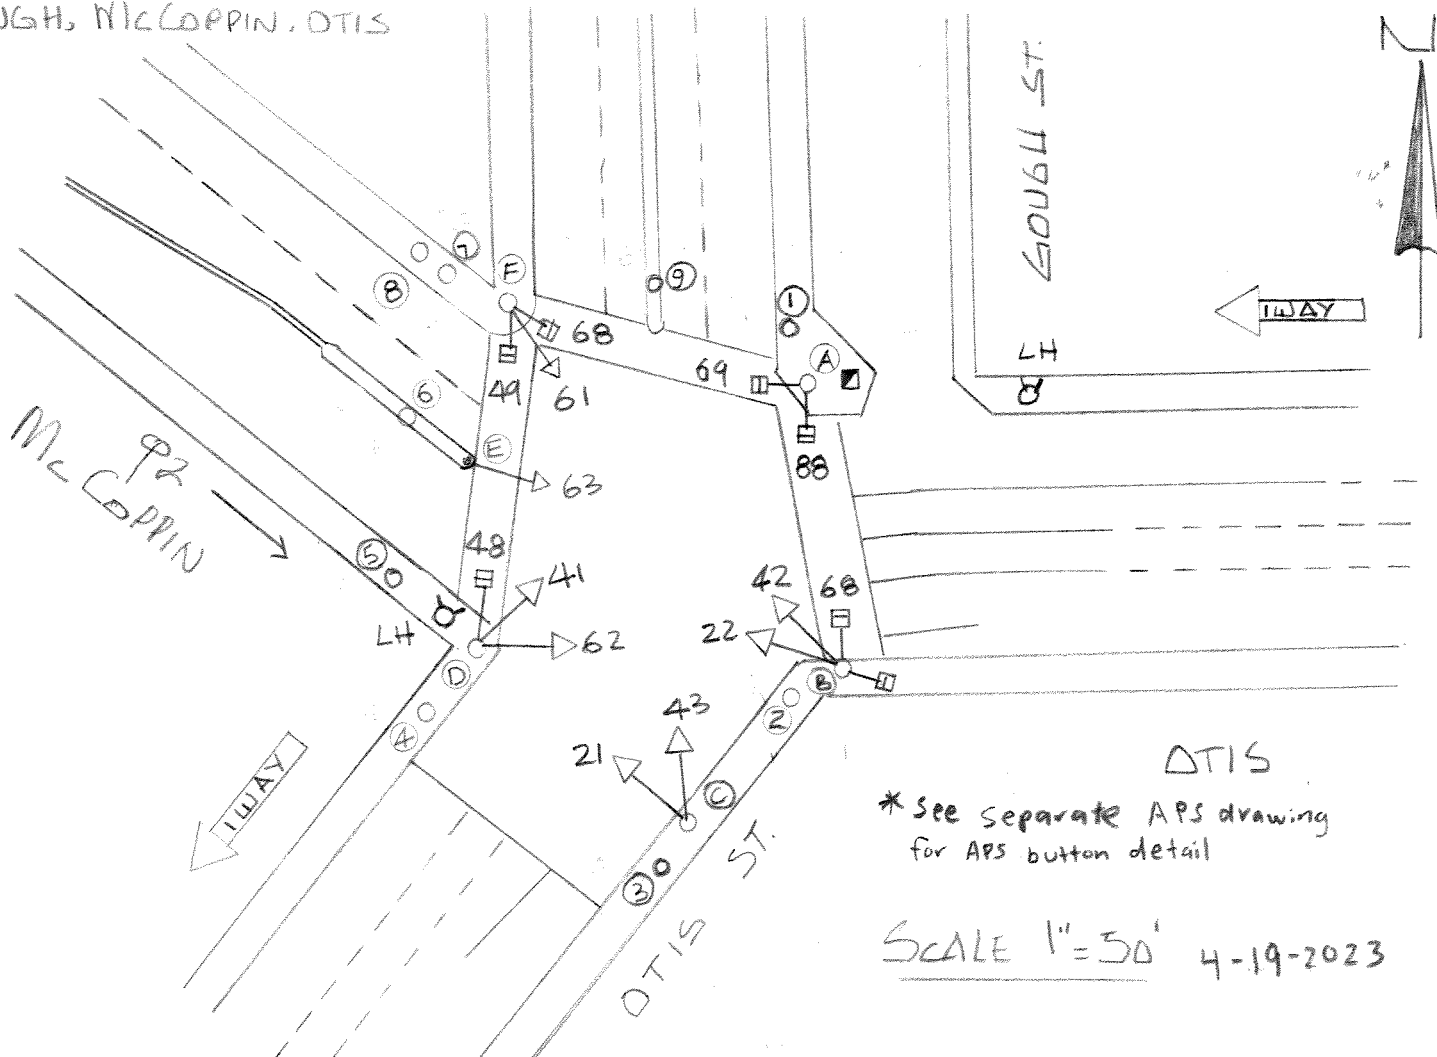

POLE	FUNC.	MAT'L	SIGNAL NO.	MAKE	NO. OF SECT.	SIZE	VISOR	B.P. OR LOUVERS	MOUN'T	PED SIGNAL NO.	LEGEND	MESSAGE		MAKE	MOUN
A	M	S	21	3M	1	12" (PV)	FC 12"	-	S	48	I	IS-1	OR/W	ICC	S
B	M	S	22	TCT	1	12"	FC 12"	-	S	49	I	IS-1	OR/W	ICC	S
C	M	S	41	TCT	3	12"	FC 12"	-	T	68	I	IS-1	OR/W	ICC	S
D	S	S	42	TCT	3	12"	FC 12"	-	S	69	I	IS-1	OR/W	ICC	S
E	S	S	43	3M	3	12" (PV)	FC 12"	-	S	88	I	IS-1	OR/W	ICC	S
F	S	S	61	TCT	3	8"	FC 8"	-	T	89	I	IS-1	OR/W	ICC	S
			62	TCT	3	12"	FC 12"	-	T						
			63	TCT	3	12"	FC 12"	-	T						
1	M	S													
2	M	S													
3	M	S													
4	M	S													
5	M	S													
6	L	S													
7	M	S													
8	M	S													
9	L	S													

CONTROLLER CABINET SIZE : ORD BASE CABINET: YES

COMMENTS :

Install new APS per SRC 2022-199

- D. Yeung 4-19-2023