


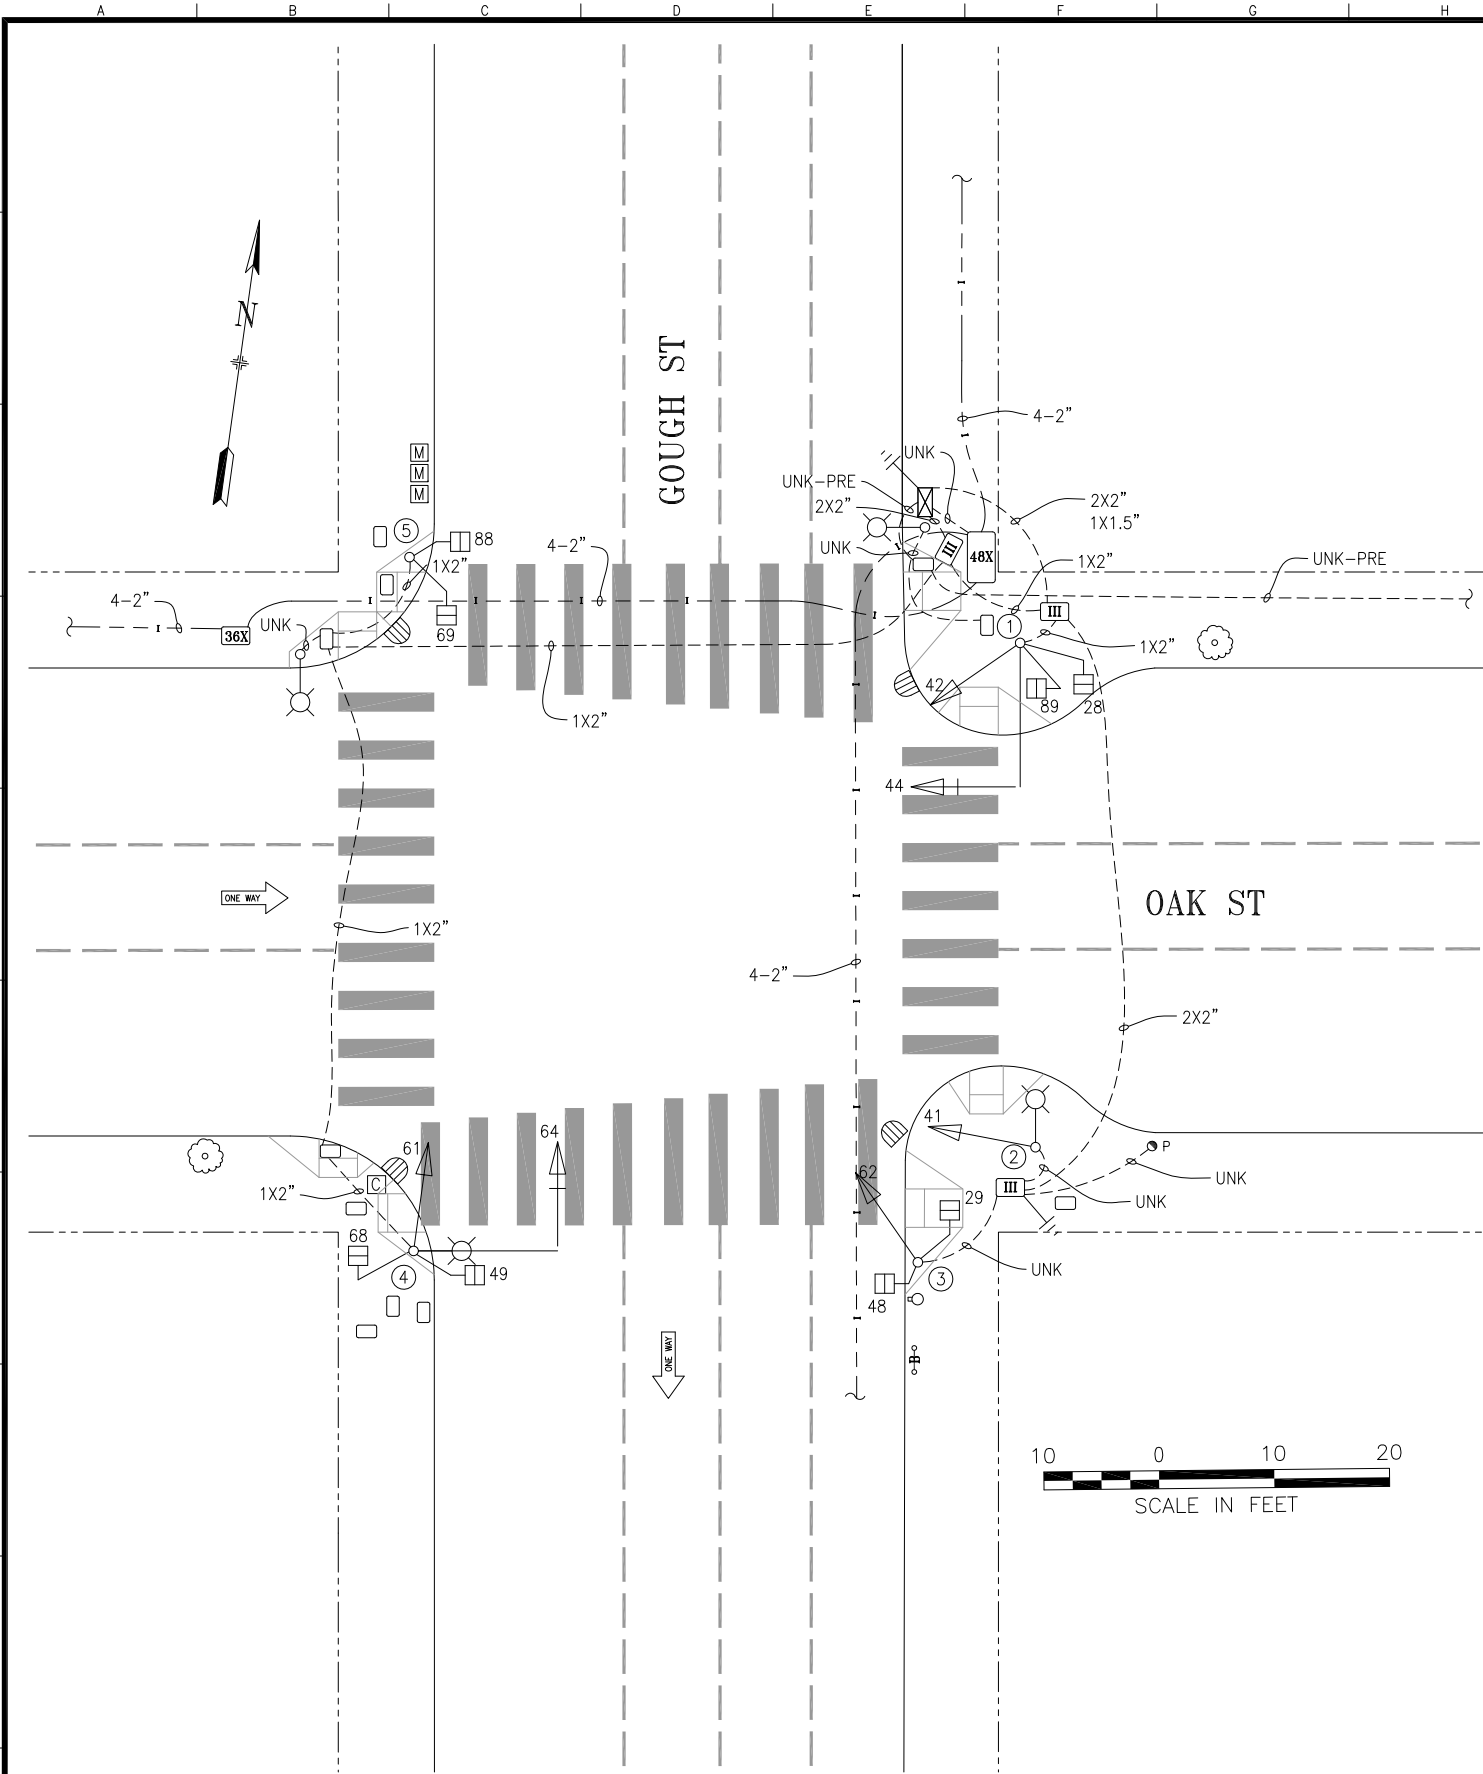

POLE AND EQUIPMENT SCHEDULE											
POLE No.	TYPE OF POLE	LUMINAIRE VOLTAGE/ WATTAGE	VEHICLE SIGNAL					PEDESTRIAN SIGNAL			REMARKS
			No.	TYPE	MOUNTING	VISORS	LOUVERS	No.	TYPE	MOUNTING	
①	16-1-70 W/ 15' MAST ARM		42	3S12"	SV-1-T	T		28	1S-COUNT	SP-1	BACKPLATE FOR SIGNAL 44
			44	3S12"	MAS	T		89	1S-COUNT	SP-1	
②	MARBELITE SL		41	3S12"	SV-1-T	T					
③	MARBELITE (10')		62	3S12"	TV-1-T	T		29 48	1S-COUNT 1S-COUNT	SP-1 SP-1	
④	17-1-70 W/ 15' MAST ARM & 6' LUMINAIRE ARM		61	3S12"	SV-1-T	T		49	1S-COUNT	SP-1	BACKPLATE FOR SIGNAL 64
			64	3S12"	MAS	T		68	1S-COUNT	SP-1	
⑤	1-A (7')							69 88	1S-COUNT 1S-COUNT	TP-2-T	

1	12/02/15	UPGRADED SIGNALS 42, 61, & 62 TO 12" PER SRC 2015-384	AS	MV	
0	12/13/01	UPGRADE ACTIVATED THRU 1660N; CONVERTED FROM AS-BUILTS	AS	MV	
NO.	DATE	DESCRIPTION	BY	APP.	
TABLE OF REVISIONS					
CHECK WITH TRACING TO SEE IF YOU HAVE LATEST REVISION					

REFERENCE INFORMATION & FILE NO. OF SURVEYS



SAN FRANCISCO MUNICIPAL TRANSPORTATION AGENCY

CITY AND COUNTY OF SAN FRANCISCO

DRAWN:	DATE:
AScales	10/2015
CHECKED:	DATE:
MVelasco	10/2015

SCALE:
AS SHOWN
SHEET OF SHEETS
1 OF 1

TRAFFIC SIGNAL INVENTORY DIAGRAM
GOUGH STREET AND OAK STREET

CNN NO.
25906000
REV NO.
1