


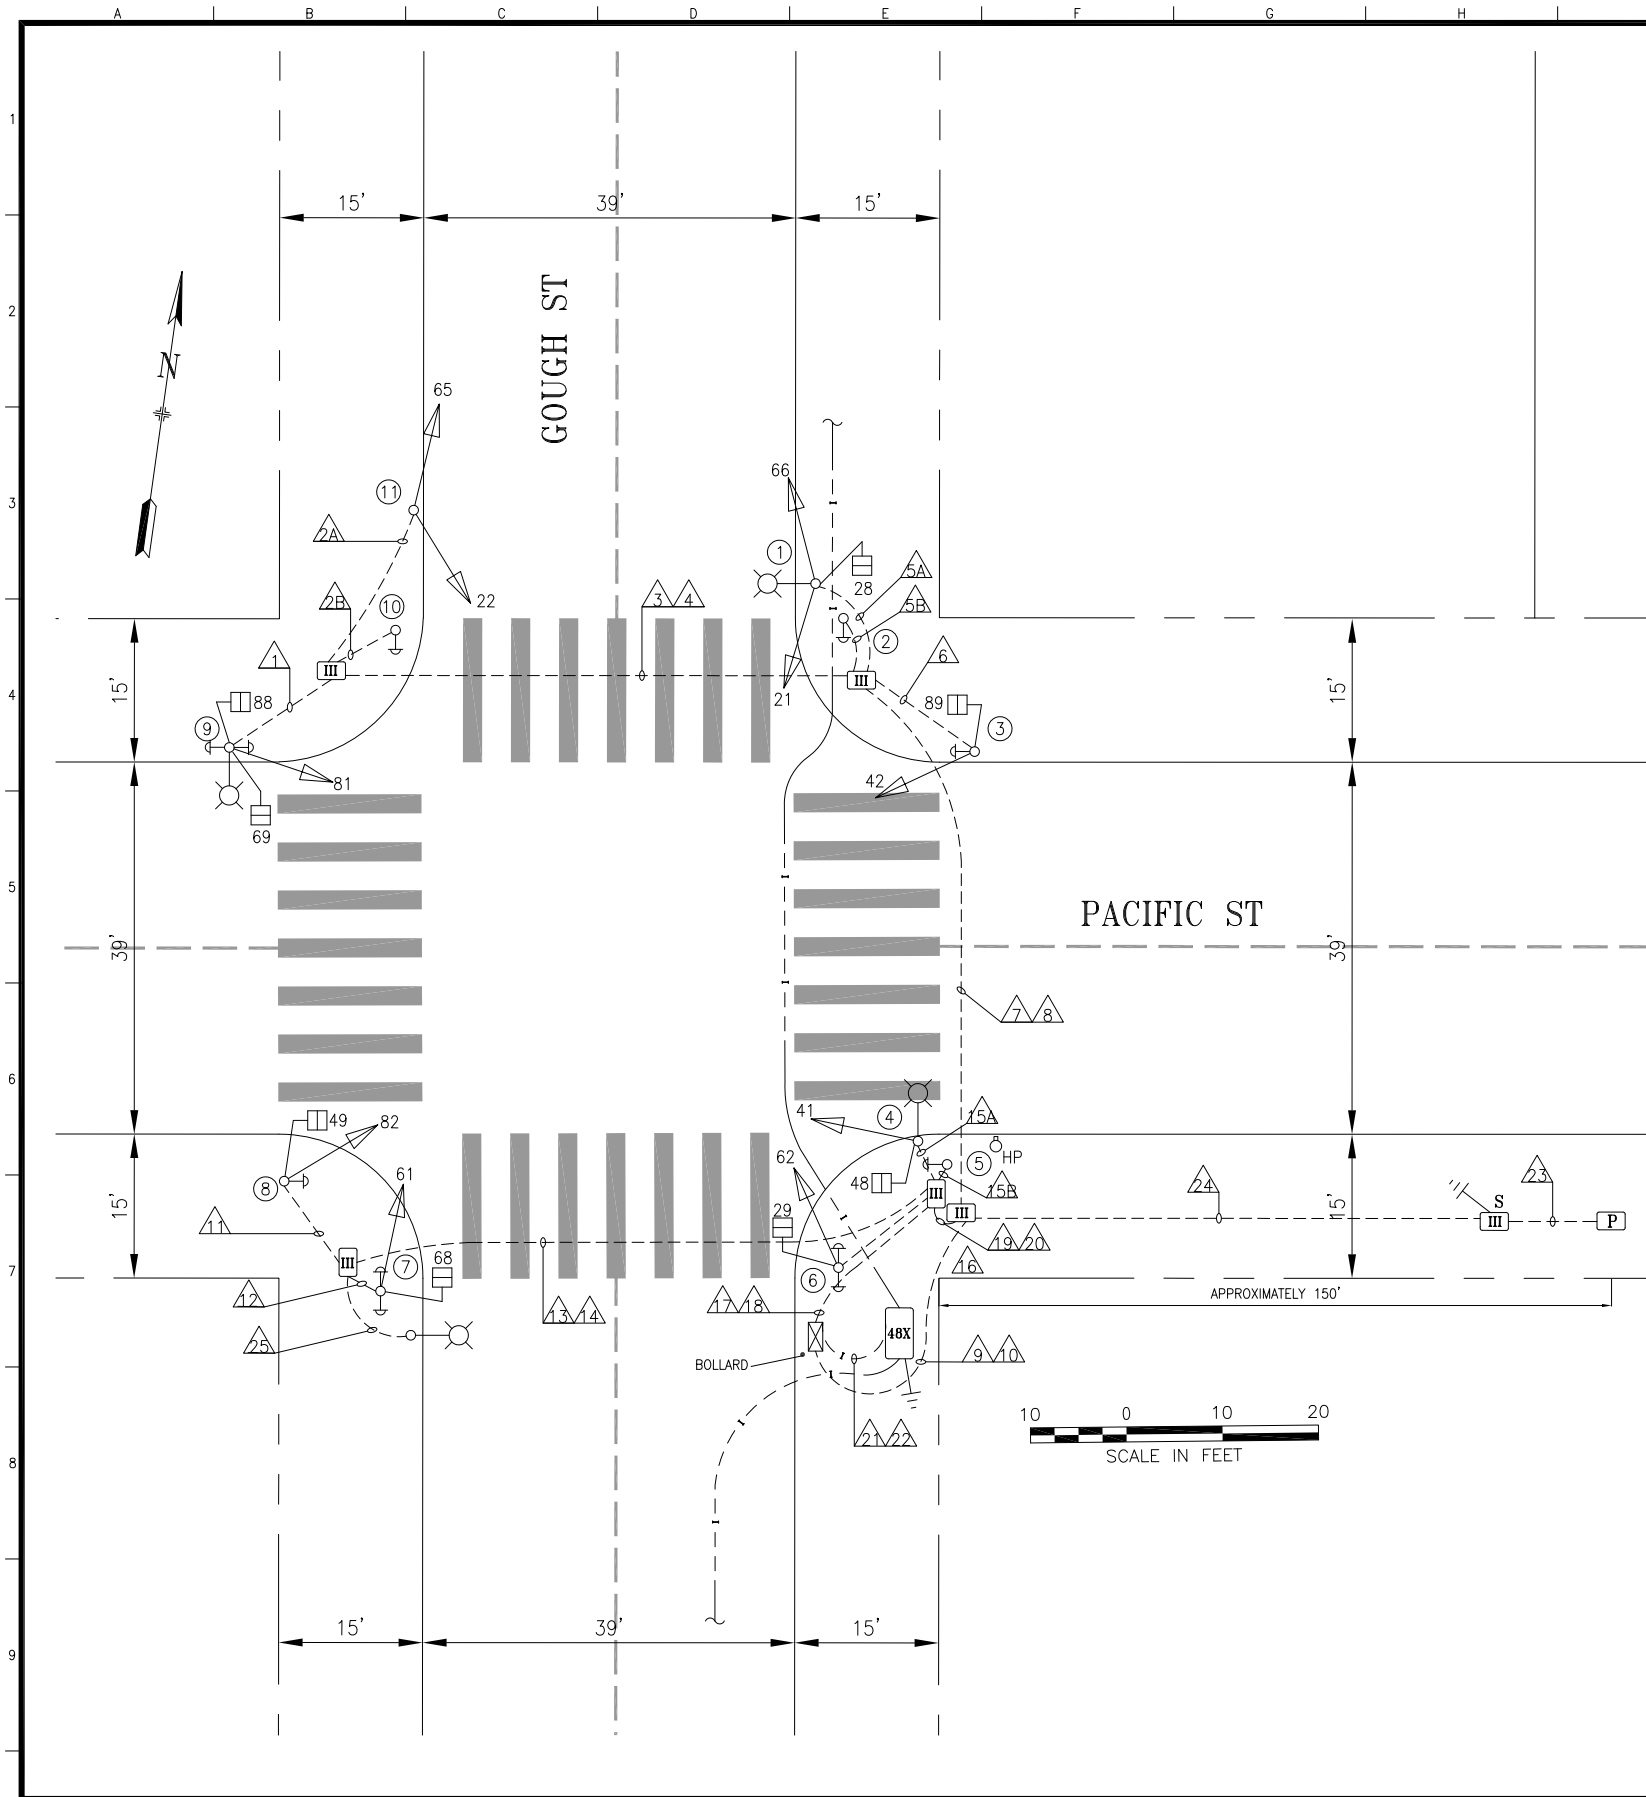

POLE AND EQUIPMENT SCHEDULE											
POLE No.	TYPE OF POLE	LUMINARE VOLTAGE/WATTAGE	VEHICLE SIGNAL					PEDESTRIAN SIGNAL			REMARKS
			No.	TYPE	MOUNTING	VISORS	LOUVERS/BP	No.	TYPE	MOUNTING	
①	MARBELITE STREET LIGHT	LED	21 66	3S12" 3S12"	SV-1-T SV-1	T T		28	1S-COUNT	SP-1	SIGNAL 21 MOUNTED AT 11'
②	PPB POLE										APS-2W
③	1-A (10')		42	3S12"	TV-1-T	T		89	1S-COUNT	SP-1	APS-2W
④	MARBELITE STREET LIGHT	LED	41	3S12"	SV-1-T	T		48	1S-COUNT	SP-1	
⑤	PPB POLE										APS-2W
⑥	1-A (10')		62	3S12"	TV-1-T	T		29	1S-COUNT	SP-1	APS-2W x 2
⑦	1-A (13')		61	3S12"	TV-1-T	T		68	1S-COUNT	SP-1	APS-2W x 2
⑧	1-A (10')		82	3S12"	TV-1-T	T		49	1S-COUNT	SP-1	APS-2W
⑨	MARBELITE STREET LIGHT	LED	81	3S12"	SV-1-T	T		69 88	1S-COUNT 1S-COUNT	SP-1-SF (12") SP-1 (22")	APS-2W x 2
⑩	PPB POLE										APS-2W
⑪	1-A (10')		22 65	3S12" 3S12"	TV-2-T	T T					

1	08/10/20	INSTALL APS-2W PER SRC 2020-062 AND VIA 3003J UPGRADE	C SKERRIT	C DELEON
0	07/18/19	SIGNAL UPGRADE BY 3003J, CONVERTED FROM CONTRACT PLAN	C SKERRIT	C DELEON
NO.	DATE	DESCRIPTION	BY	APP.
TABLE OF REVISIONS CHECK WITH TRACING TO SEE IF YOU HAVE LATEST REVISION				

REFERENCE INFORMATION & FILE NO. OF SURVEYS
--



SAN FRANCISCO MUNICIPAL TRANSPORTATION AGENCY
CITY AND COUNTY OF SAN FRANCISCO

DRAWN:	DATE:
C SKERRIT	12/2019
CHECKED:	DATE:
G DELEON	12/2019

SCALE:
AS SHOWN
SHEET OF SHEETS
1 OF 2

TRAFFIC SIGNAL INVENTORY DIAGRAM
GOUGH STREET AND PACIFIC AVENUE

CNN NO.
26567000
REV NO.
1

