


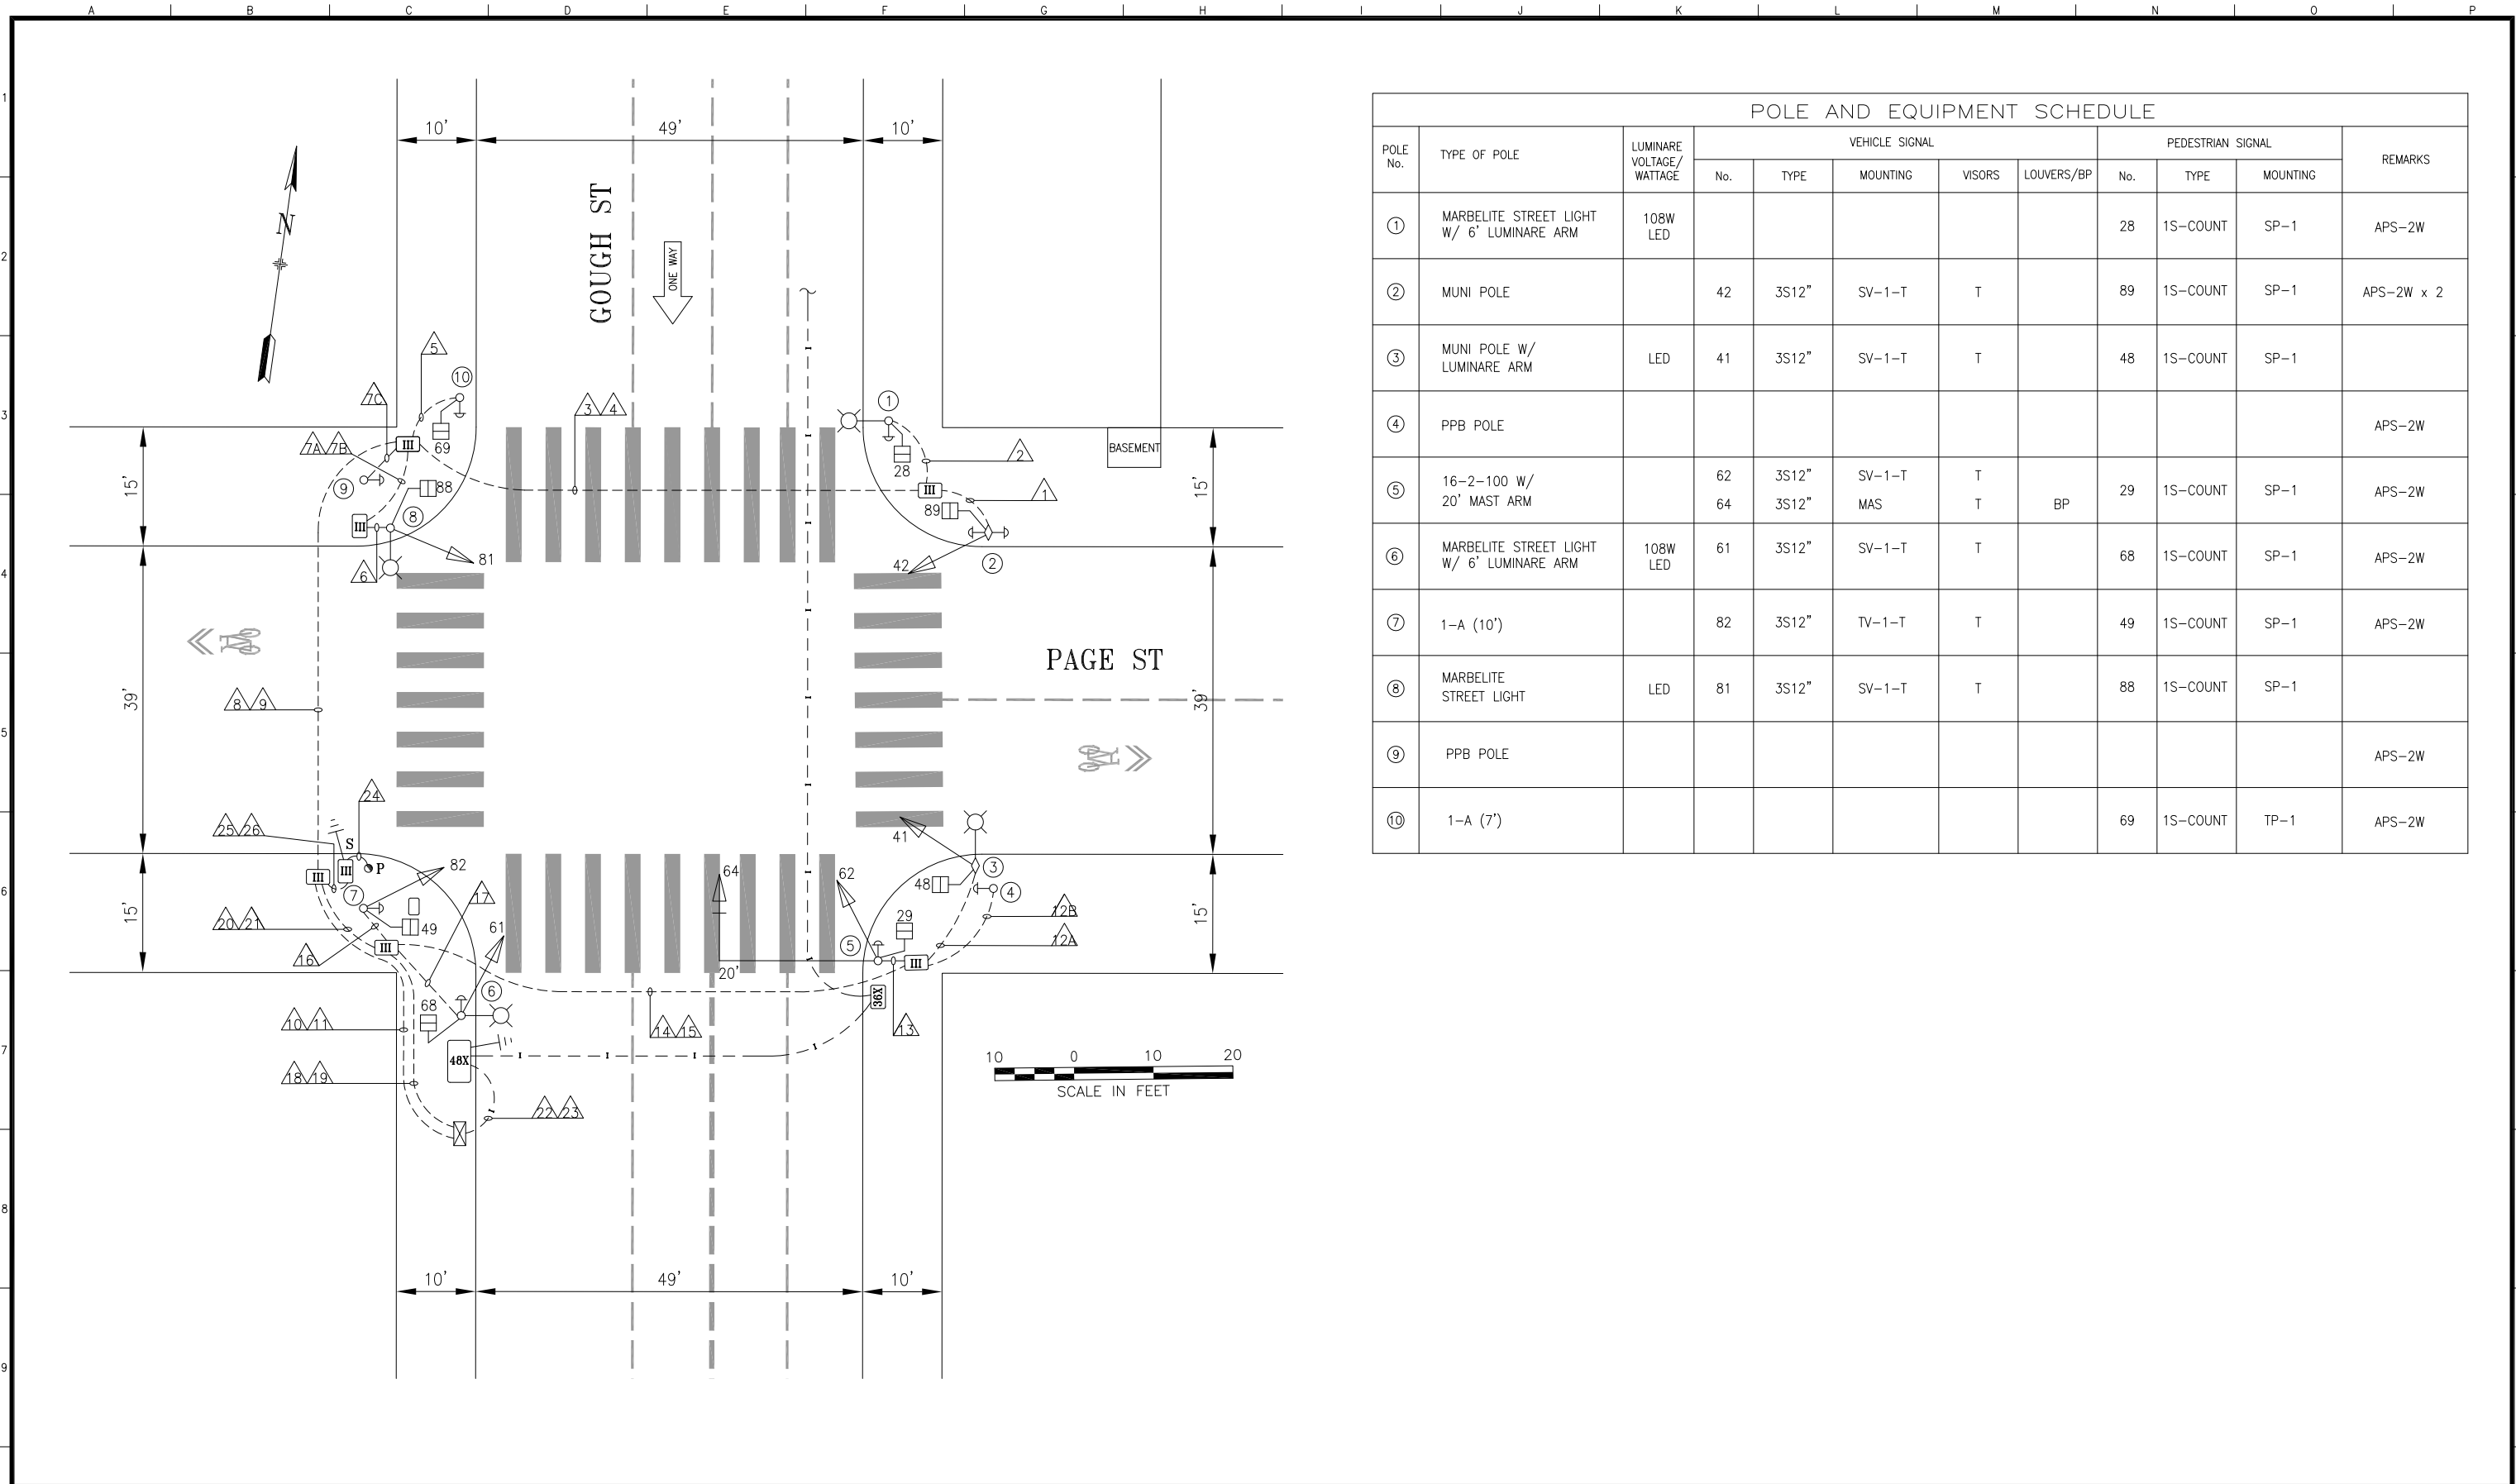

POLE AND EQUIPMENT SCHEDULE											
POLE No.	TYPE OF POLE	LUMINARE VOLTAGE/ WATTAGE	VEHICLE SIGNAL					PEDESTRIAN SIGNAL			REMARKS
			No.	TYPE	MOUNTING	VISORS	LOUVERS/BP	No.	TYPE	MOUNTING	
①	MARBELITE STREET LIGHT W/ 6' LUMINARE ARM	108W LED						28	1S-COUNT	SP-1	APS-2W
②	MUNI POLE		42	3S12"	SV-1-T	T		89	1S-COUNT	SP-1	APS-2W x 2
③	MUNI POLE W/ LUMINARE ARM	LED	41	3S12"	SV-1-T	T		48	1S-COUNT	SP-1	
④	PPB POLE										APS-2W
⑤	16-2-100 W/ 20' MAST ARM		62 64	3S12" 3S12"	SV-1-T MAS	T T	BP	29	1S-COUNT	SP-1	APS-2W
⑥	MARBELITE STREET LIGHT W/ 6' LUMINARE ARM	108W LED	61	3S12"	SV-1-T	T		68	1S-COUNT	SP-1	APS-2W
⑦	1-A (10')		82	3S12"	TV-1-T	T		49	1S-COUNT	SP-1	APS-2W
⑧	MARBELITE STREET LIGHT	LED	81	3S12"	SV-1-T	T		88	1S-COUNT	SP-1	
⑨	PPB POLE										APS-2W
⑩	1-A (7')							69	1S-COUNT	TP-1	APS-2W

1	10/26/20	INSTALL APS-2W PER SRC 2020-062 AND VIA 3003J UPGRADE	C SKERRIT	G DELEON	
0	09/18/19	SIGNAL UPGRADE BY 3003J, CONVERTED FROM CONTRACT PLAN	C SKERRIT	G DELEON	
NO.	DATE	DESCRIPTION	BY	APP.	
TABLE OF REVISIONS					
CHECK WITH TRACING TO SEE IF YOU HAVE LATEST REVISION					

REFERENCE INFORMATION & FILE NO. OF SURVEYS



SAN FRANCISCO MUNICIPAL TRANSPORTATION AGENCY
CITY AND COUNTY OF SAN FRANCISCO

DRAWN:	DATE:
C SKERRIT	12/2019
CHECKED:	DATE:
G DELEON	12/2019

SCALE:
AS SHOWN
SHEET OF SHEETS
1 OF 2

TRAFFIC SIGNAL INVENTORY DIAGRAM
GOUGH STREET AND PAGE STREET

CNN NO.
24456000
REV NO.
1

