


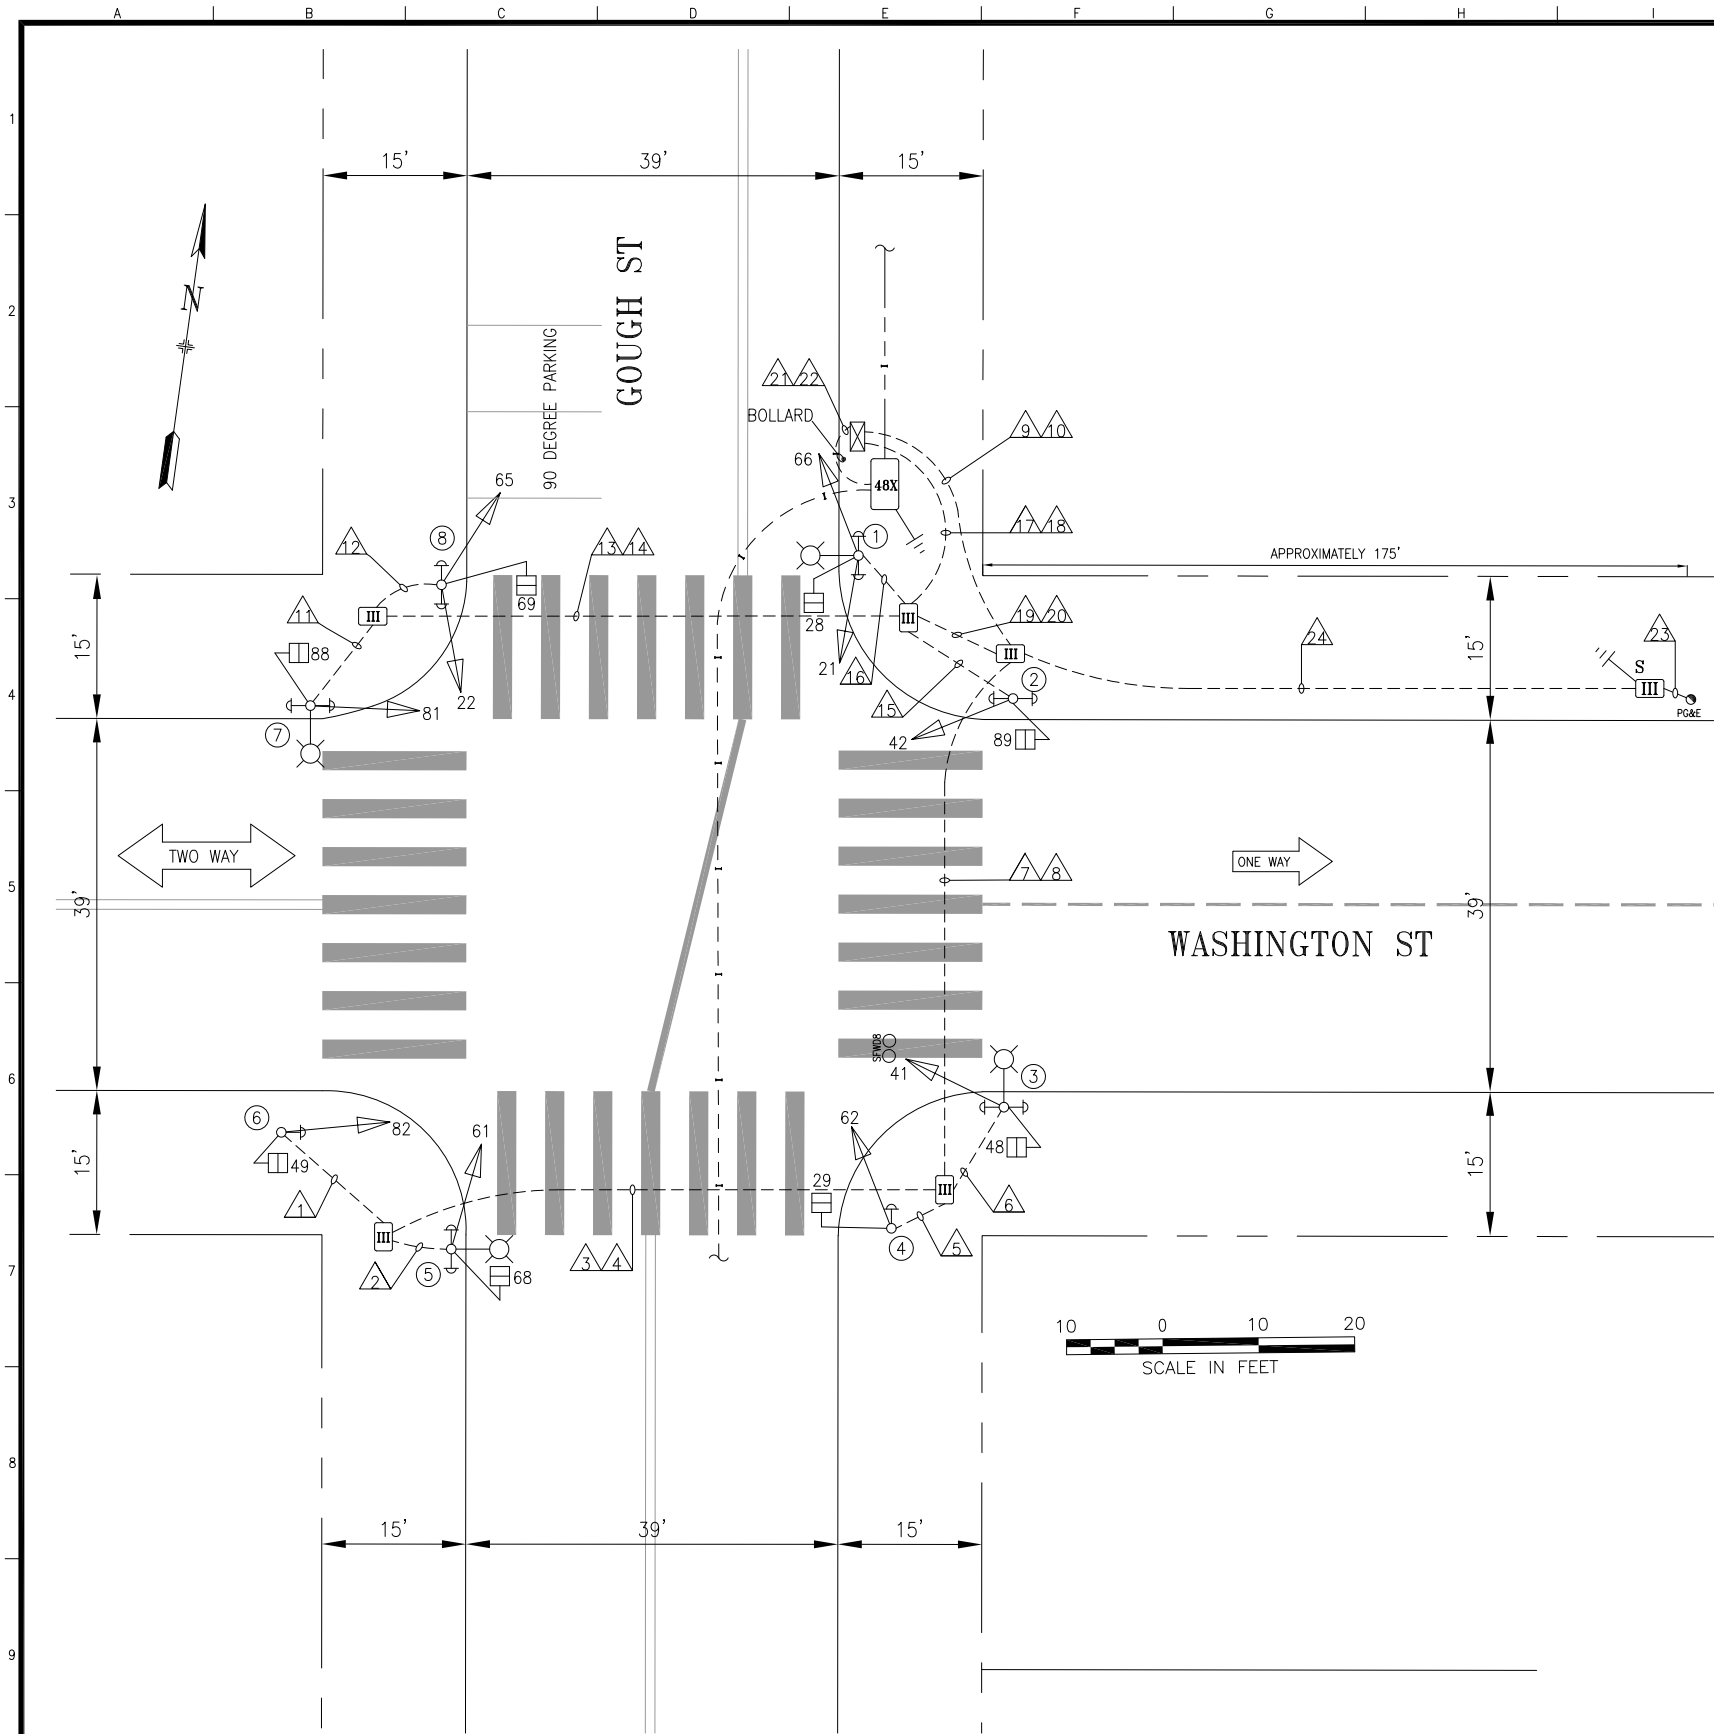


POLE AND EQUIPMENT SCHEDULE											
POLE No.	TYPE OF POLE	LUMINAIRE VOLTAGE/WATTAGE	VEHICLE SIGNAL					PEDESTRIAN SIGNAL			REMARKS
			No.	TYPE	MOUNTING	VISORS	LOUVERS/BP	No.	TYPE	MOUNTING	
①	MARBELITE STREET LIGHT	LED	21 66	3S12" 3S12"	SV-2-TA	T T		28	1S-COUNT	SP-1	APS-2W x 2
②	1-A (10')		42	3S12"	TV-1-T	T		89	1S-COUNT	SP-1	APS-2W x 2
③	MARBELITE STREET LIGHT	HPS 150W	41	3S12"	SV-1-T	T		48	1S-COUNT	SP-1	APS-2W x 2
④	1-A (10')		62	3S12"	TV-1-T	T		29	1S-COUNT	SP-1	APS-2W
⑤	MARBELITE STREET LIGHT	LED	61	3S12"	SV-1-T	T		68	1S-COUNT	SP-1	APS-2W x 2
⑥	1-A (10')		82	3S12"	TV-1-T	T		49	1S-COUNT	SP-1	APS-2W
⑦	MARBELITE STREET LIGHT	LED	81	3S12"	SV-1-T	T		88	1S-COUNT	SP-1	APS-2W x 2
⑧	1-A (15')		22 65	3S12" 3S12"	SV-2-TA	T T		69	1S-COUNT	SP-1	APS-2W x 2

TABLE OF REVISIONS			
NO.	DATE	DESCRIPTION	BY APP.
1	09/30/20	INSTALL APS-2W PER SRC 2020-062 AND VIA 3003J	C SKERRIT G DELEON
0	06/26/19	SIGNAL UPGRADE BY 3003J, CONVERTED FROM CONTRACT PLAN	C SKERRIT G DELEON

CHECK WITH TRACING TO SEE IF YOU HAVE LATEST REVISION

REFERENCE INFORMATION & FILE NO. OF SURVEYS	

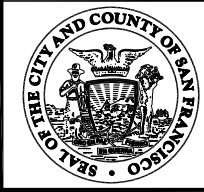

SAN FRANCISCO MUNICIPAL TRANSPORTATION AGENCY

CITY AND COUNTY OF SAN FRANCISCO

DRAWN:	DATE:
C SKERRIT	12/2019
CHECKED:	DATE:
G DELEON	12/2019

SCALE:
AS SHOWN
SHEET OF SHEETS
1 OF 2

TRAFFIC SIGNAL INVENTORY DIAGRAM
GOUGH STREET AND WASHINGTON STREET

CNN NO.
26545000
REV NO.
1

[illegible][illegible]