


# GRANT, MARKET & O'FARRELL

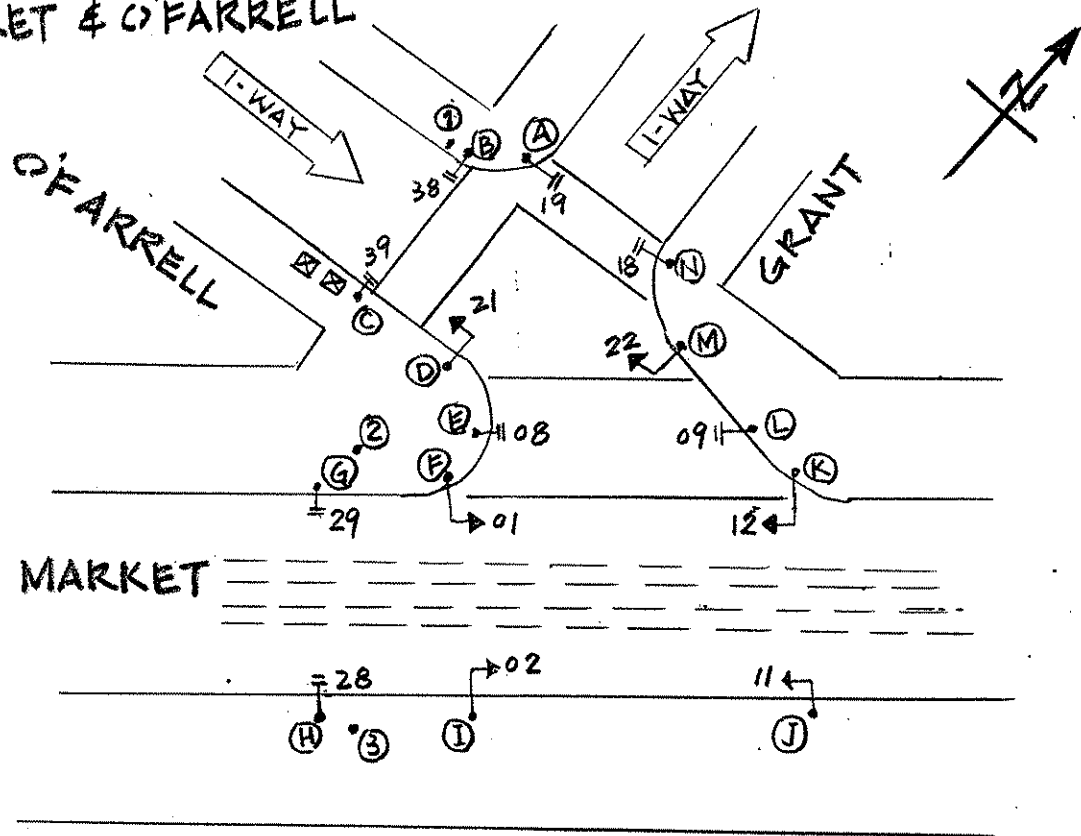

DATE 11-23-88

| ROLE | FUNC. | MAT'L | SIGNAL NO. | MAKE | NO. OF SECT. | SIZE | VISOR | B.P. OR LOUVERS | MOUN'T | PED SIGNAL NO. | LEGEND | MESSAGE |      | MAKE | MOU |
|------|-------|-------|------------|------|--------------|------|-------|-----------------|--------|----------------|--------|---------|------|------|-----|
| A    | S     | S     | 21         | —    | 3            | 8"   | FC8"  | BP              | *      | 38             | I      | IS-I    | W/OR | ICC  | T   |
| B    | S     | S     | 01         | —    | 3            | 8"   | FC8"  | BP              | *      | 39             | I      | IS-I    | W/OR | ICC  | T   |
| C    | S     | S     | 02         | —    | 3            | 8"   | FC8"  | BP              | *      | 08             | I      | IS-I    | W/OR | ICC  | T   |
| D    | S     | S     | 11         | —    | 3            | 8"   | FC8"  | BP              | *      | 29             | I      | IS-I    | W/OR | ICC  | T   |
| E    | S     | S     | 12         | —    | 3            | 8"   | FC8"  | BP              | *      | 28             | I      | IS-I    | W/OR | ICC  | T   |
| F    | S     | S     | 22         | —    | 3            | 8"   | FC8"  | BP              | *      | 09             | I      | IS-I    | W/OR | ICC  | T   |
| G    | S     | S     |            |      |              |      |       |                 |        | 18             | I      | IS-I    | W/OR | ICC  | T   |
| H    | S     | S     |            |      |              |      |       |                 |        | 19             | I      | IS-I    | W/OR | ICC  | T   |
| I    | S     | S     |            |      |              |      |       |                 |        |                |        |         |      |      |     |
| J    | S     | S     |            |      |              |      |       |                 |        |                |        |         |      |      |     |
| K    | S     | S     |            |      |              |      |       |                 |        |                |        |         |      |      |     |
| L    | S     | S     |            |      |              |      |       |                 |        |                |        |         |      |      |     |
| M    | S     | S     |            |      |              |      |       |                 |        |                |        |         |      |      |     |
| N    | S     | S     |            |      |              |      |       |                 |        |                |        |         |      |      |     |

1 L O CONTROLLER CABINET SIZE : ORDINARY BASE CABINET : 1-YES  
 2 L O COMMENTS : \* MARKET STREET MASTARM SIGNALS  
 3 L O