



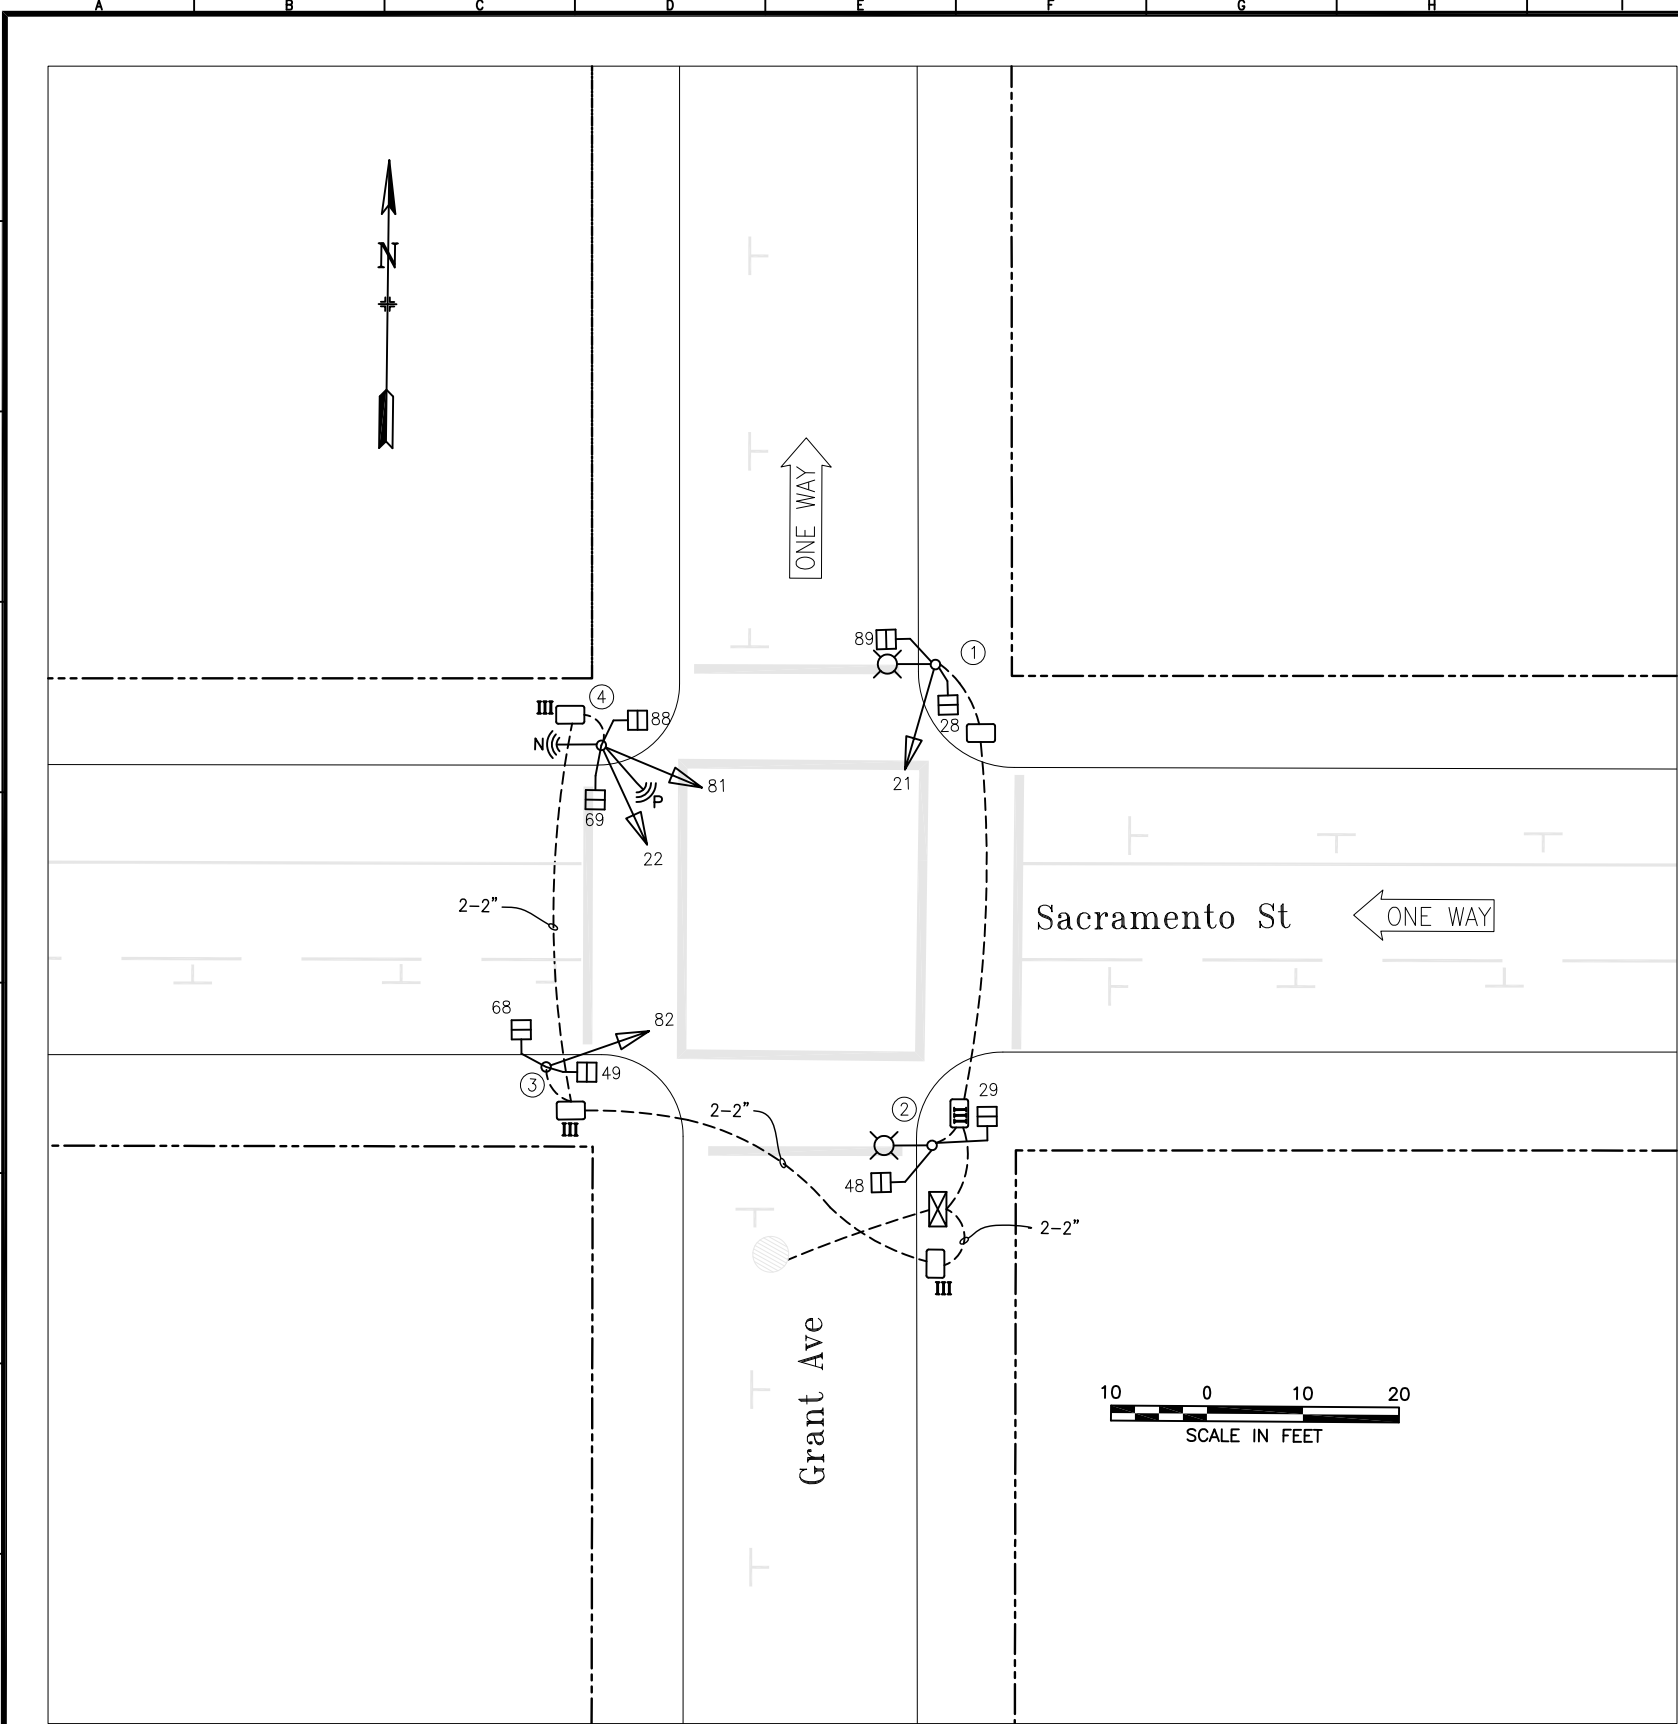

POLE AND EQUIPMENT SCHEDULE											
POLE No.	TYPE OF POLE	LUMINAIRE VOLTAGE/ WATTAGE	VEHICLE SIGNAL					PEDESTRIAN SIGNAL			REMARKS
			No.	TYPE	MOUNTING	VISORS	LOUVERS	No.	TYPE	MOUNTING	
①	SL (ORNAMENTAL)		21	3S12"	SV-1	T		28 89	1S-COUNT 1S-COUNT	SP-1 SP-1	
②	SL (ORNAMENTAL)							29 48	1S-COUNT 1S-COUNT	SP-2-T	
③	1-A (13')		82	3S12"	TV-1-T	T		68 49	1S-COUNT 1S-COUNT	SP-1-SF W/SP-1 (22")	
④	1-A (15')		81 22	3S12" 3S12"	TV-1-T SV-1-T	T T		88 69	1S-COUNT 1S-COUNT	SP-1-SF W/SP-1 (22")	PREEMPT RADIO NETWORK RADIO

1	2/17/22	ADD PED SIGNAL 28 PER SRC 2021-060	C. LEUNG	K. KWONG	
NO.	DATE	DESCRIPTION	BY	APPROVED	
TABLE OF REVISIONS					
CHECKOUT DRAWING THROUGH THE SID CUSTODIAN FOR THE LATEST REVISION					

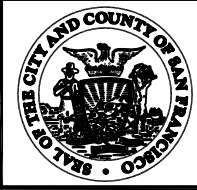

SFMTA

DRAWN BY: LILIANA VENTURA	DATE: 3/2021	SCALE AS SHOWN	TRAFFIC SIGNAL INVENTORY DIAGRAM	CNN NO: 24749000
CHECKED BY: MANITO VELASCO	DATE: 3/2021	SHEET OF SHEETS 1 OF 1	GRANT & SACRAMENTO	REV NO:

1