


GREAT HIGHWAY & LINCOLN WAY

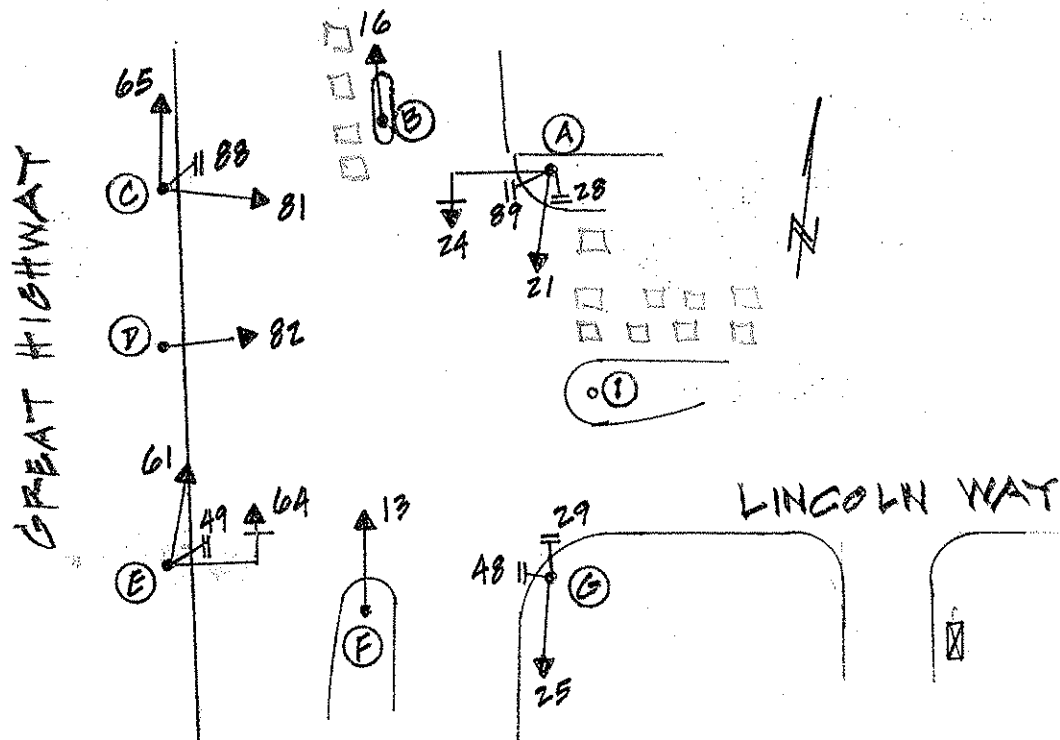

10/87

[illegible]

CONTROLLER CABINET SIZE : LARGE BASE CABINET : -

COMMENTS :