


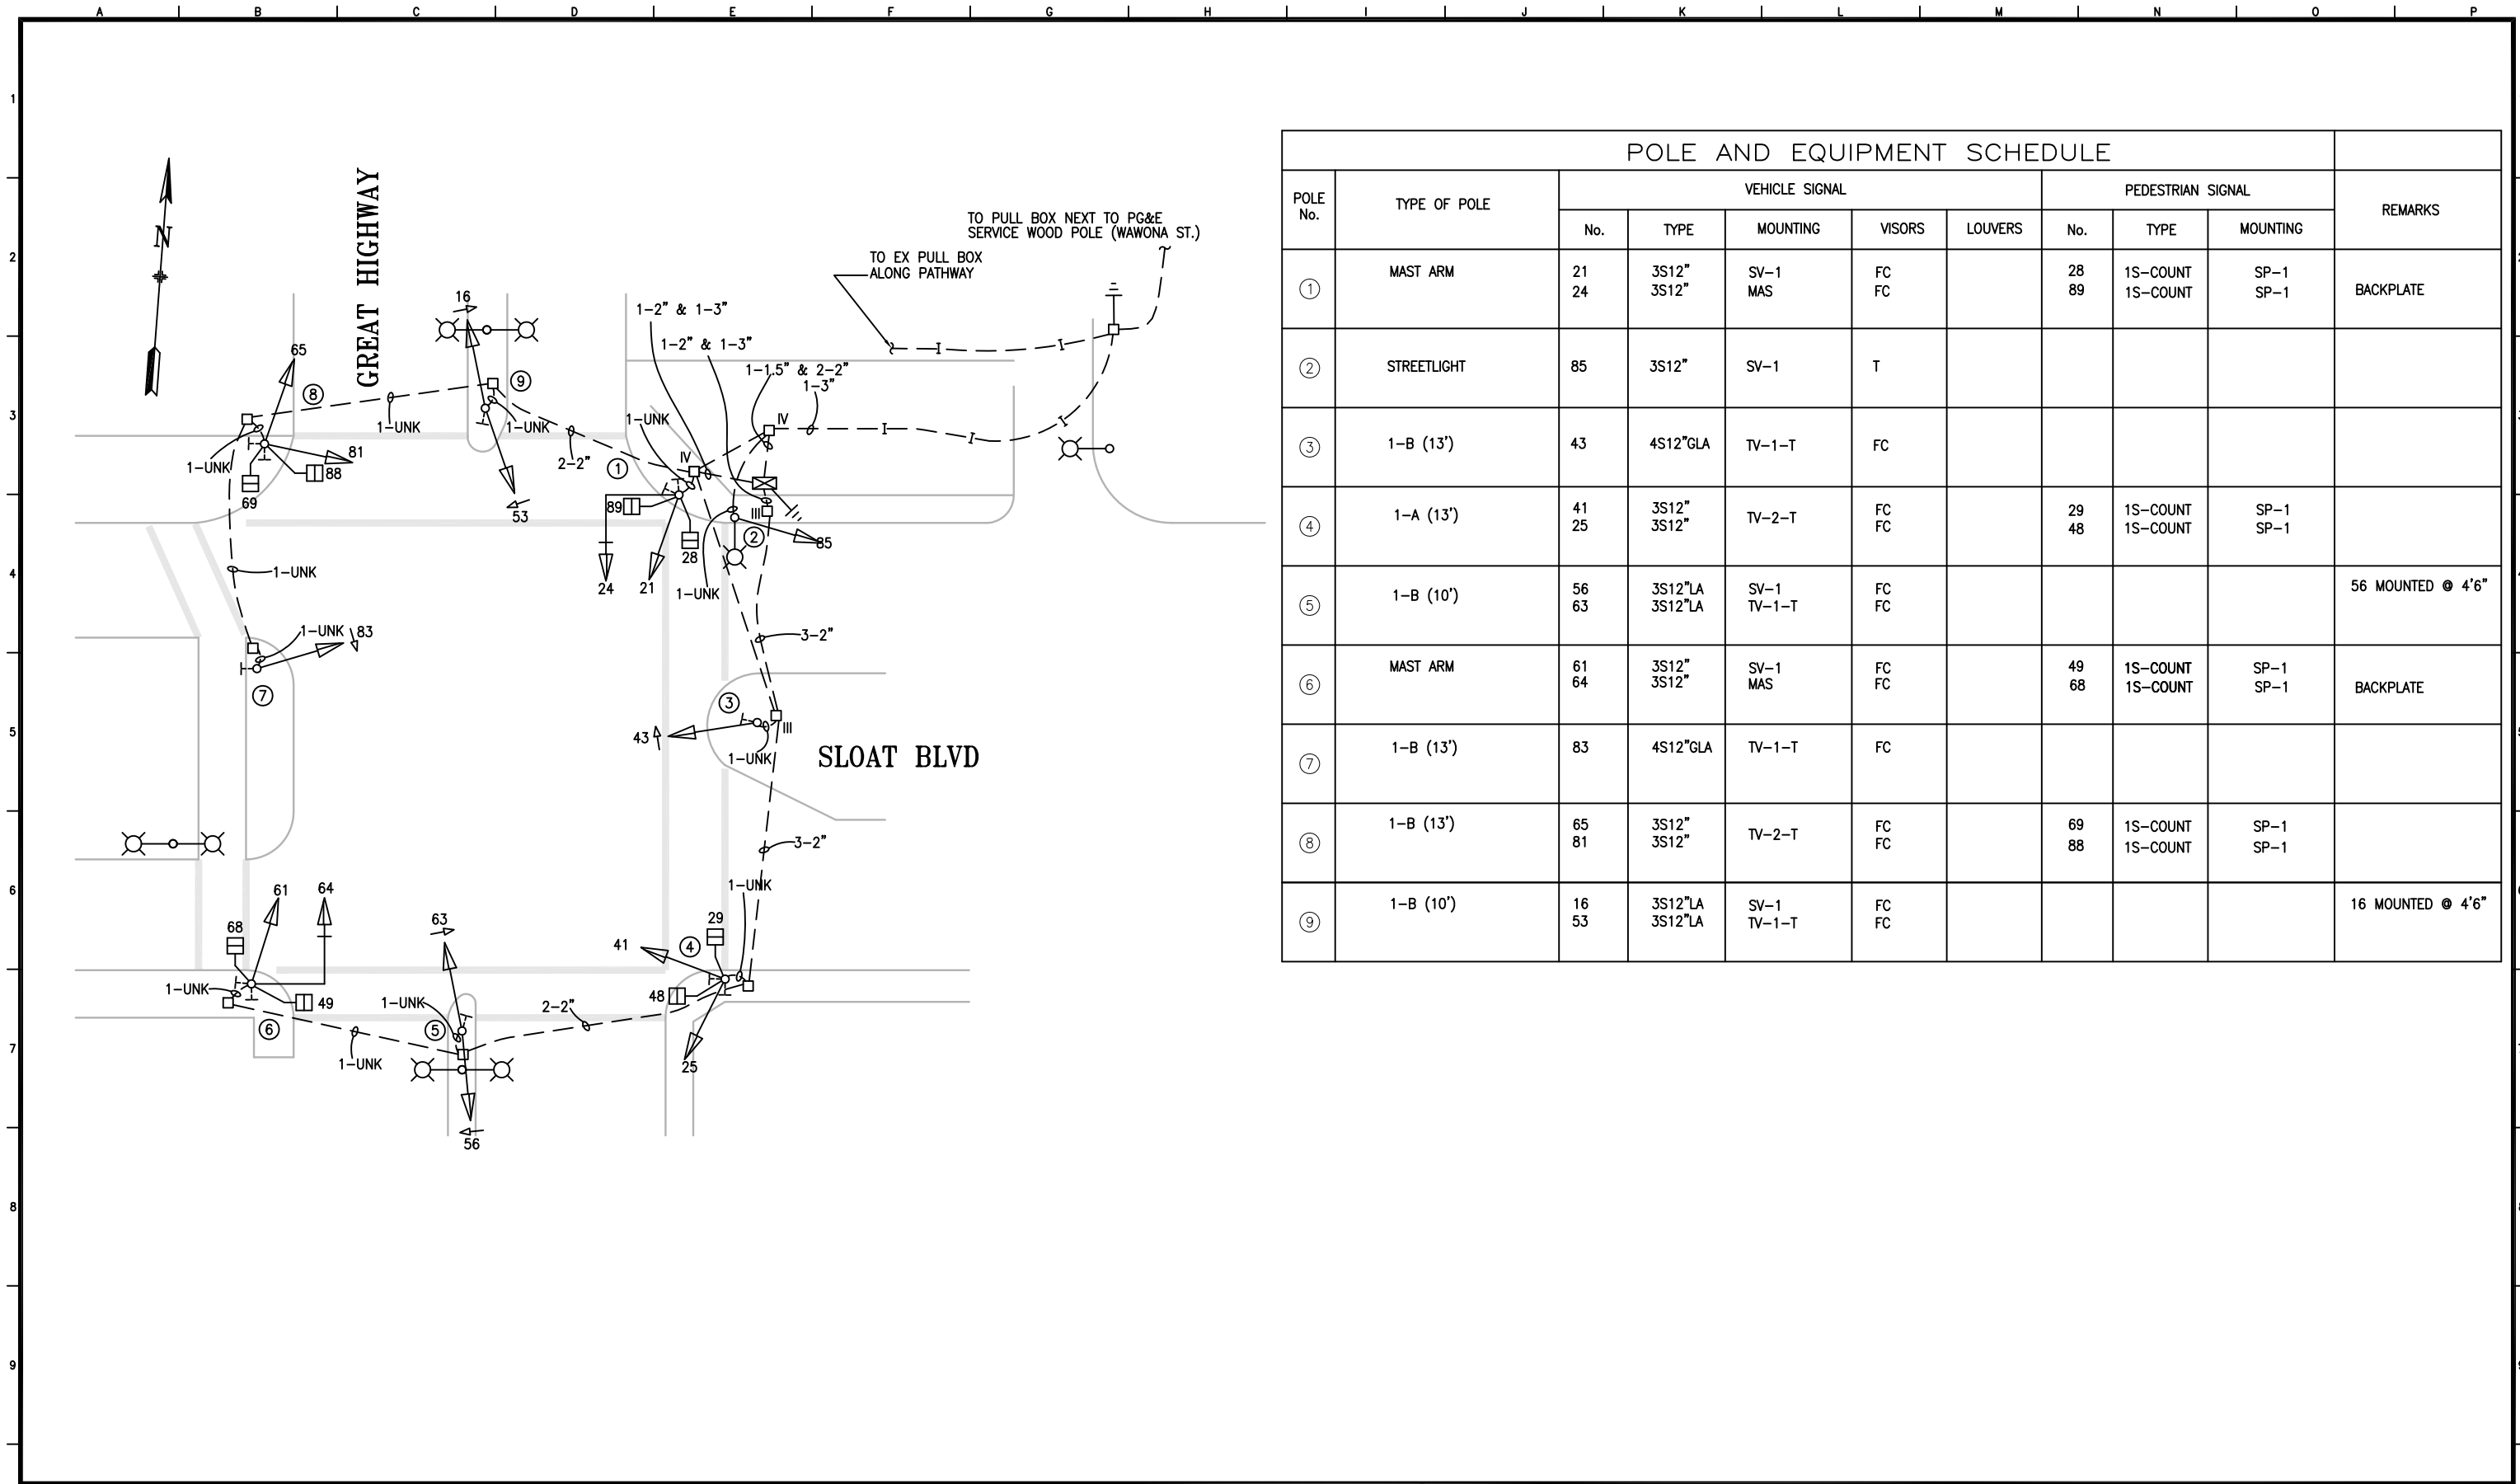

POLE AND EQUIPMENT SCHEDULE										
POLE No.	TYPE OF POLE	VEHICLE SIGNAL					PEDESTRIAN SIGNAL			REMARKS
		No.	TYPE	MOUNTING	VISORS	LOUVERS	No.	TYPE	MOUNTING	
①	MAST ARM	21 24	3S12" 3S12"	SV-1 MAS	FC FC		28 89	1S-COUNT 1S-COUNT	SP-1 SP-1	BACKPLATE
②	STREETLIGHT	85	3S12"	SV-1	T					
③	1-B (13')	43	4S12"GLA	TV-1-T	FC					
④	1-A (13')	41 25	3S12" 3S12"	TV-2-T	FC FC		29 48	1S-COUNT 1S-COUNT	SP-1 SP-1	
⑤	1-B (10')	56 63	3S12"LA 3S12"LA	SV-1 TV-1-T	FC FC					56 MOUNTED @ 4'6"
⑥	MAST ARM	61 64	3S12" 3S12"	SV-1 MAS	FC FC		49 68	1S-COUNT 1S-COUNT	SP-1 SP-1	BACKPLATE
⑦	1-B (13')	83	4S12"GLA	TV-1-T	FC					
⑧	1-B (13')	65 81	3S12" 3S12"	TV-2-T	FC FC		69 88	1S-COUNT 1S-COUNT	SP-1 SP-1	
⑨	1-B (10')	16 53	3S12"LA 3S12"LA	SV-1 TV-1-T	FC FC					16 MOUNTED @ 4'6"

NO.	DATE	DESCRIPTION	BY	APP.
1	10/20/16	CHANGE 43 & 83 TO 4S12"GLA PER 2016-235;	JH	ET
		85 TO 3S12" & REMOVE LOOPS PER FIELD		
0	8/21/02	ACTIVATED THRU 1812J; CONVERTED FROM AS-BUILTS	JH	ET
TABLE OF REVISIONS				
CHECK WITH TRACING TO SEE IF YOU HAVE LATEST REVISION				

REFERENCE INFORMATION & FILE NO. OF SURVEYS
--



SAN FRANCISCO MUNICIPAL TRANSPORTATION AGENCY
CITY AND COUNTY OF SAN FRANCISCO

DRAWN:	DATE:
JH	8/2016
CHECKED:	DATE:
ET	8/2016

SCALE:
AS SHOWN
SHEET OF SHEETS
1 OF 1

TRAFFIC SIGNAL INVENTORY DIAGRAM
GREAT HIGHWAY AND SLOAT BLVD

CNN NO.
32904000
REV NO.
1

FILE NAME: DATE: 03/15/2000
ORIGIN: ELECTRICAL
SCALE FACTOR:
PLOT SCALE:
EXTERNAL REFERENCES:
FONTS USED: ROMANS, ROMANT