


U

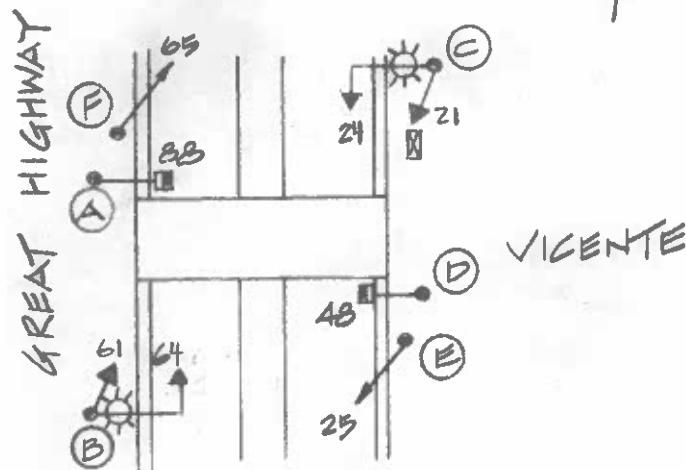

6-19-23

[illegible]

CONTROLLER CABINET SIZE : ORDINARY BASE CABINET: YES

COMMENTS: * SIGNALS 24 & 64 MOUNTED S1-I-T(36") AT 20- FEET HIGH

REMOVE MAST ARMS REPLACE SIGNALS PER SRL 2023-128

J. HOENBOSTEL