


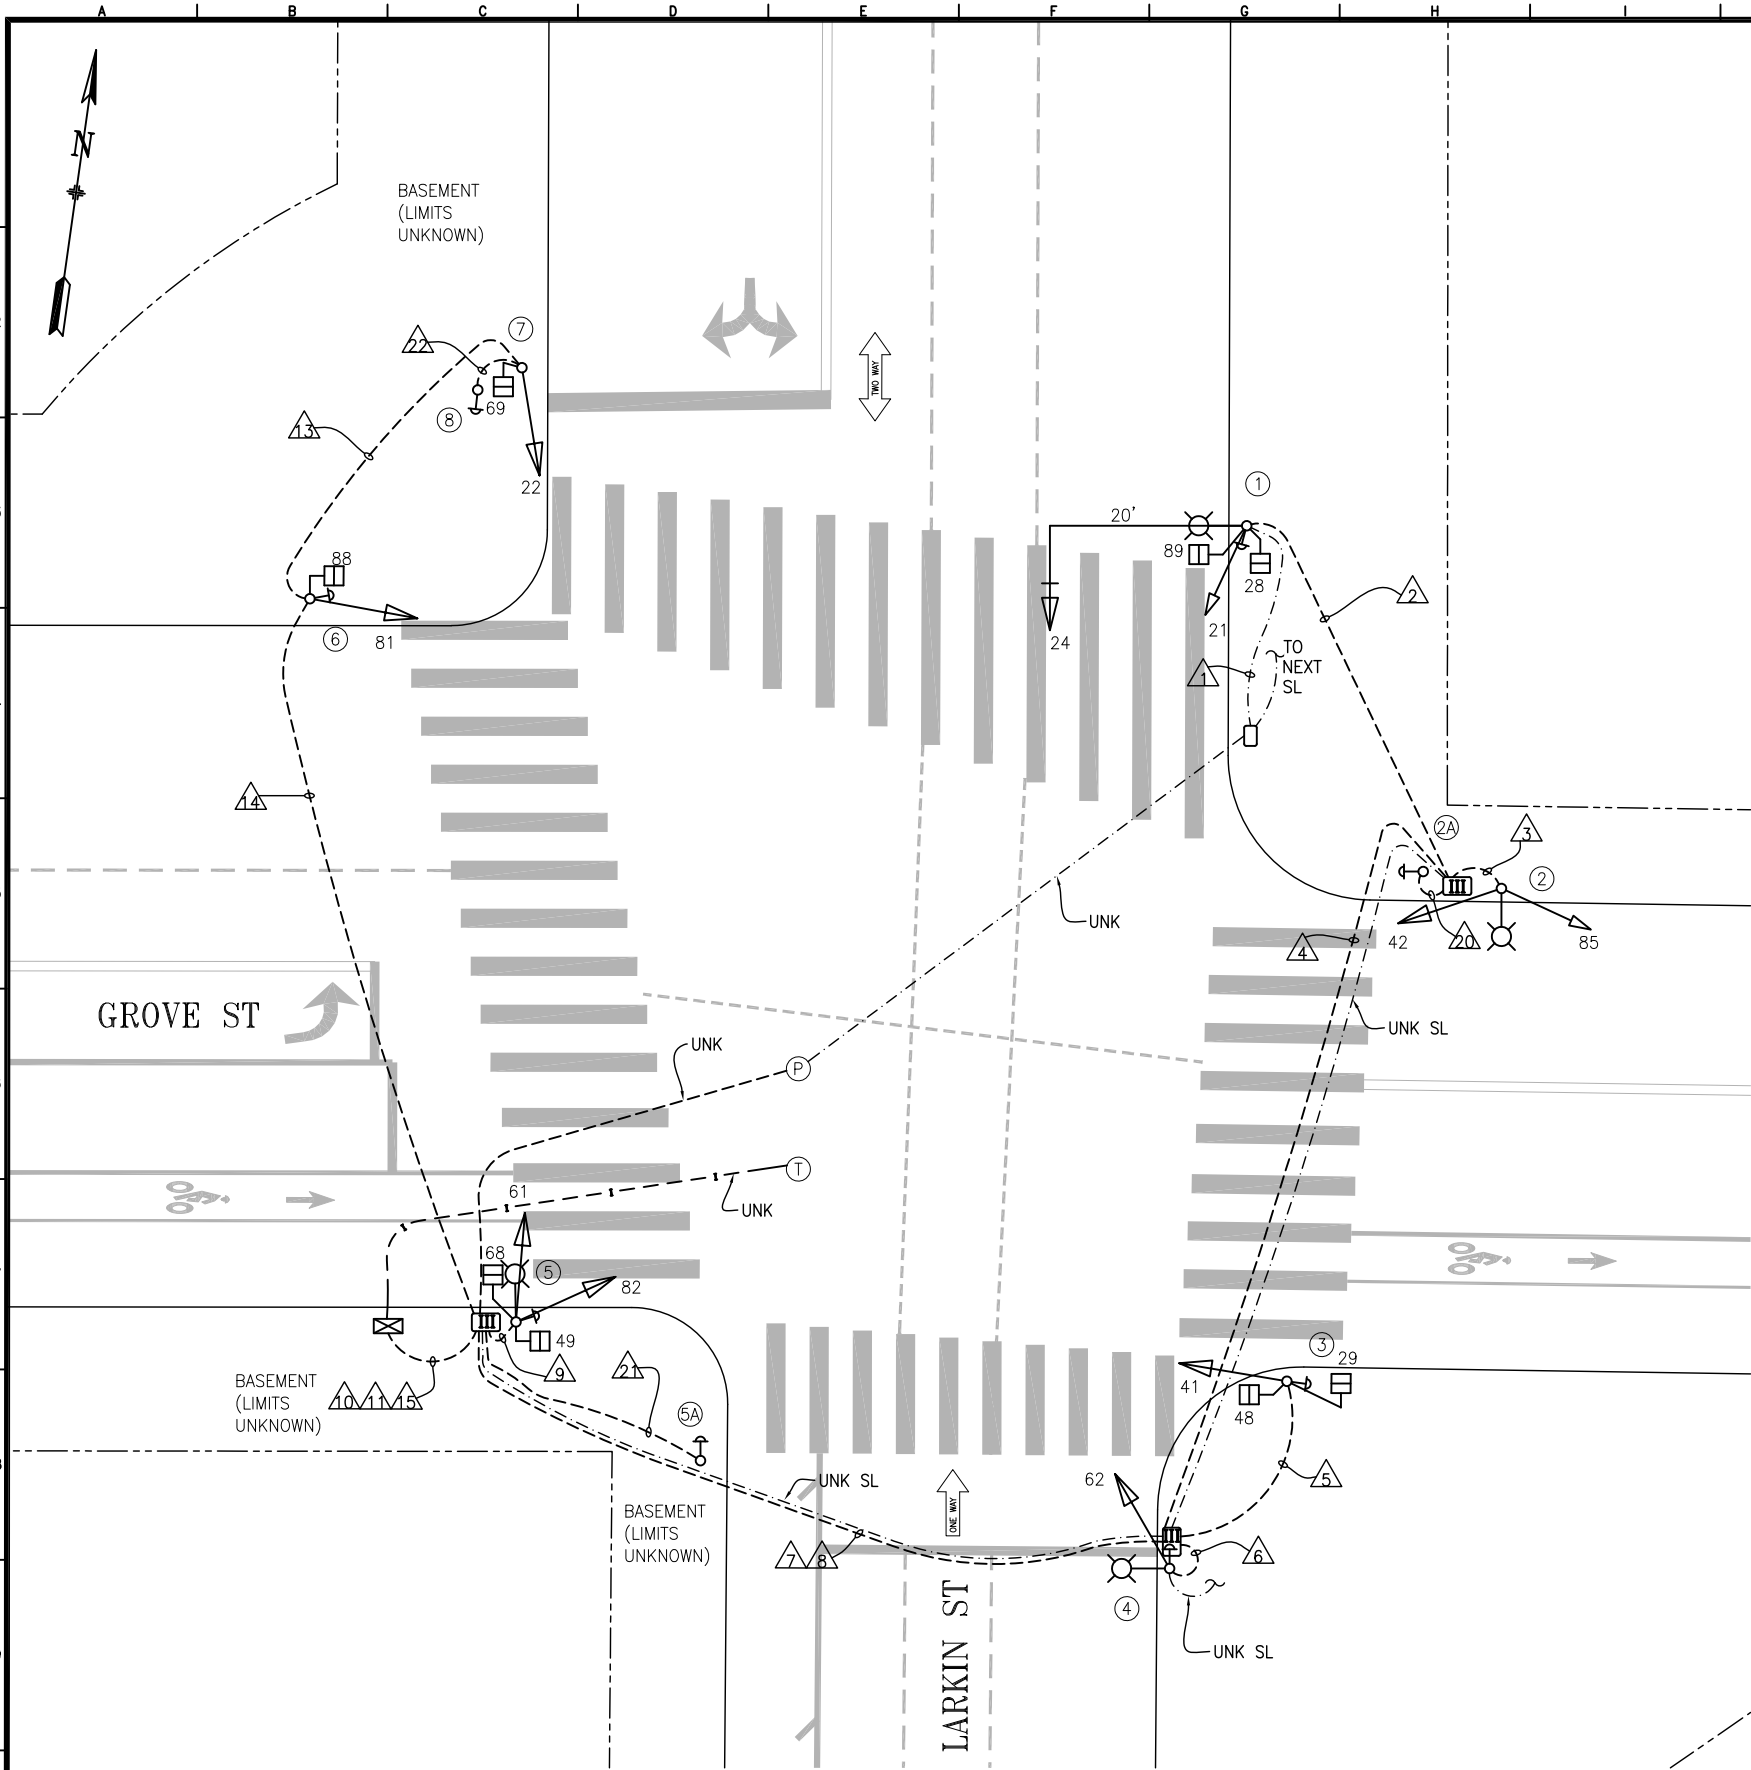

POLE AND EQUIPMENT SCHEDULE										
POLE No.	TYPE OF POLE	VEHICLE SIGNAL					PEDESTRIAN SIGNAL			REMARKS
		No.	TYPE	MOUNTING	VISORS	LOUVERS/BP	No.	TYPE	MOUNTING	
①	17B-1-70 W/ 20' MA & 6' LA	24 21	3S12" 3S8"	MAS SV-1-T	T T	BP	28 89	1S-COUNT 1S-COUNT	SP-1 SP-1 (22")	APS
②	MARBELITE STREETLIGHT	42 85	3S12" 3S8"	SV-2-TA	T T					
②A	PPB POST (4')									APS
③	MARBELITE (10')	41	3S12"	TV-1-T	T		29 48	1S-COUNT 1S-COUNT	SP-1 SP-1	APS
④	MARBELITE STREETLIGHT	62	3S12"FY	SV-1-T	T					APS
⑤	MARBELITE STREETLIGHT	61 82	3S12"FY 3S12"	SV-2-TA	T T		49 68	1S-COUNT 1S-COUNT	SP-1 SP-1	APS
⑤A	PPB POST (4')									APS
⑥	MARBELITE (10')	81	3S12"	TV-1-T	T		88	1S-COUNT	SP-1	APS
⑦	MARBELITE (10')	22	3S12"	TV-1-T	T		69	1S-COUNT	SP-1	
⑧	PPB POST (4')									APS

NO.	DATE	DESCRIPTION	BY	APPROVED
Δ	8/10/23	UPDATE PER FIELD - SV-2-TA FOR POLE 5	D. YEUNG	G. DE LEON
Δ	11/17/09	ADD NEW APS POLES & APS BUTTONS PER 1577J	D. YEUNG	G. DE LEON
Δ	3/16/05	CHANGE 61 & 62 TO 3S12"FY	D. YEUNG	G. DE LEON
Δ	9/14/04	CONVERTED FROM CONTRACT 0480J AS-BUILT	D. YEUNG	G. DE LEON
TABLE OF REVISIONS CHECKOUT DRAWING THROUGH THE SID CUSTODIAN FOR THE LATEST REVISION				



SFMTA

DRAWN BY: D. YEUNG	DATE: MAR 2023
CHECKED BY: G. DE LEON	DATE: MAR 2023

SCALE AS SHOWN
SHEET OF SHEETS 1 OF 2

TRAFFIC SIGNAL INVENTORY DIAGRAM
GROVE ST AND LARKIN ST

CNN NO: 24434000
REV NO: 3

