



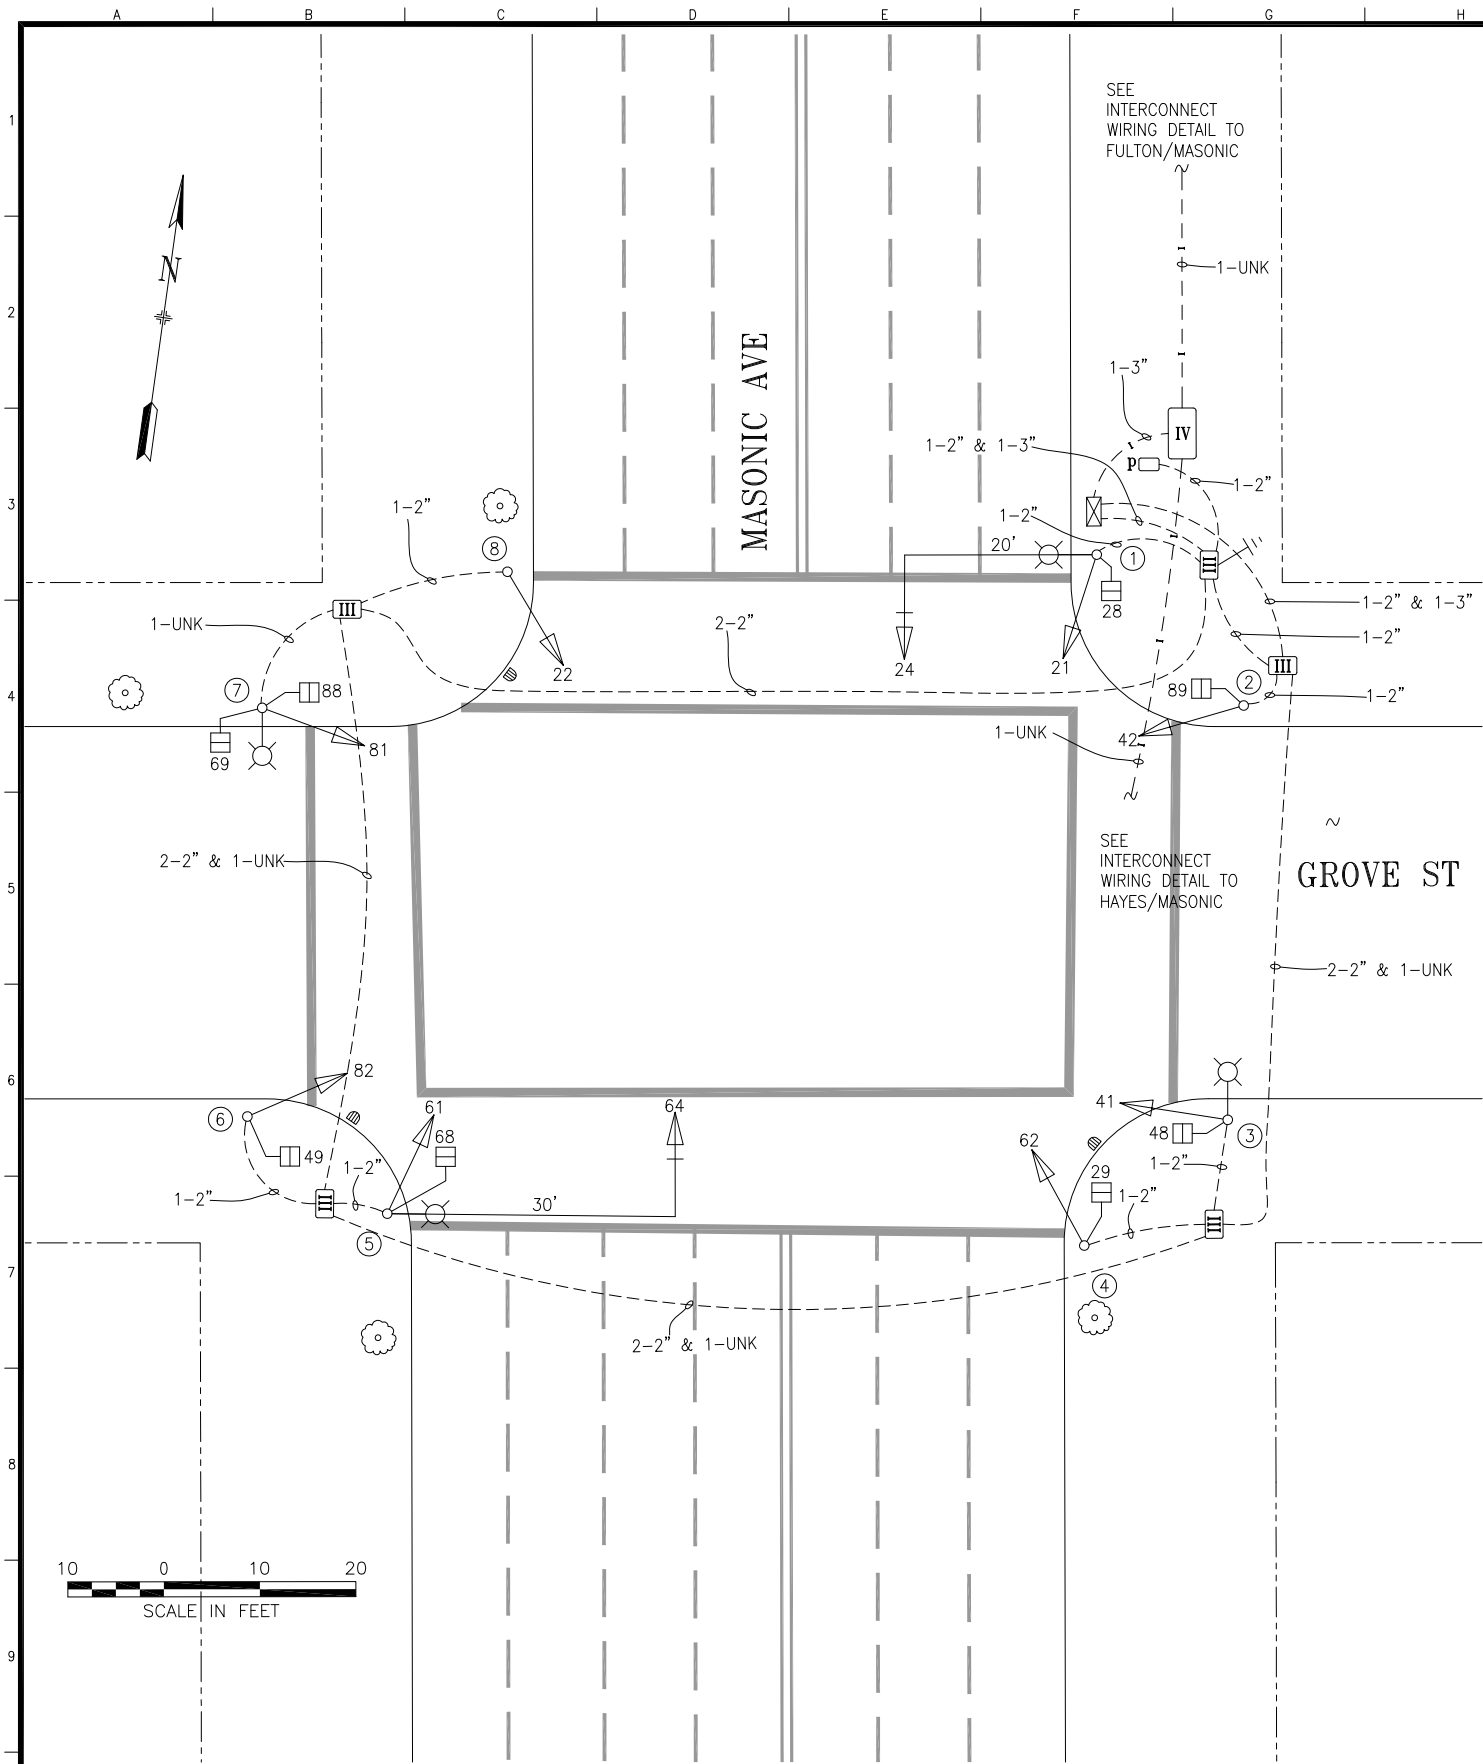

POLE AND EQUIPMENT SCHEDULE											
POLE No.	TYPE OF POLE	LUMINAIRE VOLTAGE/WATTAGE	VEHICLE SIGNAL					PEDESTRIAN SIGNAL			REMARKS
			No.	TYPE	MOUNTING	VISORS	LOUVERS/BP	No.	TYPE	MOUNTING	
①	17B-1-70 WITH 20' MAST ARM AND 6' LUMINAIRE ARM		21 24	3S12" 3S12"	SV-1-T MAS	T FC	BP	28	1S-COUNT	SP-1-T	
②	1-A (10')		42	3S12"	TV-1-T	T		89	1S-COUNT	SP-1	
③	EX SL		41	3S12"	SV-1-T	T		48	1S-COUNT	SP-1	
④	1-A (10')		62	3S12"	TV-1-T	T		29	1S-COUNT	SP-1	
⑤	19-1-70 WITH 30' MAST ARM AND 6' LUMINAIRE ARM		61 64	3S12" 3S12"	SV-1-T MAS	T FC	BP	68	1S-COUNT	SP-1	
⑥	1-A (10')		82	3S12"	TV-1-T	T		49	1S-COUNT	SP-1	
⑦	EX SL		81	3S12"	SV-1-T	T		69 88	1S-COUNT 1S-COUNT	SP-1 (22") SP-1	
⑧	1-A (10')		22	3S12"	TV-1-T	T					

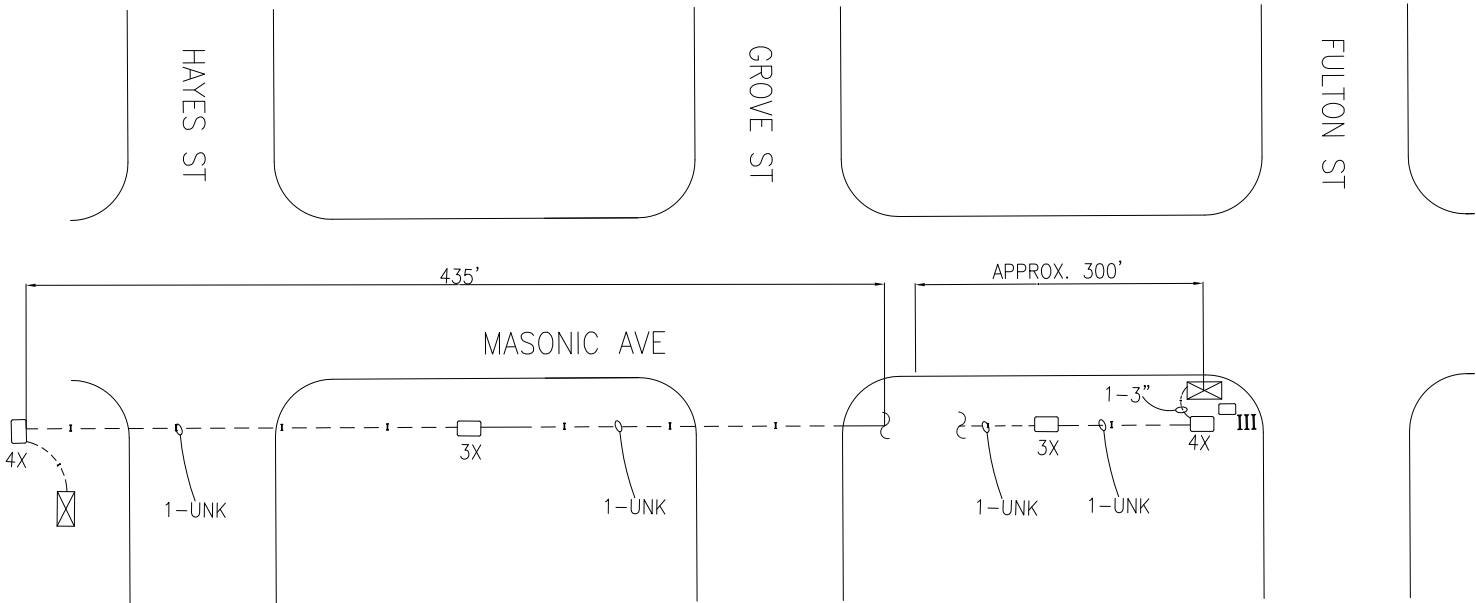

INTERCONNECT WIRING DETAIL
NOT TO SCALE

NO.	DATE	DESCRIPTION	BY	APP.
1	2/20/15	12" HEADS UPGRADED PER 2211J	JH	GD
0	2/1/05	ACTIVATED THRU 0949J; CONVERTED FROM AS-BUILTS	JH	GD

TABLE OF REVISIONS
CHECK WITH TRACING TO SEE IF YOU HAVE LATEST REVISION

REFERENCE INFORMATION
& FILE NO. OF SURVEYS



SAN FRANCISCO MUNICIPAL TRANSPORTATION AGENCY
CITY AND COUNTY OF SAN FRANCISCO

DRAWN:	DATE:
JH	7/2016
CHECKED:	DATE:
GD	7/2016

SCALE:

AS SHOWN

SHEET OF SHEETS

1 OF 1

TRAFFIC SIGNAL INVENTORY DIAGRAM

GROVE STREET AND MASONIC AVENUE

CNN NO.

26377000

REV NO.