


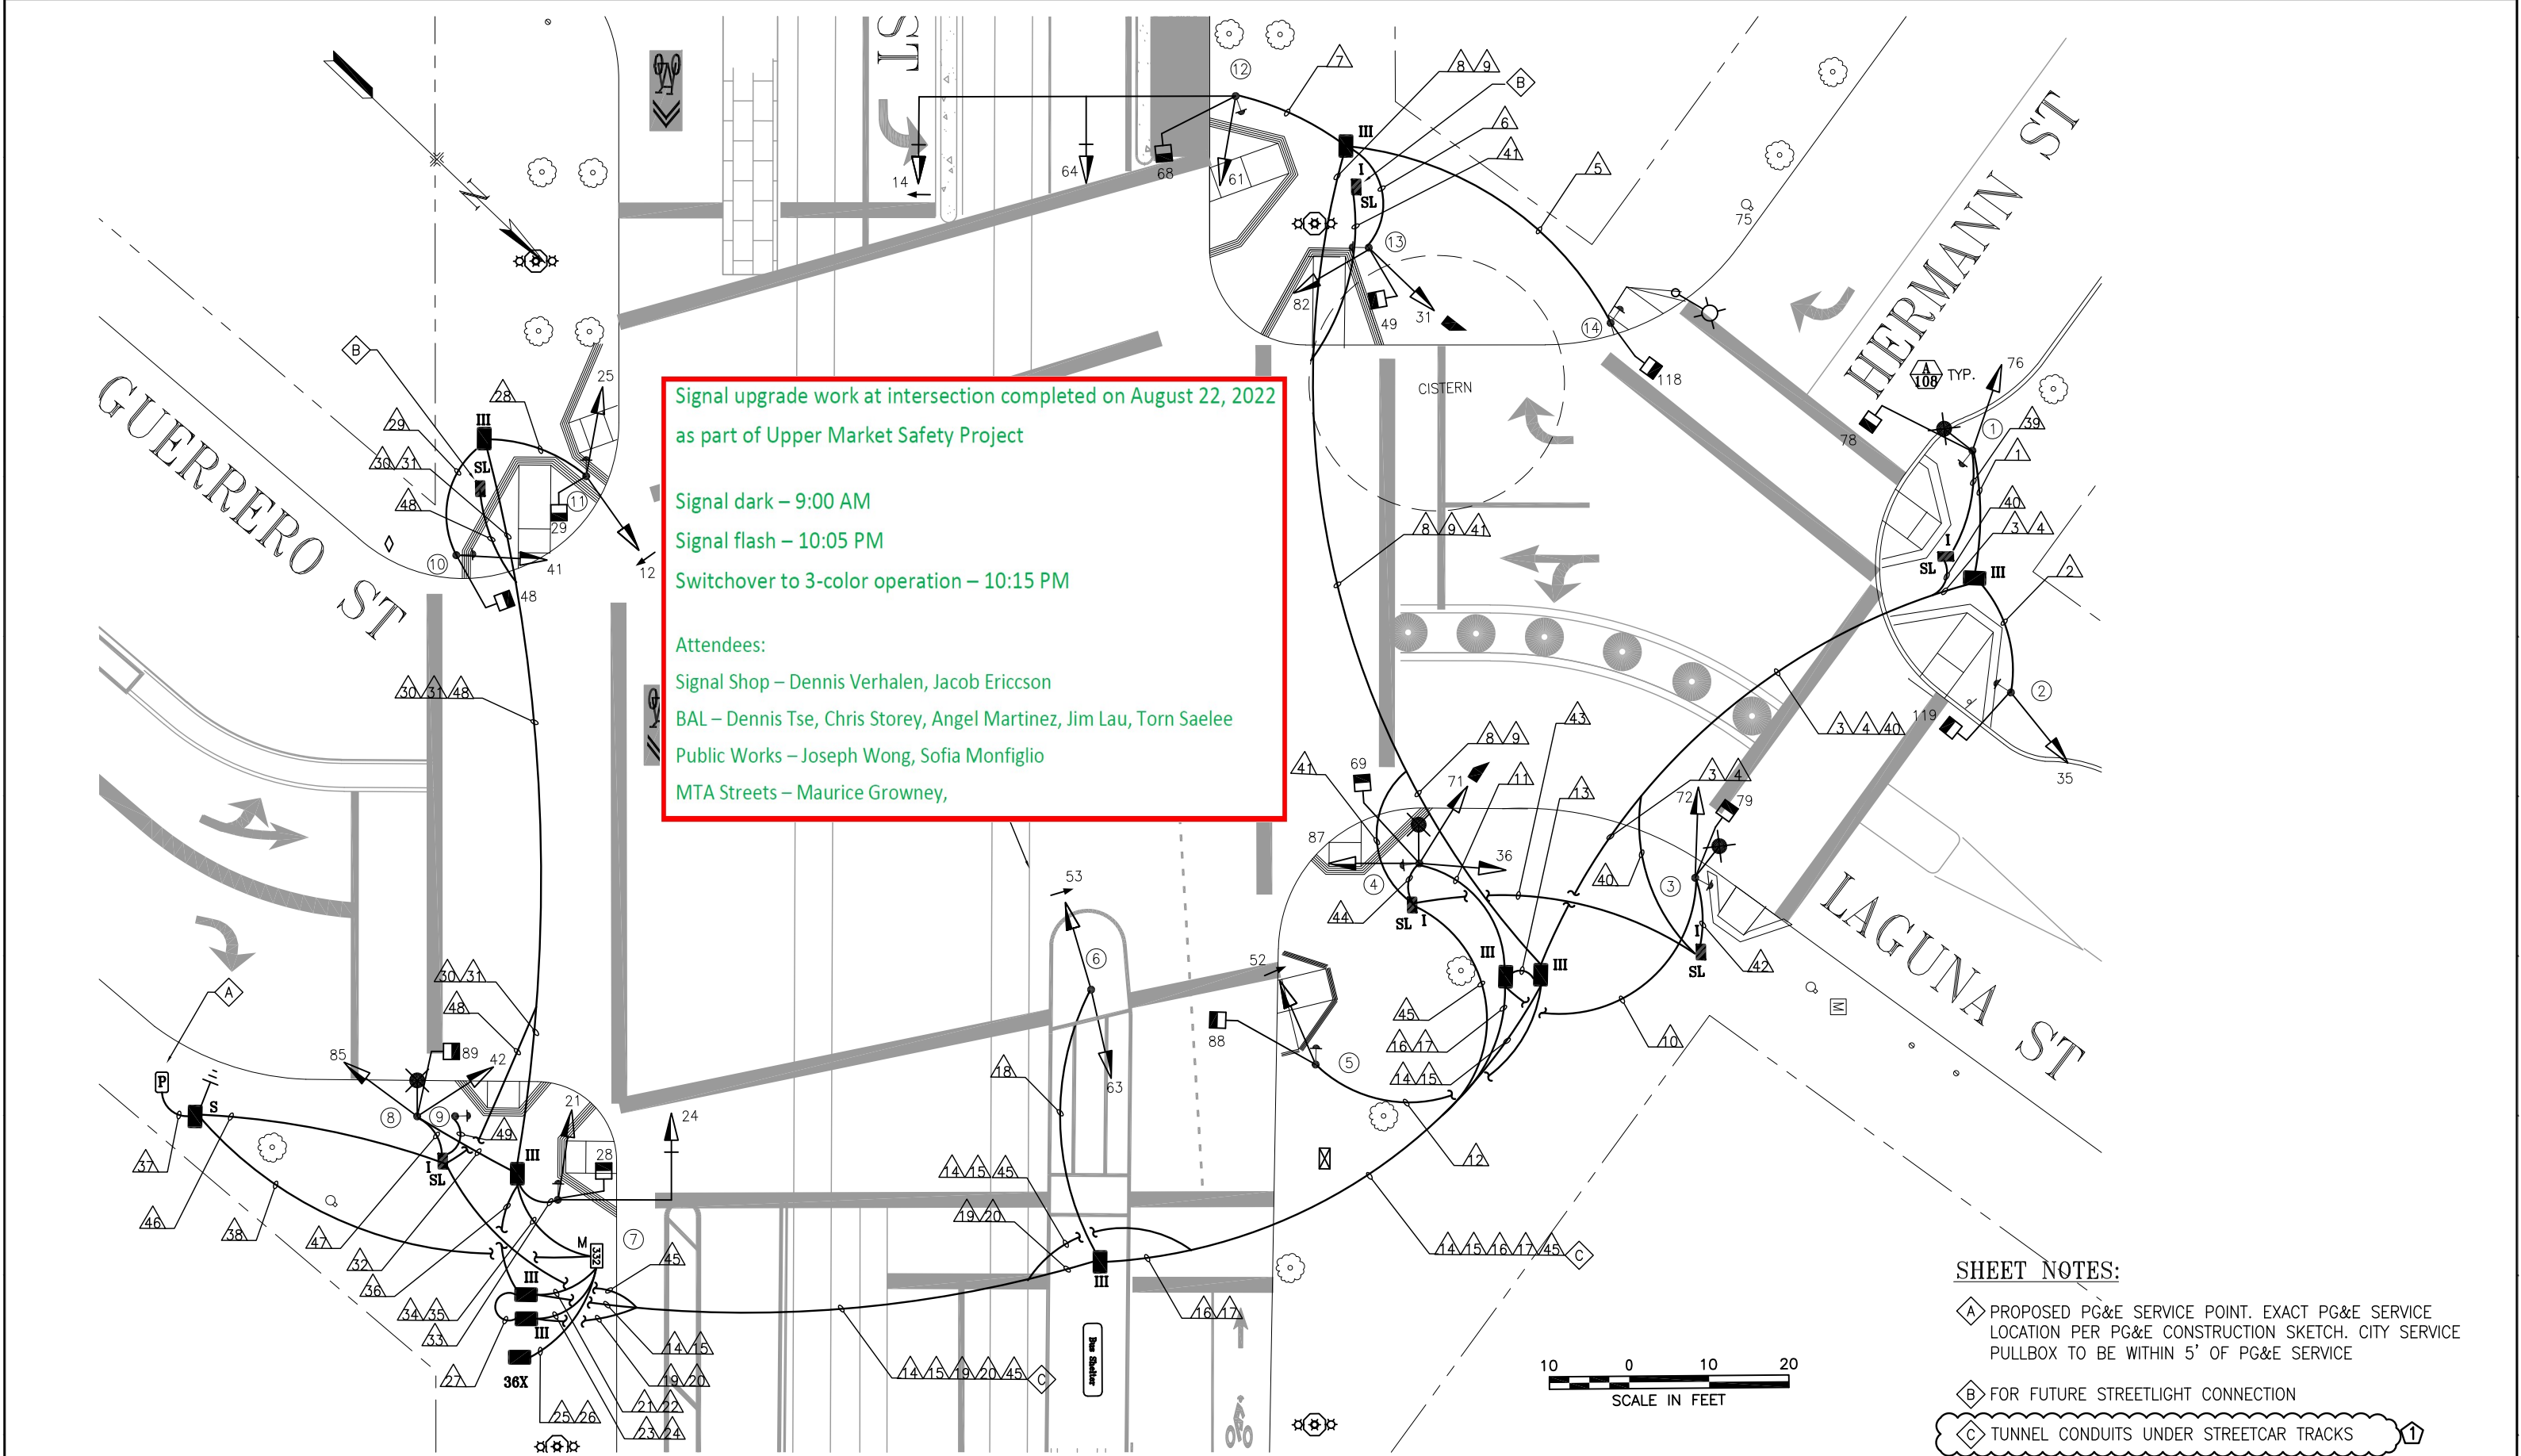

				REFERENCE INFORMATION & FILE NO. OF SURVEYS			 BUREAU OF ENGINEERING CITY & COUNTY OF SAN FRANCISCO SAN FRANCISCO PUBLIC WORKS 49 SOUTH VAN NESS AVENUE, SUITE 800 SAN FRANCISCO, CA 94103 - 1226	Acting Section Mgr: CHI IAO		Date:	DESIGNED: MG/DG	DATE: 03/2020		SCALE: AS SHOWN	UPPER MARKET CORRIDOR SAFETY IMPROVEMENTS PROJECT		CONTRACT ID NO. 1000017336
								Acting Deputy Bureau Mgr: LESLEY WONG			DRAWN: JC/DG	DATE: 03/2020		DRAWING NO. ET-4.1			
								Acting Bureau Mgr: IQBAL DHAPA			CHECKED: MG/SL	DATE: 03/2020		FILE NO. 116,929			
1 10/14/20 ADDENDUM #2				GL	SL								SHEET OF SHEETS 97 OF 126	MARKET ST AND GUERRERO ST/LAGUNA ST TRAFFIC SIGNAL PLAN		REV. NO. 1	
TABLE OF REVISIONS CHECK WITH TRACING TO SEE IF YOU HAVE LATEST REVISION																	