


42.

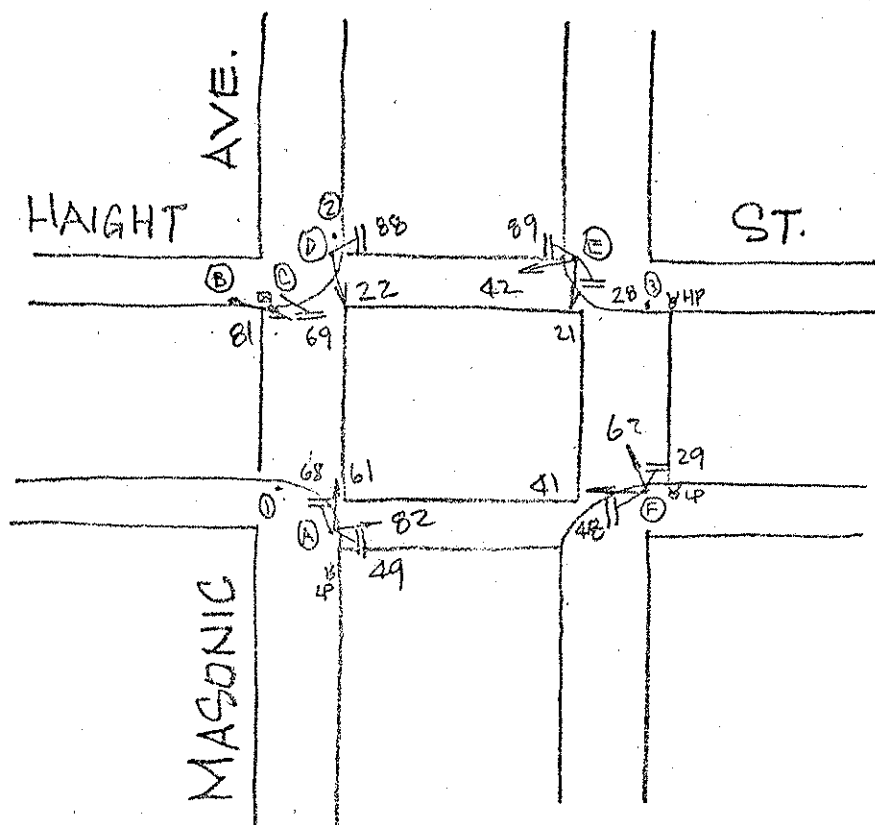

2-28-79

POLE	FUNC.	MAT'L	SIGNAL NO.	MAKE	NO. OF SECT.	SIZE	VISOR	B.P. OR LOUVERS	MOUNT	PED SIGNAL NO.	LEGEND	MESSAGE		MAKE	MOUNT
												ELEMENT	COLOR		
A	M	S	82	EA	3	8"	FC 8"	NO	S	49	W/DW	GRD	G/R	ED	S
B	M	S	61	EA	3	8"	FC 8"	NO	S	68	W/DW	GRD	G/R	ED	S
C	S	C	81	GA	3	8"	FC 12"	NO	S	69	W/DW	GRD	G/R	ED	J
D	S	C	22	GA	3	8"	FC 12"	NO	J	88	W/DW	GRD	G/R	ED	S
E	M	S	42	EA	3	8"	FC 8"	NO	S	89	W/DW	GRD	G/R	ED	S
F	M	S	21	EA	3	8"	FC 8"	NO	S	28	W/DW	GRD	G/R	ED	S
			62	EA	3	8"	FC 8"	NO	S	29	W/DW	GRD	W/DR	ED	S
1	M	S	41	EA	3	8"	FC 8"	NO	S	48	W/DW	GRD	G/R	ED	S
2	U	W													
3	M	S													

CONTROLLER CABINET SIZE : ORDINARY BASE CABINET: YES

COMMENTS :