


POLE AND EQUIPMENT SCHEDULE									
POLE No.	TYPE OF POLE	FIXTURE TYPE	VEHICLE SIGNAL				PEDESTRIAN SIGNAL		REMARKS
			No.	TYPE	MOUNTING	VISORS	No.	TYPE	
①	STEEL STREET LIGHT POLE	A 108	81	3S12"	SV-1-T	T	88	1S-COUNT	SP-1
②	1-A (10')		22	3S12"	TV-1-T	T	69	1S-COUNT	SP-1
③	(E) MUNI STREET LIGHT POLE	(E) 108 LED	21	3S12"	SV-1-T	T	28	1S-COUNT	SP-1
④	1-A(10')		42	3S12"	TV-1-T	T	89	1S-COUNT	SP-1
⑤	STEEL STREET LIGHT POLE	A 108	41	3S12"	SV-1-T	T	48	1S-COUNT	SP-1
⑥	1-A(10')		62	3S12"	TV-1-T	T	29	1S-COUNT	SP-1
⑦	(E) MUNI STREET LIGHT POLE	(E) 108 LED	61	3S12"	SV-1-T	T	68	1S-COUNT	SP-1
⑧	1-A(10')		82	3S12"	TV-1-T	T	49	1S-COUNT	SP-1

SHEET NOTES:

- Ⓐ PRIOR TO SIGNAL ACTIVATION, CONTACT SFMTA FOR REMOVAL FOR STOP SIGN AND PAVEMENT MARKING.
- Ⓑ REMOVE AS CONTRACTOR'S PROPERTY EXISTING STREET LIGHT WIRES. RECONNECT EXISTING STREET LIGHT FIXTURE PER WIRING SCHEDULE.
- Ⓒ ABANDON EXISTING CONDUIT. CUT WIRING AND CONDUIT TO FACE OF PULLBOX AND CAP BOTH ENDS
- Ⓓ COORDINATE WITH PUC TO VERIFY AND MAINTAIN SERVICE TO OTHER EQUIPMENT. COORDINATE WITH PG&E VIA PUC FOR DE-ENERGIZATION OF EXISTING STREET LIGHT SERVICE AFTER NEW SERVICE IS IN OPERATION.
- Ⓔ TREE TRIM UNDER DIRECTION OF BUREAU OF URBAN FORESTRY AT (415) 554-6700. THIS WORK SHALL BE CONSIDERED INCIDENTAL.
- Ⓕ PROVIDE BOLLARD TO PROTECT CABINET.
- Ⓖ FIELD VERIFY EXACT STUB OUT LOCATION. REFER TO PROJECT 2264J REFERENCE DRAWING.
- Ⓗ SEE FIXTURE SCHEDULE ON E-0.4.

① CONTRACTOR TO PROVIDE APS WIRING. CITY FORCES TO PROVIDE APS PUSH BUTTON PER ADA REQUIREMENTS.

PHASE DIAGRAM

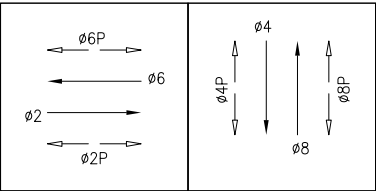

NOTE;  
THIS AUTOCAD DRAWING HAS BEEN REVISED AND REPLOTTED SUBSEQUENT TO INTERNAL ENGINEERING APPROVAL AND SIGN-OFF. FOR THOSE SIGNATURES, SEE THE DRAWING PLOTTED AND ISSUED PREVIOUSLY DURING BIDDING. THE SIGNED DRAWING REMAINS VALID EXCEPT FOR THE CHANGES ONLY AS CLEARLY MARKED ON THIS DRAWING AND ISSUED UNDER THIS LATEST REVISION NUMBER AS SHOWN IN THE TABLE OF REVISIONS LOCATED AT THE LOWER LEFT CORNER OF THE DRAWING. ALL ISSUED REVISIONS SUBSEQUENT TO PREVIOUSLY PLOTTED DRAWING DURING BIDDING REMAIN VALID UNLESS SUPERSEDED BY LATER ISSUED REVISIONS. CHECK ALL ISSUED REVISIONS OF THIS DRAWING.

1	9/5/19	PCO 1: APS ADDITION	DG	SL
NO.	DATE	DESCRIPTION	BY	APP.

THIS DRAWING WAS LAST MODIFIED: 09/09/19 14:27, BY: JacLee

REFERENCE INFORMATION & FILE NO. OF SURVEYS

BUREAU OF DESIGN & ENGINEERING  
CITY & COUNTY OF SAN FRANCISCO  
SAN FRANCISCO PUBLIC WORKS  
30 VAN NESS AVENUE, 5TH FLOOR  
SAN FRANCISCO, CA 94102 - 6028

Section Mgr: PHILIP THWIN  
Deputy Bureau Mgr: IQBALBHAI DHAPA  
Bureau Mgr: PATRICK RIVERA

DESIGNED: DATE: DG/CL 01/2019  
DRAWN: DATE: DG/CL 01/2019  
CHECKED: DATE: SL/KK 01/2019

SCALE: AS SHOWN  
SHEET OF SHEETS 15 OF 21

LOWER HAIGHT TRAFFIC SIGNALS  
HAIGHT STREET AND SCOTT STREET TRAFFIC SIGNAL PLAN

CONTRACT NO. 1000013166  
DRAWING NO. E-4.0  
FILE NO. 113,608  
REV. NO. 1

Xrefs: \DPT Title Block.dwg  
\\CADD Standards\B05 Title Block.dwg  
V:\00003\_Muni\_Foreward\_Haight\_Street\_Signals\2\_Design\Working\_Drawings\EEL\Current\Xref\DE1\_TB\_22x34.dwg  
Model Units: inches  
Drawing Path: V:\00003\_Muni\_Foreward\_Haight\_Street\_Signals\3\_Construction\Design\_Team\EEL\Working\_Drawings\LowerHaight\_Street\_Signals.dwg, Login: JacLee  
Plot Time: Mon, 09 Sep 2019 - 4:14pm

