


POLE No.	TYPE OF POLE	LUMINAIRE VOLTAGE/ WATTAGE	VEHICLE SIGNAL						PEDESTRIAN SIGNAL		REMARKS	D
			No.	TYPE	MOUNTING	VISORS	LOUVERS	No.	TYPE	MOUNTING		
①	CITY STANDARD STREETLIGHT POLE	B3 108	21	3812"	SV-1-T	T		28	1S-COUNT	SP-1	APS-2W	
②	1-A (7')							89	1S-COUNT	TP-1	APS-2W	
③	1-A (7')							48	1S-COUNT	TP-1	APS-2W	
④	CITY STANDARD STREETLIGHT POLE	B3 108	62	3812"	SV-1-T	T		29	1S-COUNT	SP-1	APS-2W	
⑤	1-A (10')		61 82	3812" 3812"	TV-2-T	T T		49	1S-COUNT	SP-1	APS-2W	
⑥	1-A (10')		22 81	3812" 3812"	TV-2-T	T T		88	1S-COUNT	SP-1	APS-2W	

- SHEET NOTES:**
- Ⓐ DURING TRAFFIC SIGNAL SWITCHOVER, R/S EXISTING CABINET AND CONTROLLER. MODIFY CONDUITS AND EXTEND WIRING AS NEEDED. R/C ABANDONED CONDUITS. MAINTAIN EXISTING SIGNALS AND PG&E POWER AS REQUIRED.
  - Ⓑ NOT USED.
  - Ⓒ NEW TRANSIT BULB TO BE INSTALLED IN THIS CONTRACT.
  - Ⓓ INSTALL APS WIRING AS SHOWN IN CONDUIT AND WIRING SCHEDULE. CITY FORCES TO INSTALL CITY FURNISHED APS UNIT.
  - Ⓔ REMOVE AND REPLACE EXISTING FIXTURE WITH NEW LED FIXTURE, TYPE C. SEE LIGHTING FIXTURE SCHEDULE ON DRAWING ET-0.4.
  - Ⓕ SEE DRAWING E-1.0 FOR ROADWAY LIGHTING CONNECTION DETAILS.

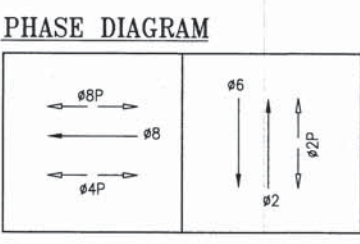

5/5/2021 10:35AM Switchover to new 3-Color operation

Attendees:  
Celine Leung (SFMTA SSD)  
Daniel Brugmann ((SFPW CM)  
Dennis Verhalen & Denny Guevara (Signal Shop)  
Jim Lau (BAL)



REFERENCE INFORMATION & FILE NO. OF SURVEYS				DESIGN & ENGINEERING CITY & COUNTY OF SAN FRANCISCO SAN FRANCISCO PUBLIC WORKS 30 VAN NESS AVENUE, 5TH FLOOR SAN FRANCISCO, CA 94102 - 8028		Section Mgr: PHILIP THWIN Deputy Division Mgr: IQBALBHAI DHAPPA Division Mgr: PATRICK RIVERA	Date: 7/12/12 7/17/12 7/17/12	DESIGNED: JT/NL 07/17 DRAWN: JT/NL 07/17 CHECKED: KK/SL 07/17	SCALE: AS SHOWN SHEET OF SHEETS OF	UPPER HAIGHT TRANSIT IMPROVEMENT AND PEDESTRIAN REALM PROJECT HAIGHT ST AND STANYAN ST TRAFFIC SIGNAL WORK	CONTRACT NO. 2535J DRAWING NO. ET-10.0 FILE NO. 108,924 REV. NO.
---	--	--	--	---	--	--	-------------------------------------	---	---------------------------------------	---	---