


PHASE DIAGRAM:

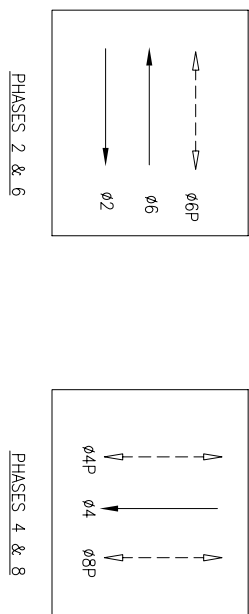

PHASE SEQUENCE:

G		Y	R		HARRISON STREET
R		G		Y	HAWTHORNE STREET
RH		WM		FRH	PED XING HARRISON STREET
WM		FRH	RH		PED XING HAWTHORNE STREET

DETAIL NOTES:

- |    |  |   |   |
|----|--|---|---|
| 49 | EX CONDUIT & WIRING, EX SL. WIRING TO REMAIN. F/I NEW WIRING AS NOTED.   | 1 | NOT USED  |
| 0  | CHIP EXISTING FOUNDATION CAREFULLY TO BRING CONDUIT INTO BASE OF STANDARD OR CONTROLLER CABINET AND REPAIR AFTER INSTALLATION. | 2 | LOCATE PULL BOX APPROXIMATELY MIDWAY ALONG CONDUIT RUN. |
| 12 | F/I IN-LINE FUSE HOLDER W/40A FUSE FOR IC SERVICE. F/I NEW WIRING AS NOTED. F/I GROUND ROD.                                    |   |   |

SHEET NOTES:

- 1 NOT USED
- 2 LOCATE PULL BOX APPROXIMATELY MIDWAY ALONG CONDUIT RUN.

# AS BUILT DRAWING

APPROVAL SIGNATURES ON ORIGINAL CONTRACT DRAWINGS.

[illegible]

[illegible][illegible]

DETAIL NOTES:

- |    |  |
|----|--|
| P  | PVC CONDUIT SCHEDULE 80.   |
| Q  | F/1 4-2" POLYETHYLENE SCHEDULE 80 CONDUIT WITH 1/4" NYLON PULL TAPE IN EACH CONDUIT. |
| Q3 | F/1 2 - 2" PVC SCHEDULE 80 CONDUIT WITH 1/4" NYLON PULL TAPE IN EACH CONDUIT.        |
| S  | COORDINATE WITH PG&E   |

[illegible]