


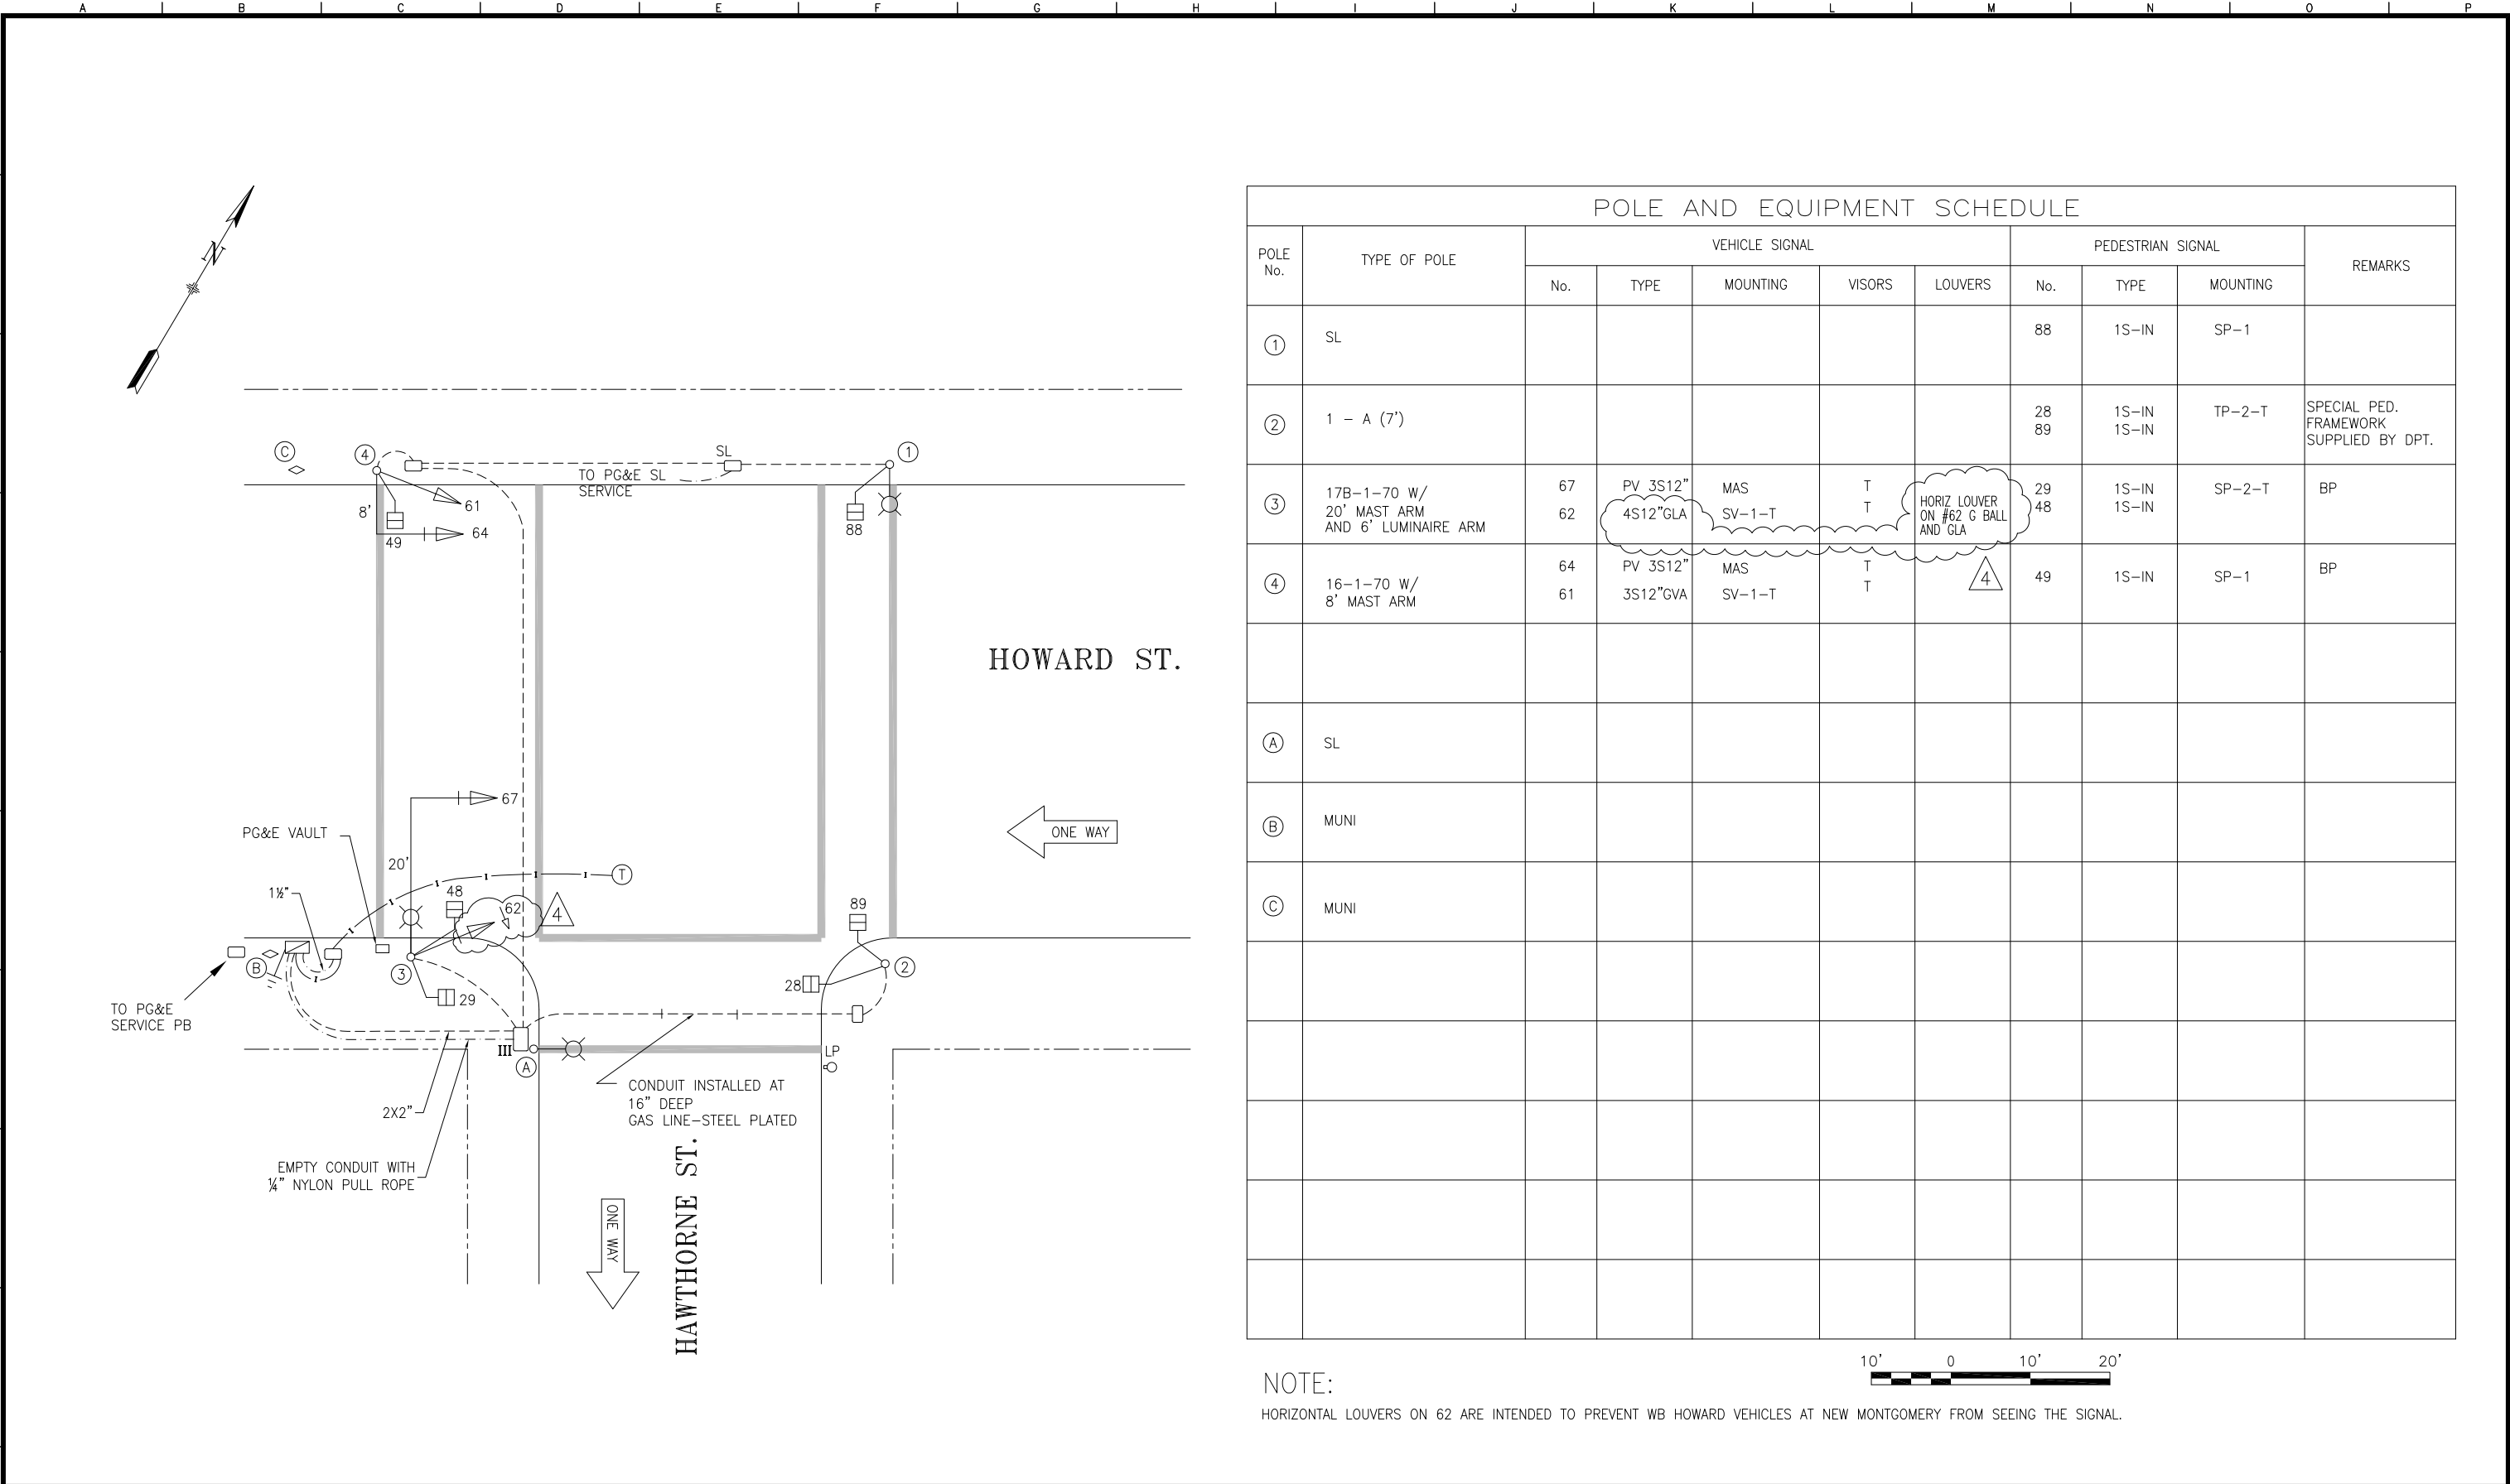

4	7/15/13	CHANGE 62 TO 4S12" GLA AND ADD LOUVER TO GLA.	ET	HQ
3	1/28/13	UPGRADE 61 AND 62 TO 12-INCH. HORIZ LOUVER FOR 62 G BALL, AND GVA FOR 61.	DY	BW
2	2/04	REPLACE LOUVERED HEADS WITH PV HEADS	RO	RO
1	03/99	HOWARD STREET SIGNAL UPGRADE CONTRACT #1430N	CXL	RO
NO.	DATE	DESCRIPTION	BY	APP.

TABLE OF REVISIONS
CHECK WITH TRACING TO SEE IF YOU HAVE LATEST REVISION

SAN FRANCISCO MUNICIPAL TRANSPORTATION AGENCY
TRANSPORTATION ENGINEERING
CITY AND COUNTY OF SAN FRANCISCO

COMPLETION DATE /
ELECTRICIAN INITIAL

DRAWN:	DATE:	SCALE:
JD/CXL	12/28/00	1" = 20'
CHECKED:	DATE:	SHEET OF SHEETS
		1 OF 1

TRAFFIC SIGNAL INVENTORY DIAGRAM
HAWTHORNE ST & HOWARD ST

CNN NO.
24595000
REV. NO.
4

FILE NAME: Hawthorne_Howard.dwg
DATE: Apr 10 2001 14:20
ORIGIN: SECTION
SCALE FACTOR: 120
PLOT SCALE: 1=1
EXTERNAL REFERENCES: T:\T_E_Files\Soles_Tax\SID\New_SID\Howard\Temp.dwg T:\T_E_Files\Soles_Tax\SID\New_SID\Tb34x22.dwg
FONTS USED: ROMAND.shx ROMANS.shx ROMANS.SHX ROMANT ROMANT.SHX.txt