




POLE AND EQUIPMENT SCHEDULE											
POLE No.	TYPE OF POLE	LUMINAIRE VOLTAGE/ WATTAGE	VEHICLE SIGNAL					PEDESTRIAN SIGNAL			REMARKS
			No.	TYPE	MOUNTING	VISORS	LOUVERS	No.	TYPE	MOUNTING	
①	MUNI POLE W/ 6' LA							28 89	1S-COUNT 1S-COUNT	SP-1 SP-1-SF (12")	RLC FLASHER
②	1-A (7")							48	1S-COUNT	TP-1	
③	1-A (10')		62	3S12"	TV-1-T	T		29	1S-COUNT	SP-1	
④	1-A (10')		61	3S12"	TV-1-T	T		68	1S-COUNT	SP-1	
⑤	MUNI POLE W/ 20' MAST ARM AND 6' LA		84 82	3S12" 3S12"	MAS SV-1-T	T T		48	1S-COUNT	SP-1	BACKPLATE
⑥	MUNI POLE W/ 15' MAST ARM		65 87	3S12" 3S12"	SV-1-T MAS	T T		69 88	1S-COUNT 1S-COUNT	SP-1 SP-1	BACKPLATE
⑦	1-A (10')		23 66	3S12" BIKE 3S12"	TV-2-T	T T	HORIZONTAL LOUVER				
⑧	1-A (10')		21	3S12" BIKE	TV-1-T	T					
A	RLC POLE (20')										CAMERA STROBE CABINET
B	RLC POLE (15')										CAMERA STROBE (x2) CONTROL BOX RADAR DETECTION
C	RLC POLE (15')										CAMERA STROBE CONTROL BOX
D	RLC POLE (20')										CAMERA STROBE CABINET
E	RLC POLE (15')										CAMERA STROBE (x2) CONTROL BOX RADAR DETECTION

2	05/25/21	INSTALL 65 & 66 (2020-211)	E.LIU	G.DE LEON
1	12/11/19	RLC UPGRADE BY 2855J; CONVERTED FROM AS-BUILTS	J.HORNOSTEL	G.DE LEON
0	08/06/15	2543J PUNCHLIST WALKTHROUGH; UPGRADE 61 & 62 TO 12"	D.Yeung	M.Velasco
NO.	DATE	DESCRIPTION	BY	APPROVED

TABLE OF REVISIONS
CHECKOUT DRAWING THROUGH THE SID CUSTODIAN FOR THE LATEST REVISION

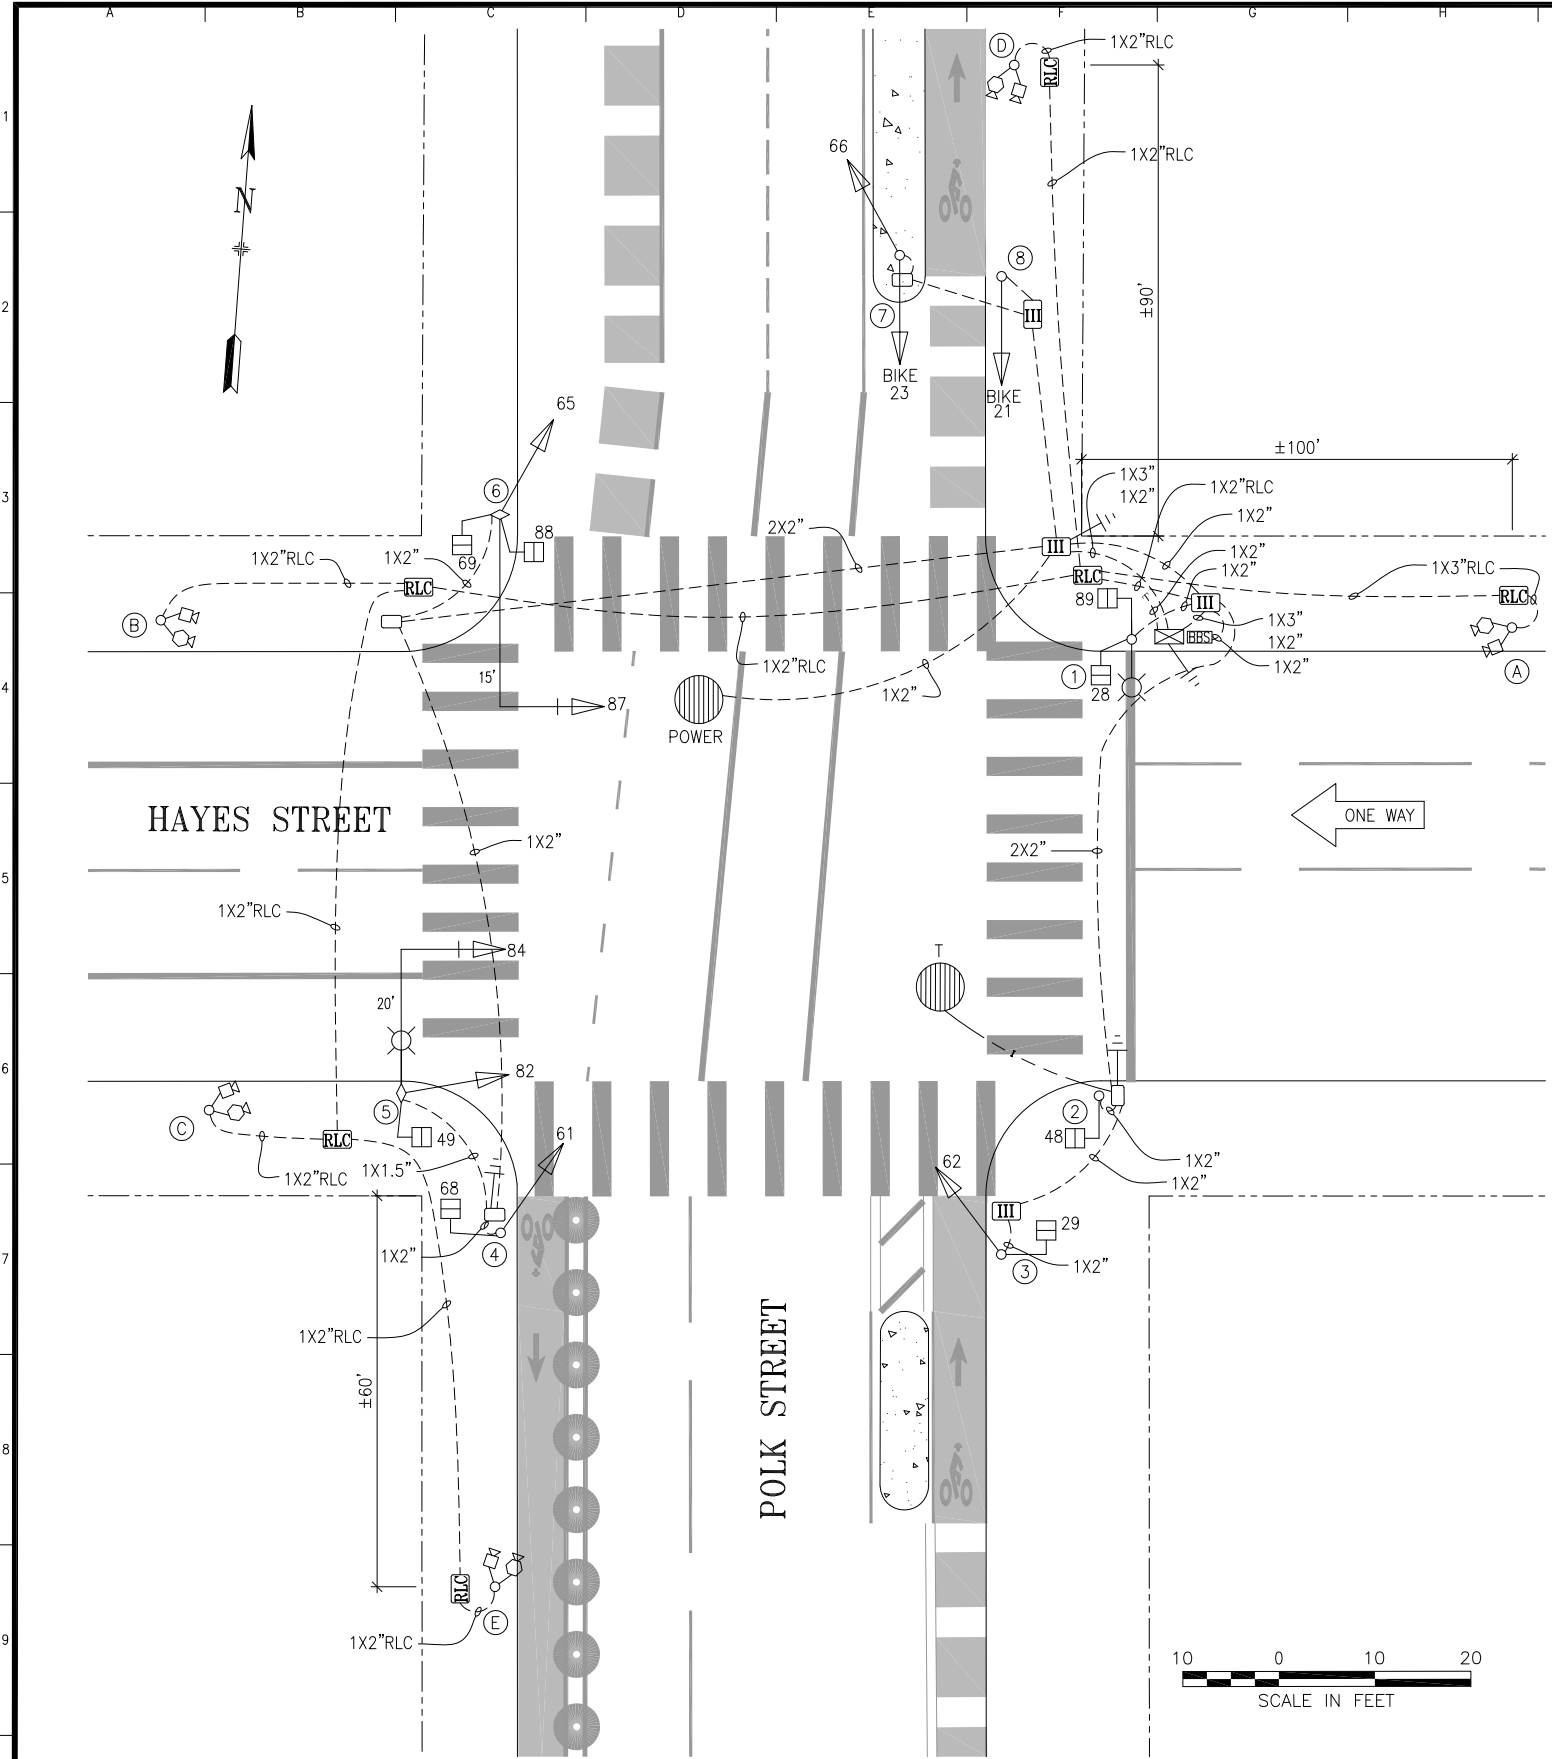

DRAWN BY:	DATE:
AScales	12/2015
CHECKED BY:	DATE:
MVelasco	12/2015

SCALE
AS SHOWN
SHEET OF SHEETS
1 OF 1

TRAFFIC SIGNAL INVENTORY DIAGRAM
HAYES STREET AND POLK STREET

CNN NO:
24436000
REV NO:
2