


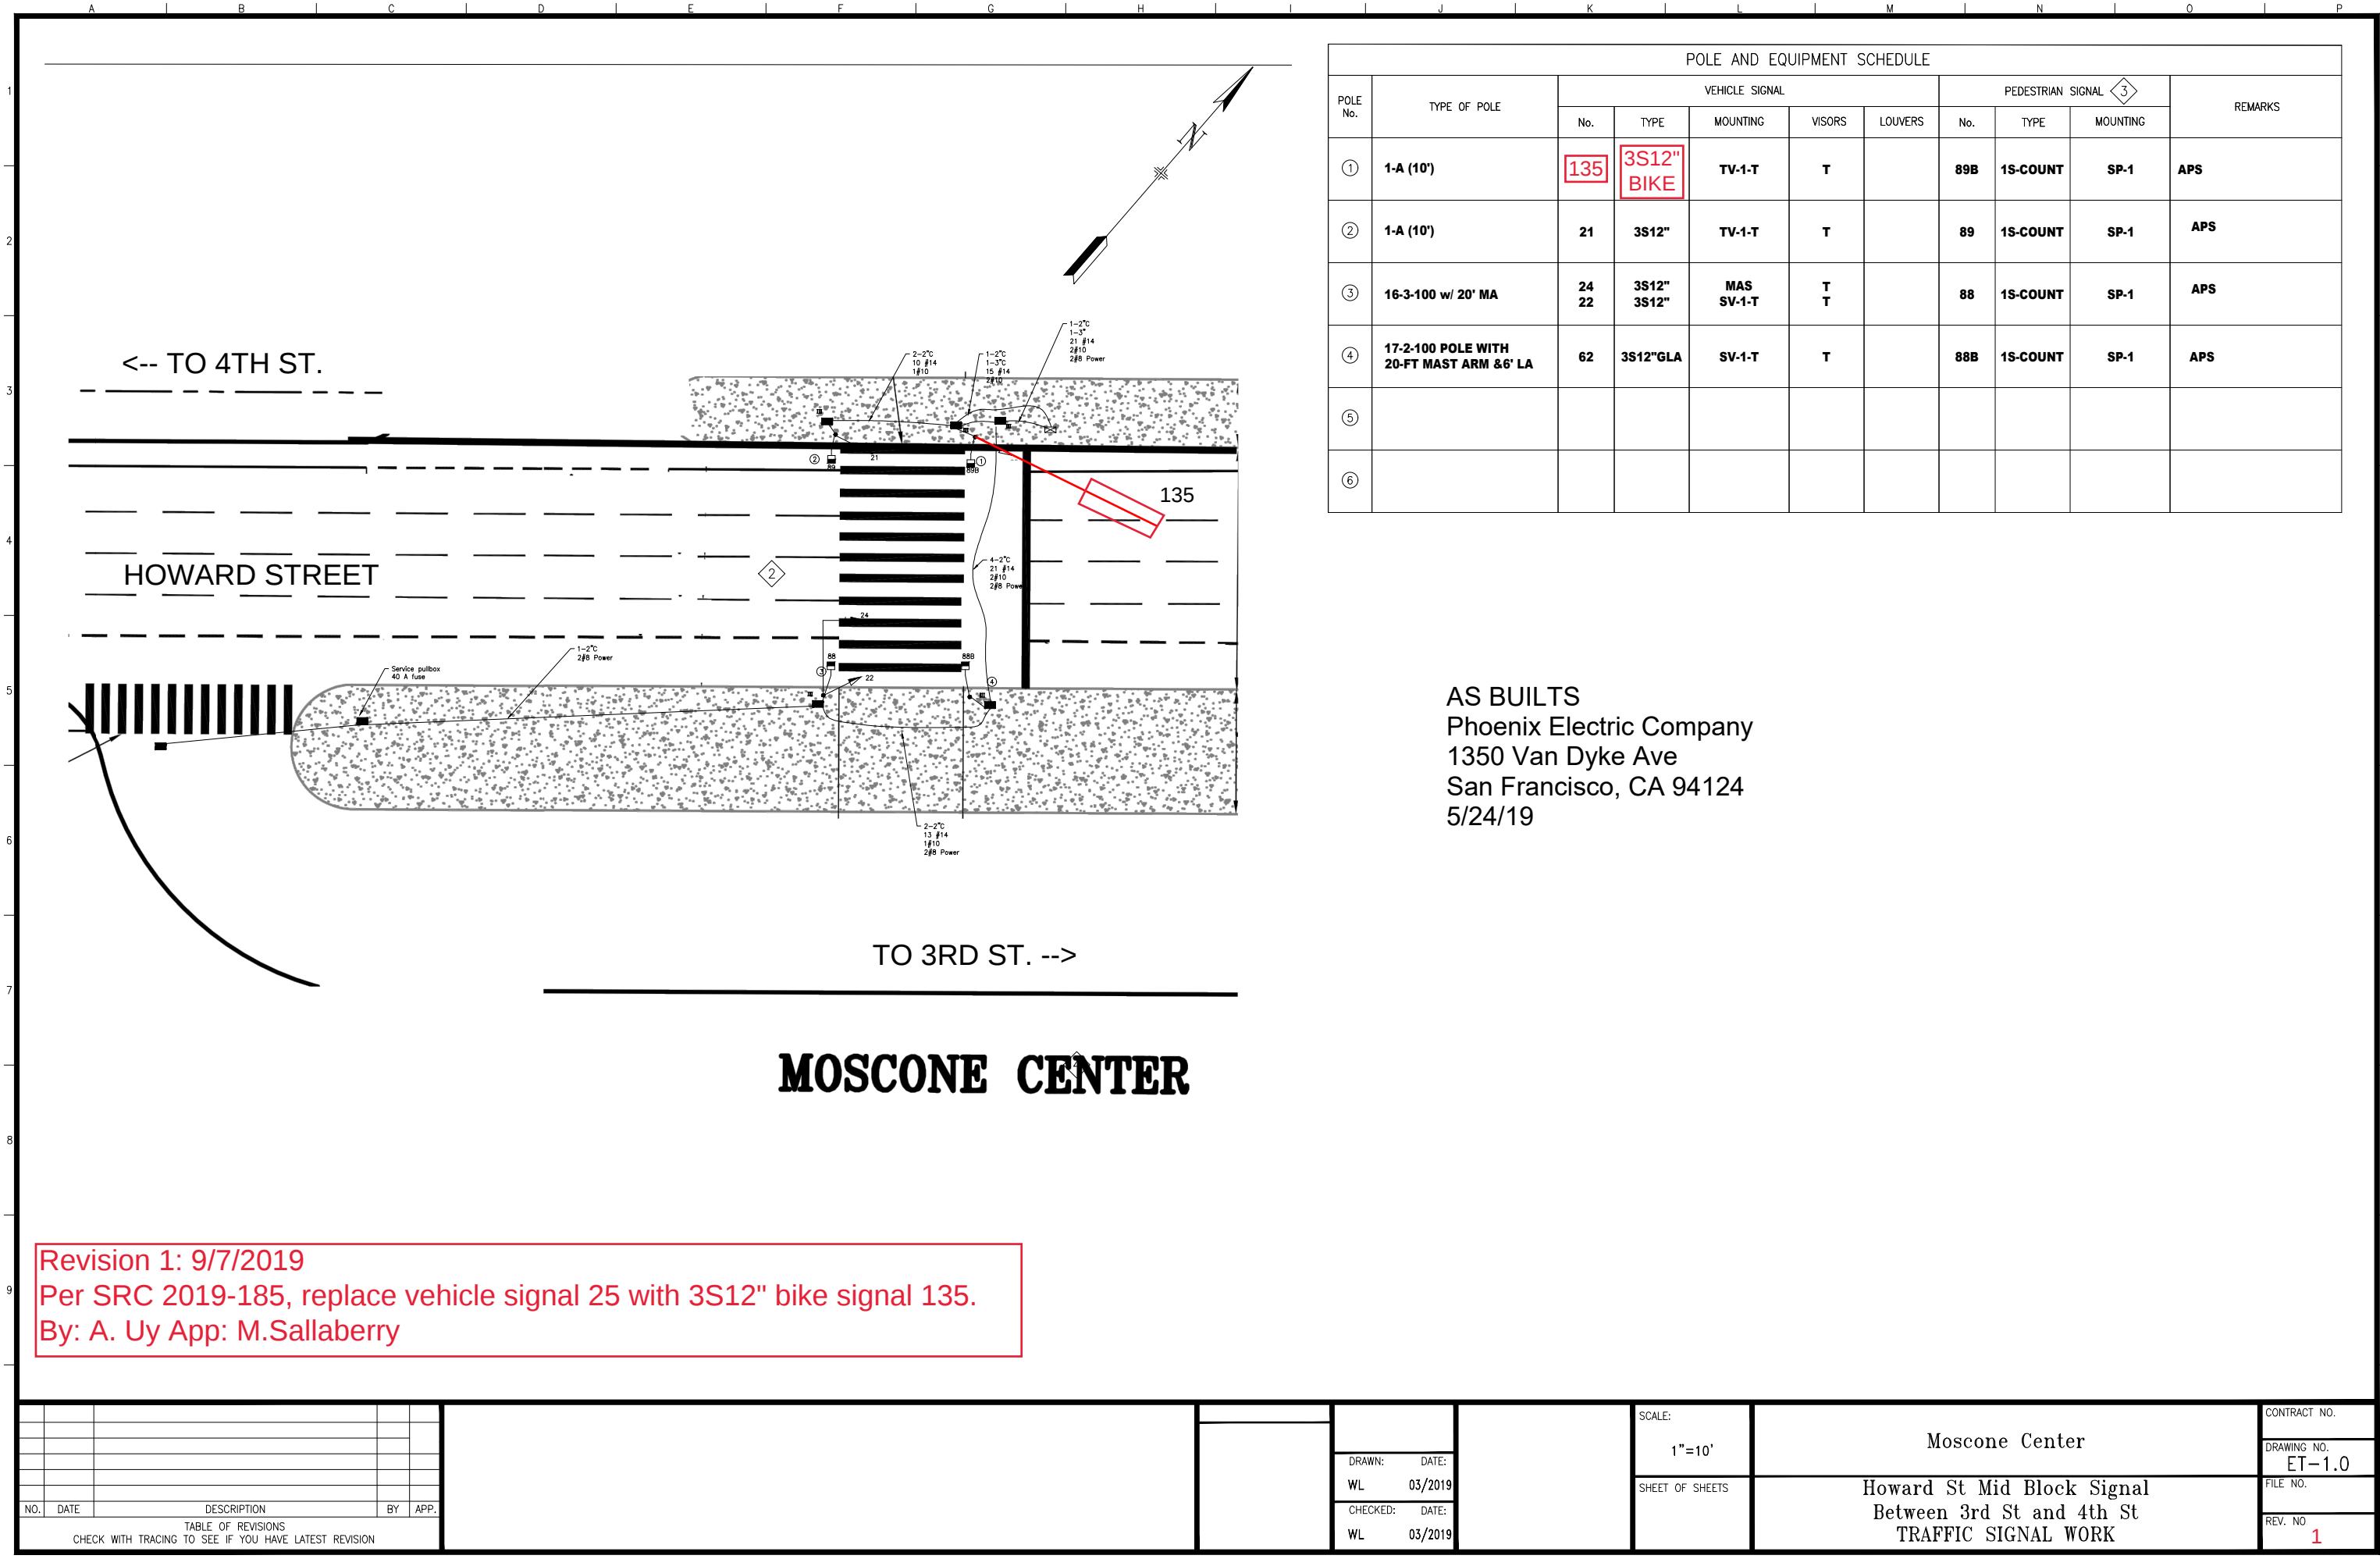

POLE AND EQUIPMENT SCHEDULE										
POLE No.	TYPE OF POLE	VEHICLE SIGNAL					PEDESTRIAN SIGNAL 3			REMARKS
		No.	TYPE	MOUNTING	VISORS	LOUVERS	No.	TYPE	MOUNTING	
①	1-A (10')	135	3S12" BIKE	TV-1-T	T		89B	1S-COUNT	SP-1	APS
②	1-A (10')	21	3S12"	TV-1-T	T		89	1S-COUNT	SP-1	APS
③	16-3-100 w/ 20' MA	24 22	3S12" 3S12"	MAS SV-1-T	T T		88	1S-COUNT	SP-1	APS
④	17-2-100 POLE WITH 20-FT MAST ARM & 6' LA	62	3S12"GLA	SV-1-T	T		88B	1S-COUNT	SP-1	APS
⑤										
⑥										

AS BUILTS
Phoenix Electric Company
1350 Van Dyke Ave
San Francisco, CA 94124
5/24/19

Revision 1: 9/7/2019
Per SRC 2019-185, replace vehicle signal 25 with 3S12" bike signal 135.
By: A. Uy App: M.Sallaberry

NO.	DATE	DESCRIPTION	BY	APP.
TABLE OF REVISIONS				
CHECK WITH TRACING TO SEE IF YOU HAVE LATEST REVISION				

DRAWN:	DATE:
WL	03/2019
CHECKED:	DATE:
WL	03/2019

SCALE:	CONTRACT NO.
1"=10'	DRAWING NO. ET-1.0
SHEET OF SHEETS	FILE NO.
	REV. NO. 1

Moscone Center
Howard St Mid Block Signal Between 3rd St and 4th St TRAFFIC SIGNAL WORK