


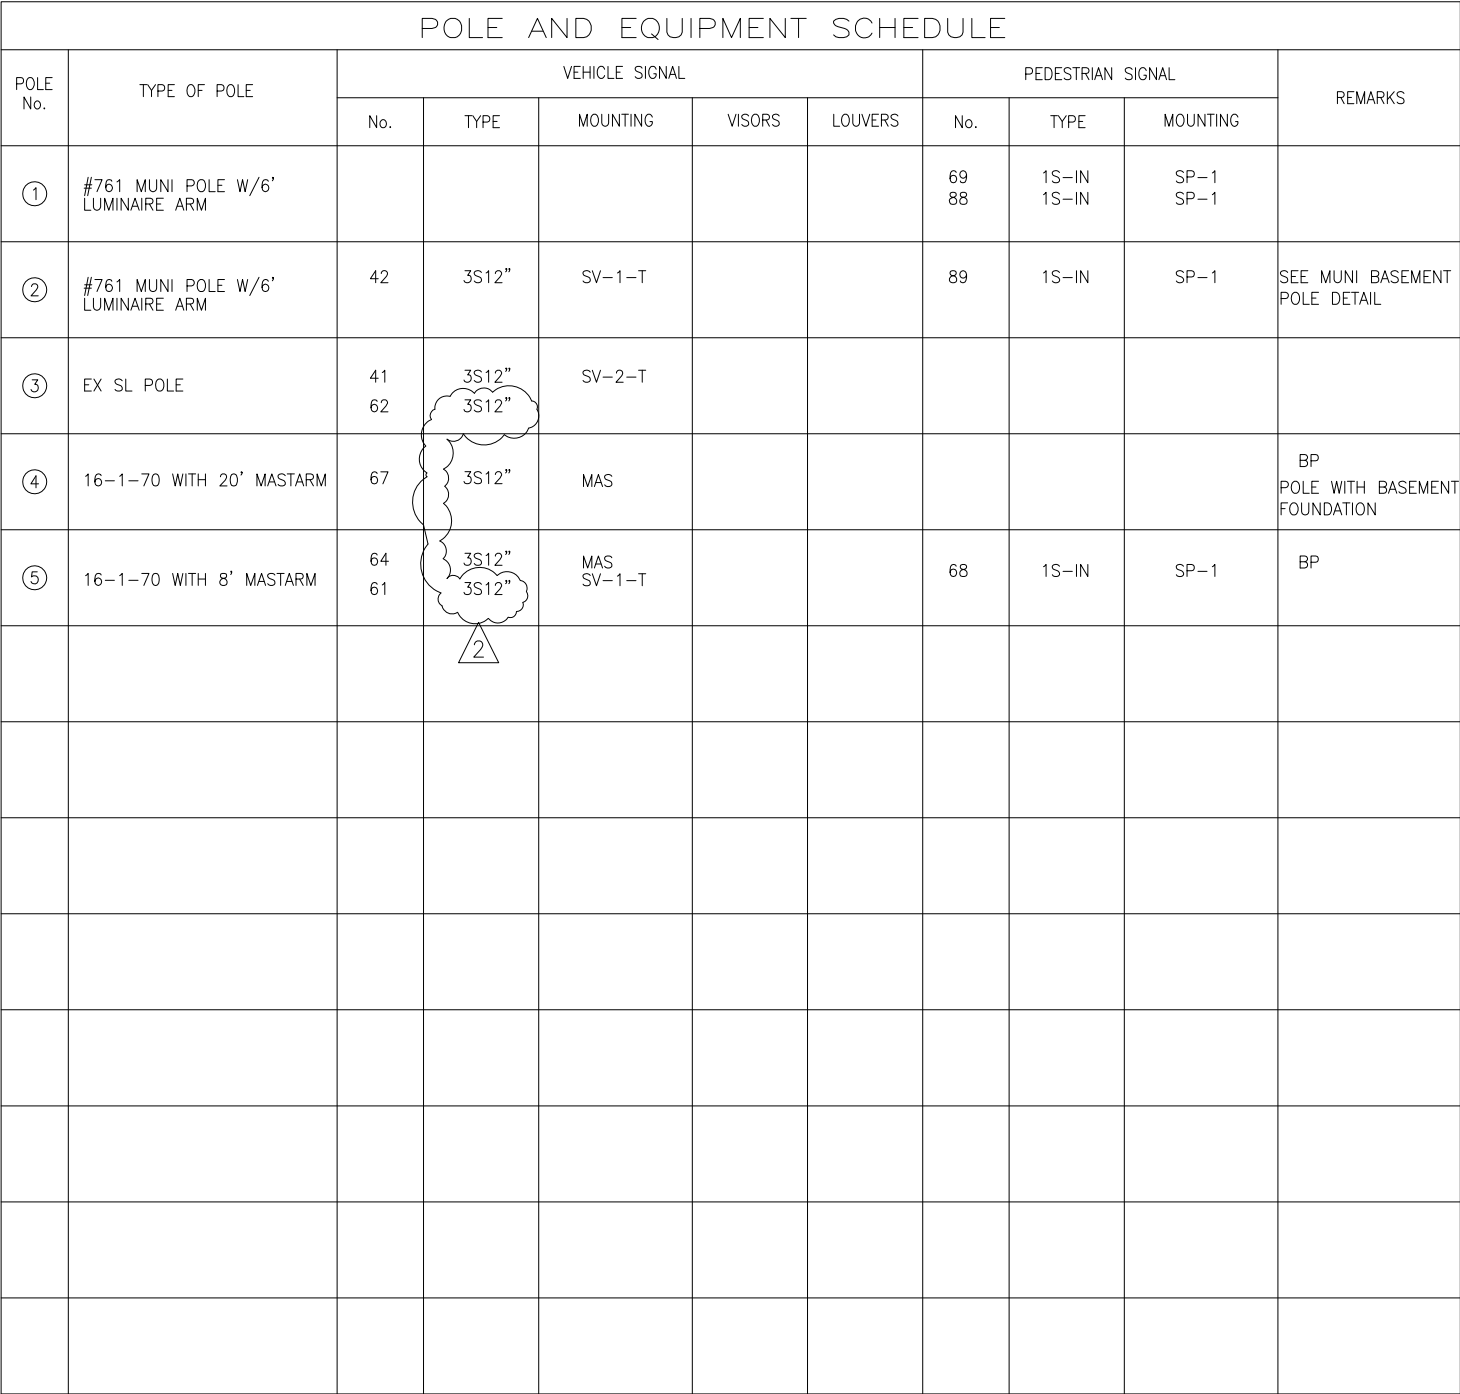

CNN NO. 24596000
REV. NO. 2