



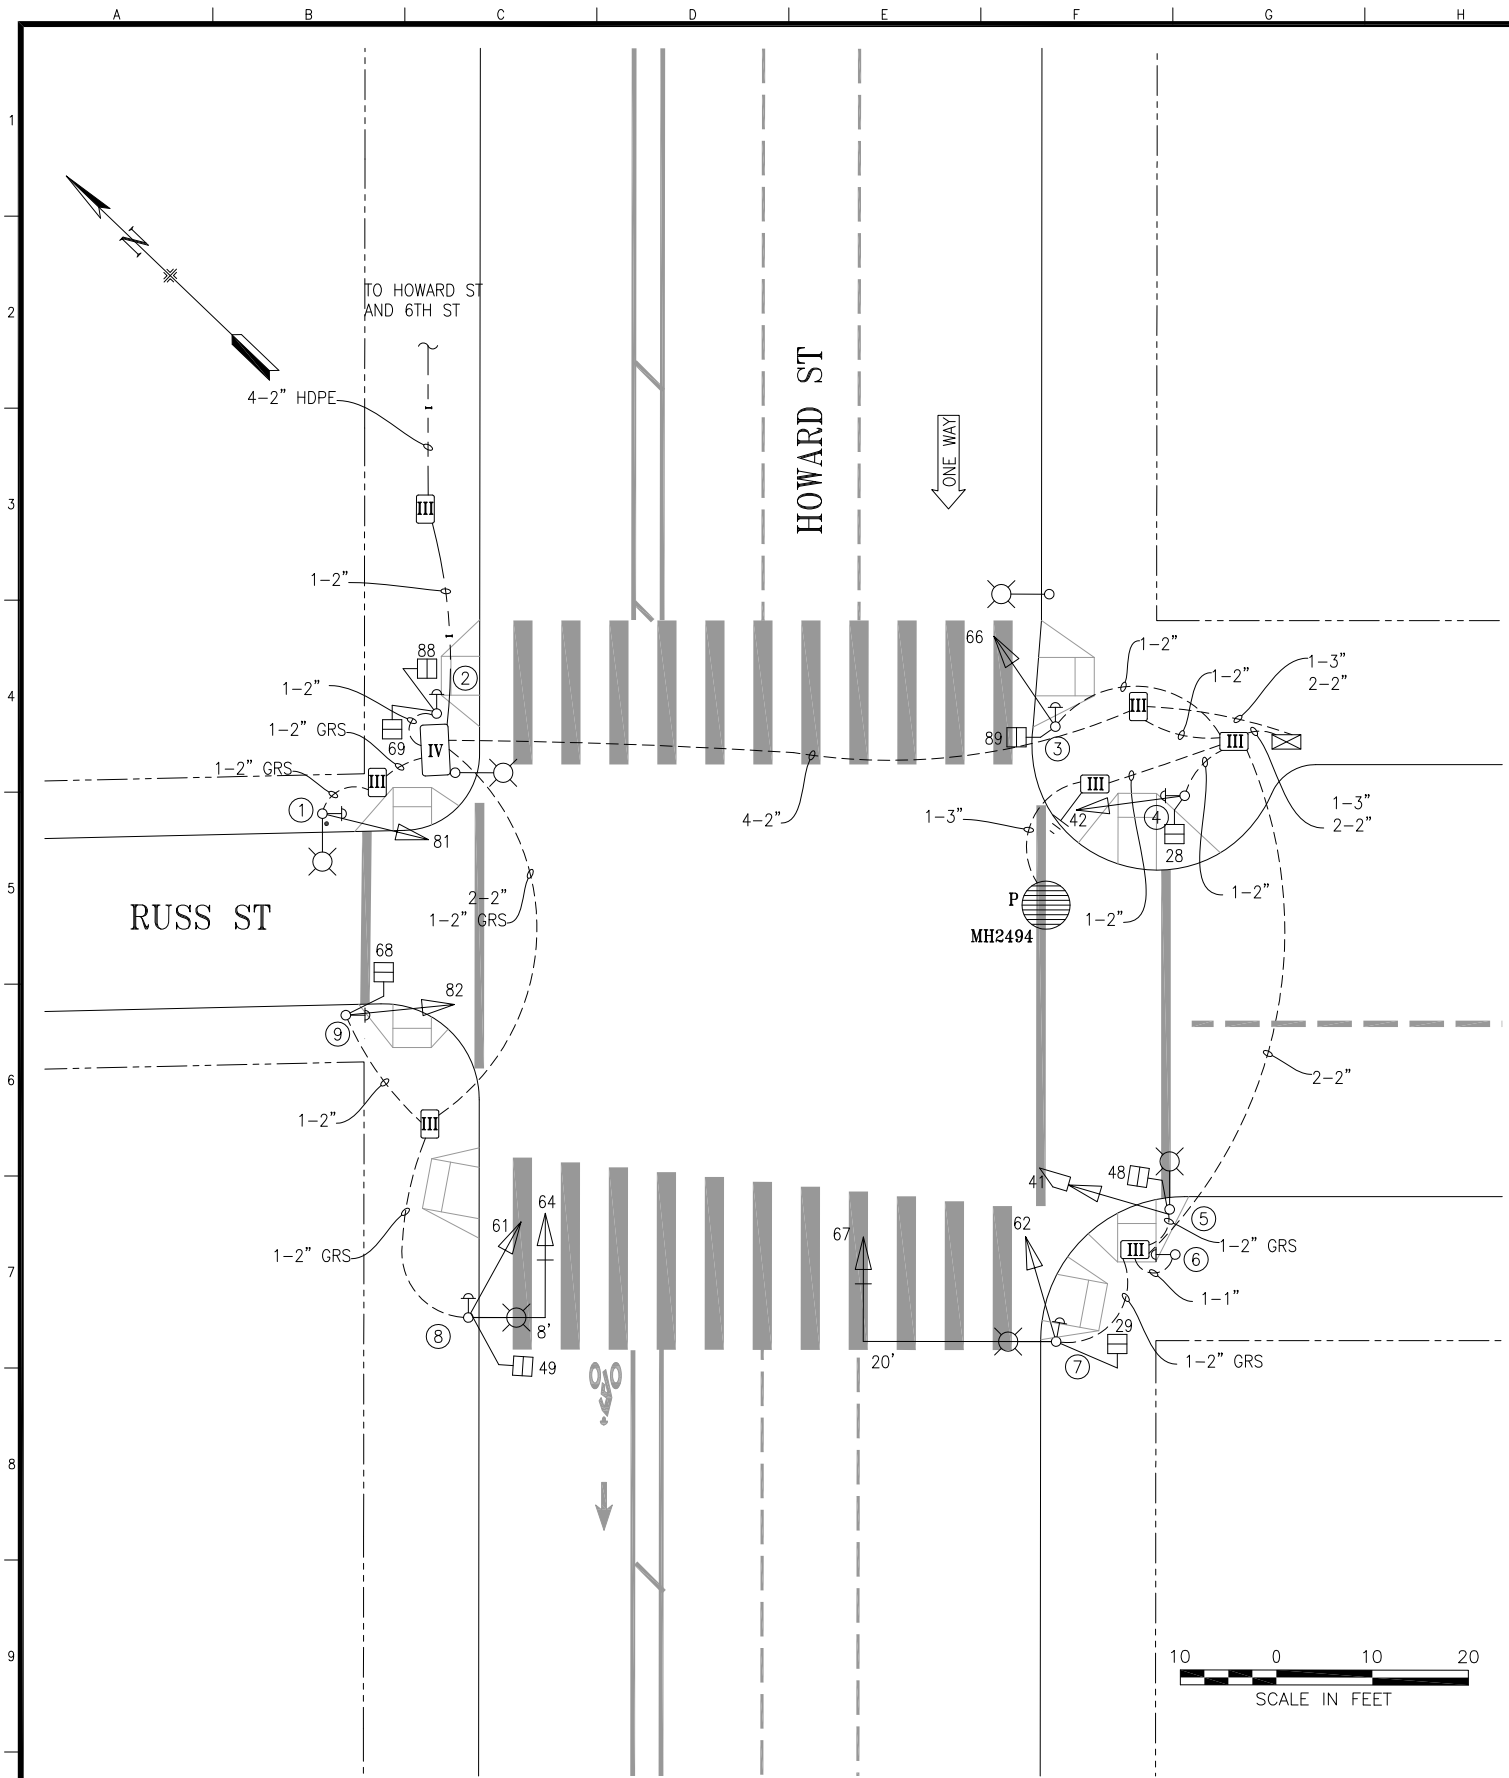

POLE AND EQUIPMENT SCHEDULE										
POLE No.	TYPE OF POLE	LUMINAIRE VOLTAGE/ WATTAGE	VEHICLE SIGNAL				PEDESTRIAN SIGNAL			REMARKS
			No.	TYPE	MOUNTING	VISORS	No.	TYPE	MOUNTING	
①	SL W/ 6' LUMINAIRE ARM	LED	81	3S12"	SV-1-T	T				APS-2W
②	1-A (7')						69 88	1S-COUNT 1S-COUNT	TP-2-T	APS-2W
③	1-A (10')		66	3S12"	TV-1-T	T	89	1S-COUNT	SP-1	APS-2W
④	1-A (10')		42	3S12"	TV-1-T	T	28	1S-COUNT	SP-1	APS-2W
⑤	SL W/ 6' LUMINAIRE ARM	LED	41	3S12"	SV-1-T	RA	48	1S-COUNT	SP-1	
⑥	PPB POLE									APS-2W
⑦	17-2-100 WITH 20' MAST ARM W/ 6' LUMINAIRE ARM	LED 120V/73W	62 67	3S12" 3S12"	SV-1-T MAS ①	T T	29	1S-COUNT	SP-1	APS-2W BACKPLATE FOR SIGNAL 67
⑧	17-2-100 WITH 20' MAST ARM W/ 6' LUMINAIRE ARM	LED 120V/73W	61 64	3S12" 3S12"	SV-1-T MAS ①	T T	49	1S-COUNT	SP-1-SF (12")	APS-2W BACKPLATE FOR SIGNAL 64
⑨	1-A (10')		82	3S12"	TV-1-T	T	68	1S-COUNT	SP-1-SF (22")	APS-2W

SHEET NOTES:
① PLUMBIZER MOUNTED BETWEEN YELLOW AND GREEN SECTIONS

INTERCONNECT WIRING DETAIL
NOT TO SCALE

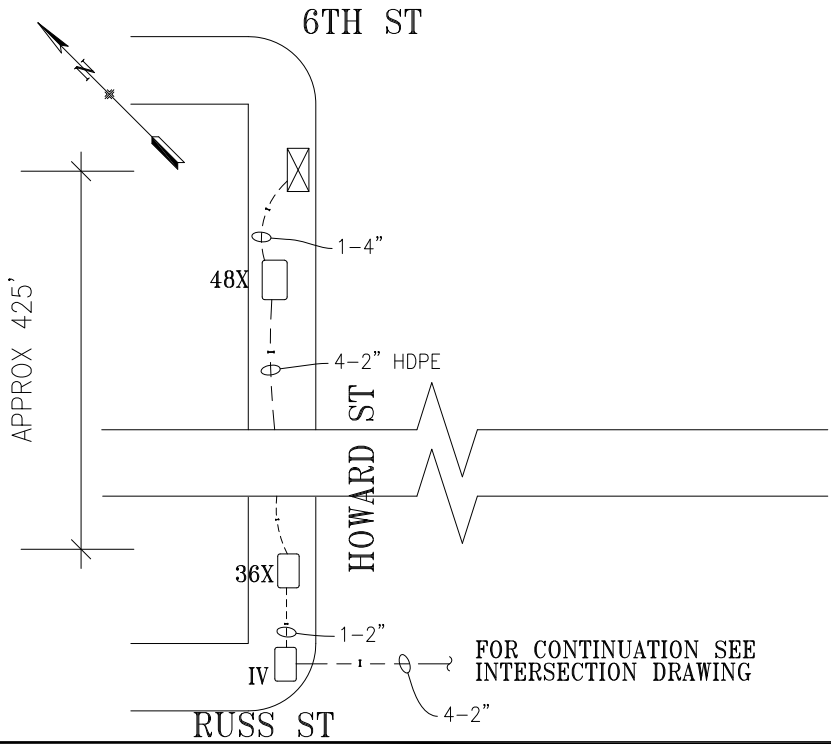

NO.		DATE	DESCRIPTION	BY	APP.
0		4/5/18	NEW SIGNAL ACTIVATED THROUGH #2772J	AScales	GDeLeon
TABLE OF REVISIONS CHECK WITH TRACING TO SEE IF YOU HAVE LATEST REVISION					

REFERENCE INFORMATION
& FILE NO. OF SURVEYS



SAN FRANCISCO MUNICIPAL TRANSPORTATION AGENCY
CITY AND COUNTY OF SAN FRANCISCO

DRAWN:	DATE:
AS	7/3/18
CHECKED:	DATE:
GD	8/3/18

SCALE:

AS SHOWN

SHEET OF SHEETS

1 OF 1

TRAFFIC SIGNAL INVENTORY DIAGRAM

HOWARD STREET AND RUSS STREET

CNN NO.

24287000

REV NO.

0