


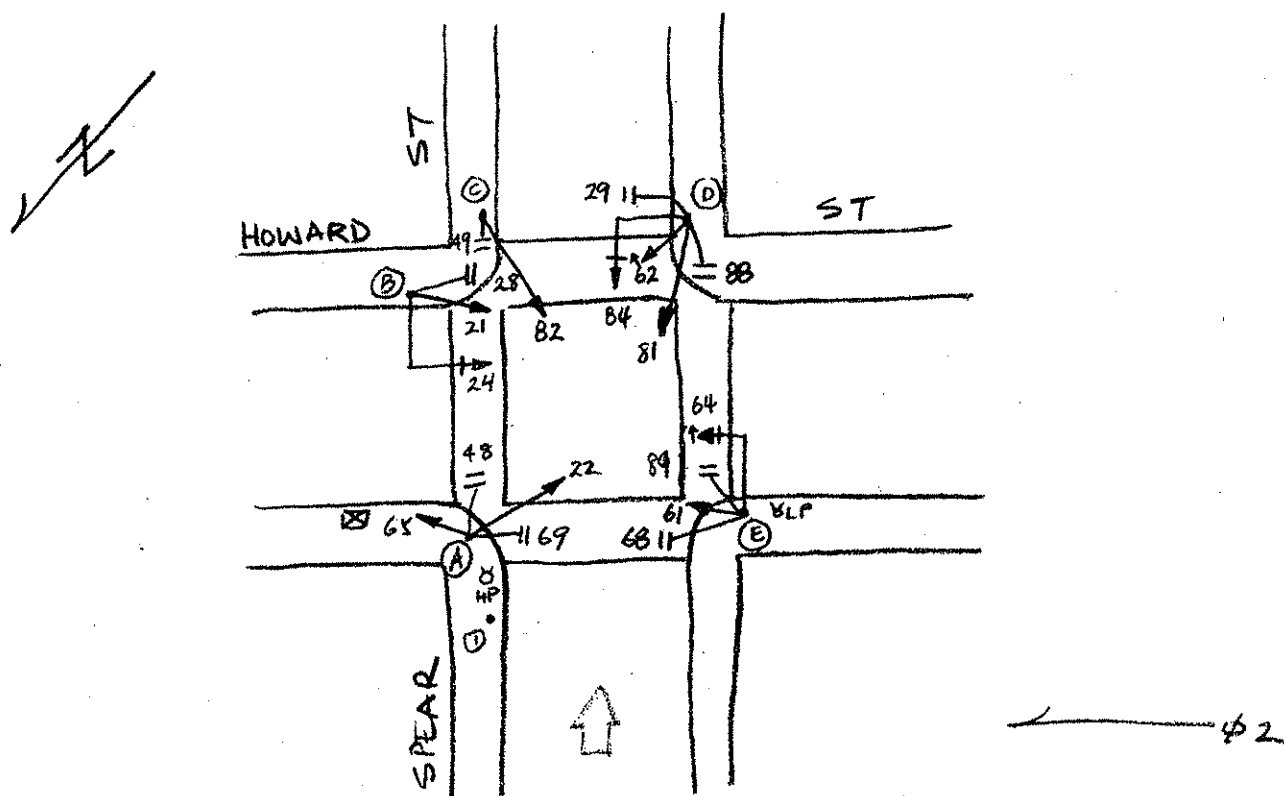


Per Field Check 8-4-99.

| POLE | FUNC. | MAT'L | SIGNAL NO. | MAKE | NO. OF SECT. | SIZE | VISOR                  | B.P. OR LOUVERS | MOUN'T | PED SIGNAL NO. | LEGEND | MESSAGE |       | MAKE | MOUN' |
|------|-------|-------|------------|------|--------------|------|------------------------|-----------------|--------|----------------|--------|---------|-------|------|-------|
|      |       |       |            |      |              |      |                        |                 |        |                |        | ELEMENT | COLOR |      |       |
| A    | S     | S     | 22         | ICC  | 3            | 8"   | T8"                    | NO              | T      | 69             | I      | IS-I    | O/W   | ICC  | S     |
| B    | S     | S     | 65         | ICC  | 3            | 8"   | T8"                    | NO              | T      | 48             | I      | IS-I    | O/W   | ICC  | S     |
| C    | S     | S     | 24         | ICC  | 3            | 12"  | T8"                    | BP              | A      | 28             | I      | IS-I    | O/W   | ICC  | S     |
| D    | S     | S     | 21         | ICC  | 3            | 8"   | T8"                    | NO              | S      | 49             | I      | IS-I    | O/W   | ICC  | S     |
| E    | S     | S     | 82         | CH   | 3            | 8"   | T8"                    | NO              | T      | 29             | I      | IS-I    | O/W   | ICC  | S     |
| I    | L     | S     | 84         | ICC  | 3            | 12"  | T8"                    | BP              | A      | 88             | I      | IS-I    | O/W   | ICC  | S     |
|      |       |       | 62         | 3M   | 4PV          | 12"  | RIG TIZ<br>441 NO V SW | NO              | S      | 89             | I      | IS-I    | O/W   | ICC  | S     |
|      |       |       | 81         | ICC  | 3            | 8"   | T8"                    | NO              | S      | 63             | I      | IS-I    | O/W   | ICC  | S     |
|      |       |       | 64         | ICC  | 4            | 12"  | RYG G                  | BP              | A      |                |        |         |       |      |       |
|      |       |       | 61         | ICC  | 3            | 8"   | T8"                    | NO.             | S      |                |        |         |       |      |       |
|      |       |       |            |      |              |      |                        |                 |        |                |        |         |       |      |       |
|      |       |       |            |      |              |      |                        |                 |        |                |        |         |       |      |       |
CONTROLLER CABINET SIZE : ORDINARY BASE CABINET: YES

COMMENTS: Contract 49. New Signal.

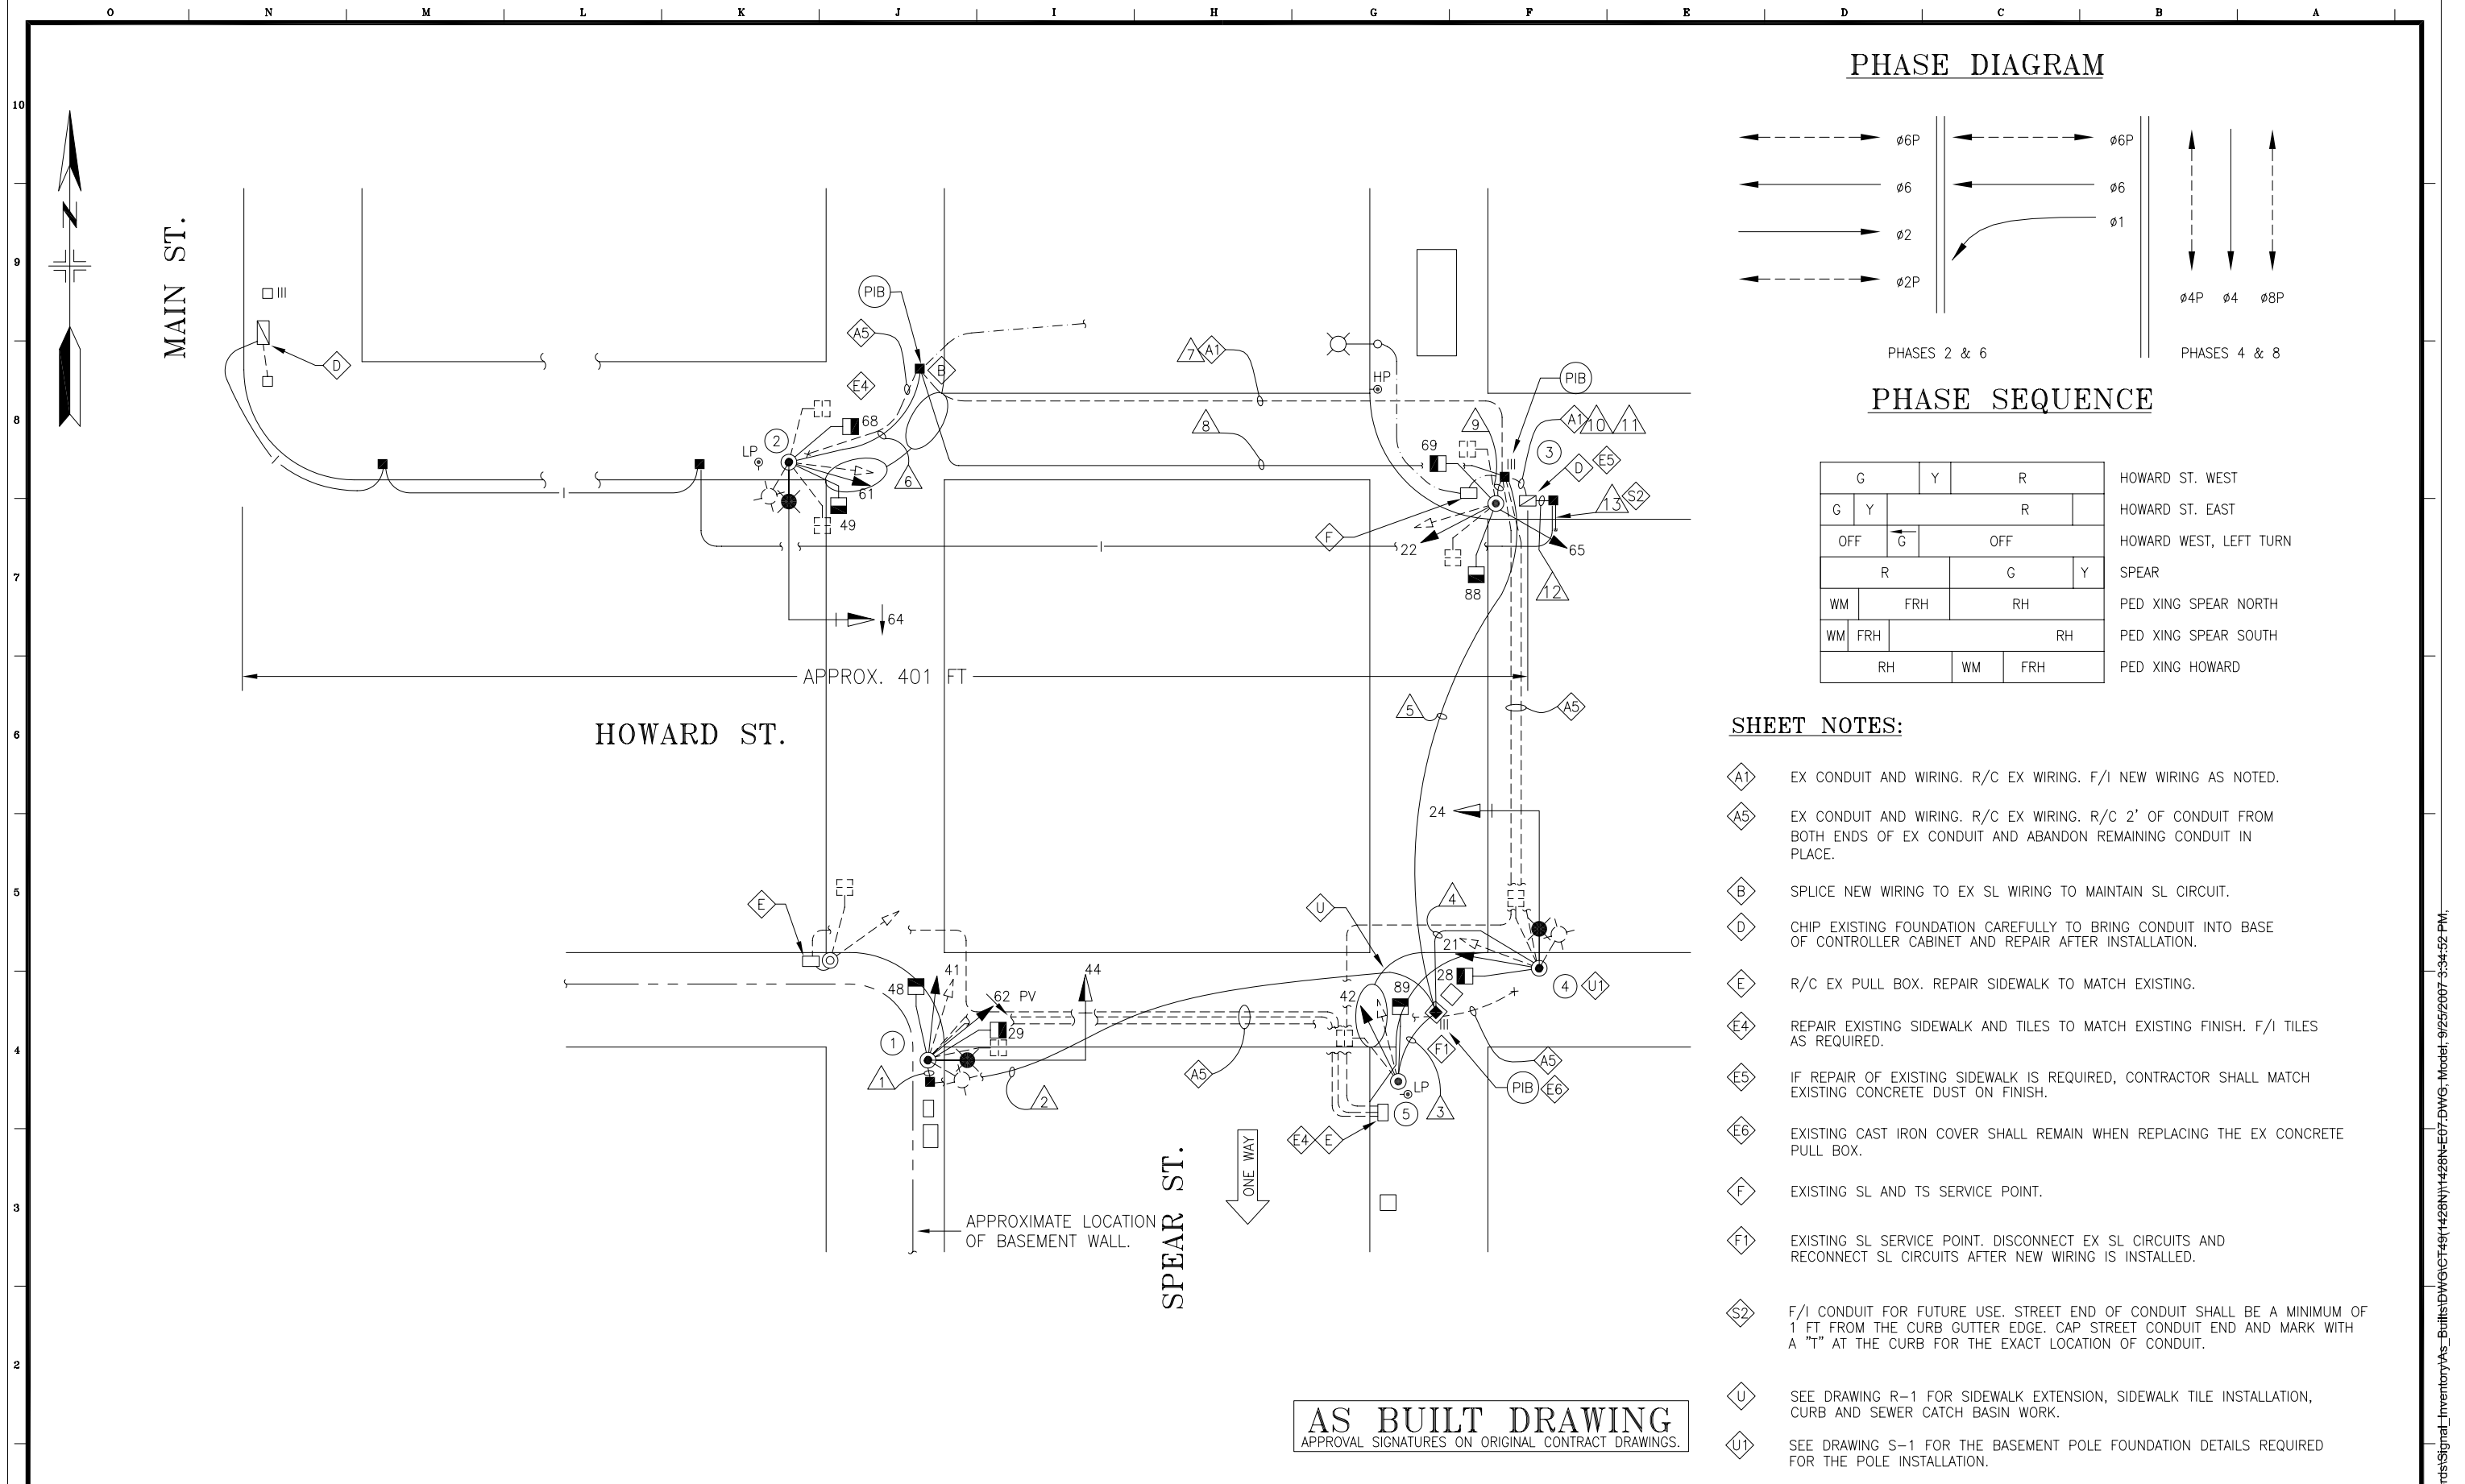

| |
|---|
| 1 | |
|---|

|                             |           |    |    |   |   |    |    |   |    |    |    |    |    |    |  |  |  |  |  |  |
|-----------------------------|-----------|----|----|---|---|----|----|---|----|----|----|----|----|----|--|--|--|--|--|--|
| CONDUIT AND WIRING SCHEDULE |           |    |    |   |   |    |    |   |    |    |    |    |    |    |  |  |  |  |  |  |
| CONDUIT RUN NUMBER          |           | 1  | 2  | 3 | 4 | 5  | 6  | 7 | 8  | 9  | 10 | 11 | 12 | 13 |  |  |  |  |  |  |
| CONDUIT SIZE (INCH)         |           | 2  | 2  | 2 | 2 | 2  | 2  | 2 | 2  | 2  | 2  | 2  | 2  |    |  |  |  |  |  |  |
| NOTES                       |           |    |    |   |   |    | EX |   |    |    | EX | EX |    | R  |  |  |  |  |  |  |
| WIRING (F/I)                | #14 WIRES |    |    |   |   |    |    |   |    |    |    |    |    |    |  |  |  |  |  |  |
|                             | SIGNAL 29 | 2  | 2  |   |   | 2  |    |   |    |    | 2  |    |    |    |  |  |  |  |  |  |
|                             | SIGNAL 62 | 4  | 4  |   |   | 4  |    |   |    |    | 4  |    |    |    |  |  |  |  |  |  |
|                             | SIGNAL 41 | 3  | 3  |   |   | 3  |    |   |    |    | 3  |    |    |    |  |  |  |  |  |  |
|                             | SIGNAL 44 | 3  | 3  |   |   | 3  |    |   |    |    | 3  |    |    |    |  |  |  |  |  |  |
|                             | SIGNAL 48 | 2  | 2  |   |   | 2  |    |   |    |    | 2  |    |    |    |  |  |  |  |  |  |
|                             | SIGNAL 42 |    |    | 3 |   | 3  |    |   |    |    | 3  |    |    |    |  |  |  |  |  |  |
|                             | SIGNAL 89 |    |    | 2 |   | 2  |    |   |    |    | 2  |    |    |    |  |  |  |  |  |  |
|                             | SIGNAL 21 |    |    |   | 3 | 3  |    |   |    |    | 3  |    |    |    |  |  |  |  |  |  |
|                             | SIGNAL 24 |    |    |   | 3 | 3  |    |   |    |    | 3  |    |    |    |  |  |  |  |  |  |
|                             | SIGNAL 28 |    |    |   | 2 | 2  |    |   |    |    | 2  |    |    |    |  |  |  |  |  |  |
|                             | SIGNAL 49 |    |    |   |   |    | 2  |   | 2  |    |    | 2  |    |    |  |  |  |  |  |  |
|                             | SIGNAL 61 |    |    |   |   |    | 3  |   | 3  |    |    | 3  |    |    |  |  |  |  |  |  |
|                             | SIGNAL 64 |    |    |   |   |    | 4  |   | 4  |    |    | 4  |    |    |  |  |  |  |  |  |
|                             | SIGNAL 68 |    |    |   |   |    | 2  |   | 2  |    |    | 2  |    |    |  |  |  |  |  |  |
|                             | SIGNAL 22 |    |    |   |   |    |    |   |    | 3  |    | 3  |    |    |  |  |  |  |  |  |
|                             | SIGNAL 65 |    |    |   |   |    |    |   |    |    | 3  |    | 3  |    |  |  |  |  |  |  |
|                             | SIGNAL 69 |    |    |   |   |    |    |   |    |    | 2  |    | 2  |    |  |  |  |  |  |  |
|                             | SIGNAL 88 |    |    |   |   |    |    |   |    |    | 2  |    | 2  |    |  |  |  |  |  |  |
|                             | SPARE     |    |    | 3 |   |    | 3  |   |    | 3  |    | 3  | 3  |    |  |  |  |  |  |  |
| TOTAL #14 WIRES             |           | 14 | 17 | 5 | 8 | 30 | 11 |   | 14 | 10 | 30 | 24 |    |    |  |  |  |  |  |  |
| #10 WIRES NEUTRAL           |           | 3  | 1  | 2 | 3 | 2  | 3  |   | 1  | 2  | 2  | 2  |    |    |  |  |  |  |  |  |
| #8 WIRES (120V SERVICE)     |           |    |    |   |   |    |    |   |    |    |    |    |    |    |  |  |  |  |  |  |
| ST. LIGHT #8 WIRE           |           | 2  | 2  |   | 2 |    | 2  | 2 |    |    |    |    |    |    |  |  |  |  |  |  |
| 12 CONDUCTOR CABLE          |           |    |    |   |   |    |    |   |    |    |    |    | 1  |    |  |  |  |  |  |  |
| 1/4" PULL ROPE              |           |    | 1  |   |   | 1  |    |   | 1  |    |    | 1  |    |    |  |  |  |  |  |  |
|                             |           |    |    |   |   |    |    |   |    |    |    |    |    |    |  |  |  |  |  |  |

| POLE AND EQUIPMENT SCHEDULE |                                                 |                |                             |                   |                   |                |                |                 |       |                     |
|-----------------------------|-------------------------------------------------|----------------|-----------------------------|-------------------|-------------------|----------------|----------------|-----------------|-------|---------------------|
| POLE No.                    | TYPE OF POLE                                    | VEHICLE SIGNAL |                             |                   | PEDESTRIAN SIGNAL |                |                | LUMINAIRE (HPS) |       | REMARKS             |
|                             |                                                 | No.            | TYPE                        | MOUNTING (F/I)    | No.               | TYPE           | MOUNTING (F/I) | VOLTAGE         | WATTS |                     |
| 1                           | 17-1-70<br>20' MAST ARM AND<br>6' LUMINAIRE ARM | 41<br>62<br>44 | 3S8"<br>PV4S12"-LA<br>3S12" | SV-2-T<br><br>MAS | 48<br>29          | IS-IN<br>IS-IN | SP-1(2)        | 120             | 200   | B2<br><br>BACKPLATE |
| 2                           | 17-1-70<br>20' MAST ARM AND<br>6' LUMINAIRE ARM | 61<br>64       | 3S8"<br>4S12"-LA            | SV-1-T<br><br>MAS | 49<br>68          | IS-IN<br>IS-IN | SP-1(2)        | 120             | 200   | B2<br><br>BACKPLATE |
| 3                           | 1-A (10')                                       | 22<br>65       | 3S8"<br>3S8"                | TV-2-T            | 69<br>88          | IS-IN<br>IS-IN | SP-1(2)        |                 |       |                     |
| 4                           | 17-1-70<br>20' MAST ARM AND<br>6' LUMINAIRE ARM | 21<br>24       | 3S8"<br>3S12"               | SV-1-T<br><br>MAS | 28                | IS-IN          | SP-1           | 120             | 200   | B2<br><br>BACKPLATE |
| 5                           | 1-A (10')                                       | 42             | 3S8"                        | TV-1              | 89                | IS-IN          | SP-1           |                 |       |                     |

B2

R

F/I

SHEET NOTES:

F/I WITH INTEGRAL BALLAST AND PHOTOELECTRIC CONTROL.  
F/I FUSE AND FUSE HOLDER PER SFDPWSP #49,092.

THIS CONDUIT IS FOR FUTURE INTERCONNECT CABLE SYSTEM.  
TERMINATE AND CAP CONDUIT 1 1/2 FT FROM CURB AT THE ROAD SIDE. MARK EXACT CONDUIT LOCATION WITH A "T" AT THE CURB.

AS BUILT DRAWING

APPROVAL SIGNATURES ON ORIGINAL CONTRACT DRAWINGS.

|                                                       |  |-------------------------------------------------------|--|----------|--|-------------|--|---------------------------------------------------|--|--------------------------------------------------------------------------------------|--|-----------------------------------------------------------------------------------------|--|----------------------------------------------------------------------------------------------------------|--|------------------------------------------------------------------------------------|--|---------------------------------------------------|--|-----------------------------------------------------------------------------------------------|--|-----------------------------------------------------------------------------------------|--|
|                                                       |  |          |  |             |  | REFERENCE<br>INFORMATION & FILE<br>No. OF SURVEYS |  |  |  | BUREAU OF ENGINEERING<br>DEPARTMENT OF PUBLIC WORKS<br>CITY AND COUNTY OF SAN FRANCISCO |  | DESIGNED: DVS/SB 4/98<br>DATE: 4/98<br>DRAWN: EF/SB 4/98<br>DATE: 4/98<br>CHECKED: CF 4/98<br>DATE: 4/98 |  | APPROVED<br>SECTION MANAGER DATE:<br>DIVISION MANAGER DATE:<br>CITY ENGINEER DATE: |  | SCALE:<br>1"=10'-0"<br>SHEET OF SHEETS<br>9 OF 18 |  | VARIOUS LOCATIONS TRAFFIC SIGNAL WORK<br>CONTRACT 49<br>HOWARD AND SPEAR STREETS<br>SCHEDULES |  | SPECIFICATION NO.<br>1428N<br>DRAWING NO.<br>E-8<br>FILE NO.<br>69,369<br>REV. NO.<br>0 |  |
| 6/2001                                                |  | AS BUILT |  | JP SL       |  |                                                   |  |                                                                                      |  |                                                                                         |  |                                                                                                          |  |                                                                                    |  |                                                   |  |                                                                                               |  |                                                                                         |  |
| NO.                                                   |  | DATE     |  | DESCRIPTION |  | BY                                                |  | APP.                                                                                 |  |                                                                                         |  |                                                                                                          |  |                                                                                    |  |                                                   |  |                                                                                               |  |                                                                                         |  |
| CHECK WITH TRACING TO SEE IF YOU HAVE LATEST REVISION |  |          