


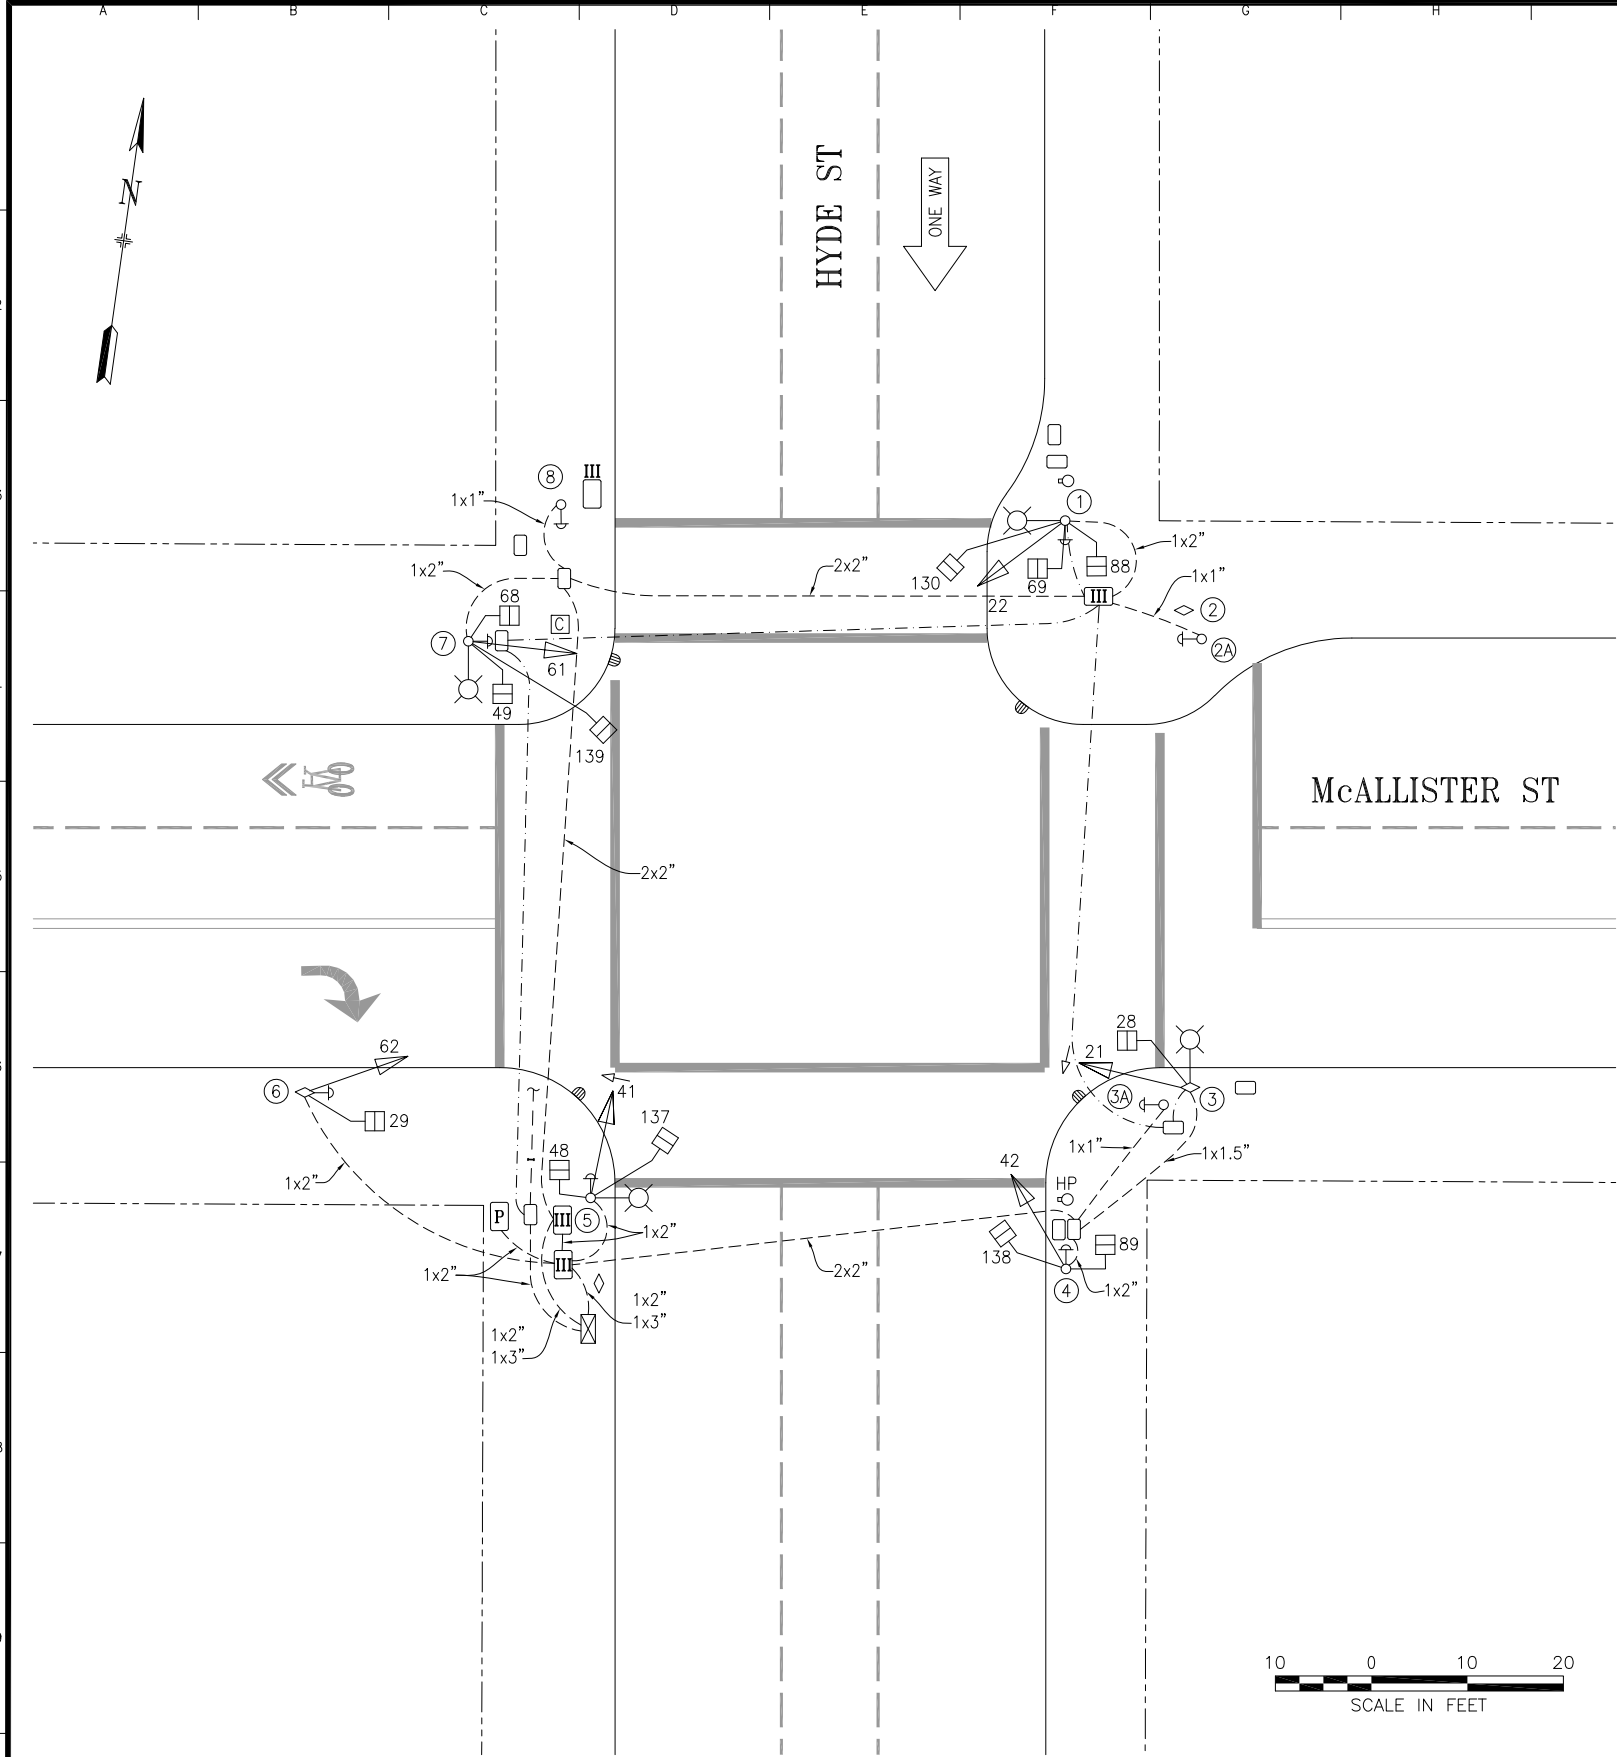

POLE AND EQUIPMENT SCHEDULE											
POLE No.	TYPE OF POLE	LUMINAIRE VOLTAGE/ WATTAGE	VEHICLE SIGNAL					PEDESTRIAN SIGNAL			REMARKS
			No.	TYPE	MOUNTING	VISORS	LOUVERS	No.	TYPE	MOUNTING	
①	EX SL		22	3S12"	SV-1-T	T		69 88 130	1S-COUNT 1S-COUNT 1S-COUNT	SP-3 (CUSTOM)	APS-4W
②	EX MUNI										
2A	PPB POST										APS-4W
③	EX SL MUNI		21	4S12"GRA	SV-1-T	T		28	1S-COUNT	SP-1-T	EXTERNAL CONDUIT
3A	PPB POST										APS-4W
④	1-A (10')		42	3S12"	TV-1-T	T		89 138	1S-COUNT 1S-COUNT	SP-2 (CUSTOM)	APS-4W
⑤	EX SL		41	4S12"GRA	SV-1-T	T		48 137	1S-COUNT 1S-COUNT	SP-2 (CUSTOM)	APS-4W TSP EQUIPMENT
⑥	EX MUNI		62	3S12"	SV-1-T	T		29	1S-COUNT	SP-1-T	EXTERNAL CONDUIT APS-4W
⑦	EX SL		61	3S12"	TV-1-T	T		49 68 139	1S-COUNT 1S-COUNT 1S-COUNT	SP-3 (CUSTOM)	APS-4W
⑧	PPB POST										APS-4W

5	8/6/21	NOTE PPB POSTS, APS BUTTONS & TSP EQUIPMENT PER FIELD	D. YEUNG	G. DELEON
4	5/12/21	ADD DIAGONAL PED SIGNALS PER SRC 2021-056	D. YEUNG	B. WOO
3	10/19/19	SIGNALS #21, 41 REPLACED BY 4S12"GRA PER SRC 2019-351	J. HORNOSTEL	G. DELEON
2	5/14/17	SIGNALS #41,42,61,62 UPGRADED TO 12" PER SRC 2017-003	N. KOBAYASHI	G. DELEON
1	8/4/11	WB McALLISTER CONVERTED TO 2-WAY, SIGNAL #21 & #22 TO 12"	N. KOBAYASHI	G. DELEON
0	4/5/05	CONVERTED FROM CONTRACT PLANS	N. KOBAYASHI	G. DELEON
NO.	DATE	DESCRIPTION	BY	APPROVED

TABLE OF REVISIONS
CHECKOUT DRAWING THROUGH THE SID CUSTODIAN FOR THE LATEST REVISION



SFMTA

DRAWN BY: N. KOBAYASHI	DATE: 12/2016
CHECKED BY: G. DELEON	DATE: 12/2016

SCALE AS SHOWN
SHEET OF SHEETS 01 OF 01

TRAFFIC SIGNAL INVENTORY DIAGRAM
HYDE STREET AND McALLISTER STREET

CNN NO: 24333000
REV NO: 5