


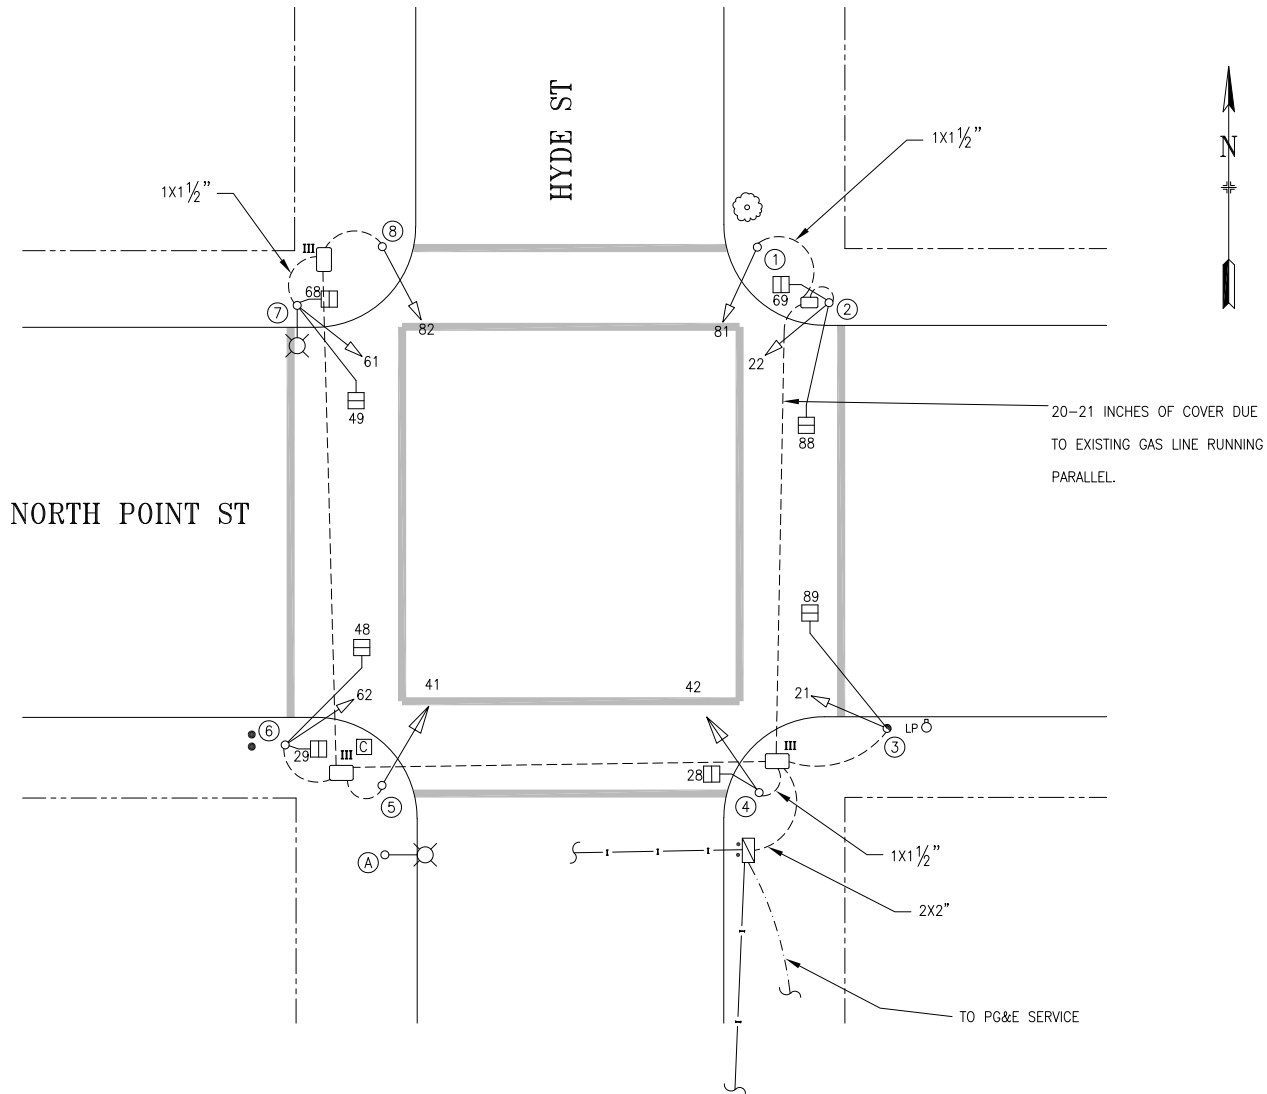

NOTE:
CABINET FOUNDATION TYPE: G



POLE AND EQUIPMENT SCHEDULE										
POLE No.	TYPE OF POLE	VEHICLE SIGNAL					PEDESTRIAN SIGNAL			REMARKS
		No.	TYPE	MOUNTING	VISORS	LOUVERS	No.	TYPE	MOUNTING	
①	MUNI	81	3S8"	SV-1-T	T					
②	1-A (10')	22	3S8"	TV-1	T		69 88	1S-COUNT 1S-COUNT	SP-1 SP-1	
③	UTILITY/SL	21	3S8"	SV-1-T (MODIFIED)	T		89	1S-COUNT	SP-1-T (MODIFIED)	
④	MUNI	42	3S12"	SV-1-T	T		28	1S-COUNT	SP-1	
⑤	1-A (10')	41	3S12"	TV-1	T					
⑥	1-A (10')	62	3S8"	TV-1	T		29 48	1S-COUNT 1S-COUNT	SP-1 SP-1	
⑦	SL/MUNI	61	3S8"	SV-1-T	T		49 68	1S-COUNT 1S-COUNT	SP-1 SP-1	
⑧	1-A (10')	82	3S8"	TV-1	T					
A	SL/MUNI									

NO.	DATE	DESCRIPTION	BY	APP.
3	4/30/21	UPGRADE 42 TO 3S12" PER SRC 2021-070	AL	ET
2	04/12/11	PER FIELD, UPDATED 41 TO 3S12"		
1	07/97	INSTALLED PED SIGNALS CROSSING HYDE	ET	HQ
		BAY AND NORTH POINT PROJECT JOB#1094N	DVC	RO
TABLE OF REVISIONS				
CHECK WITH TRACING TO SEE IF YOU HAVE LATEST REVISION				

REFERENCE INFORMATION & FILE NO. OF SURVEYS
--



SAN FRANCISCO MUNICIPAL TRANSPORTATION AGENCY

CITY AND COUNTY OF SAN FRANCISCO

DRAWN:	DATE:
CHECKED:	DATE:

DVC	8/29/01
-----	---------

SCALE:
1" = 20'
SHEET OF SHEETS
1 OF 1

TRAFFIC SIGNAL INVENTORY DIAGRAM
HYDE ST & NORTH POINT ST

CNN NO.
25574000
REV NO.
3