


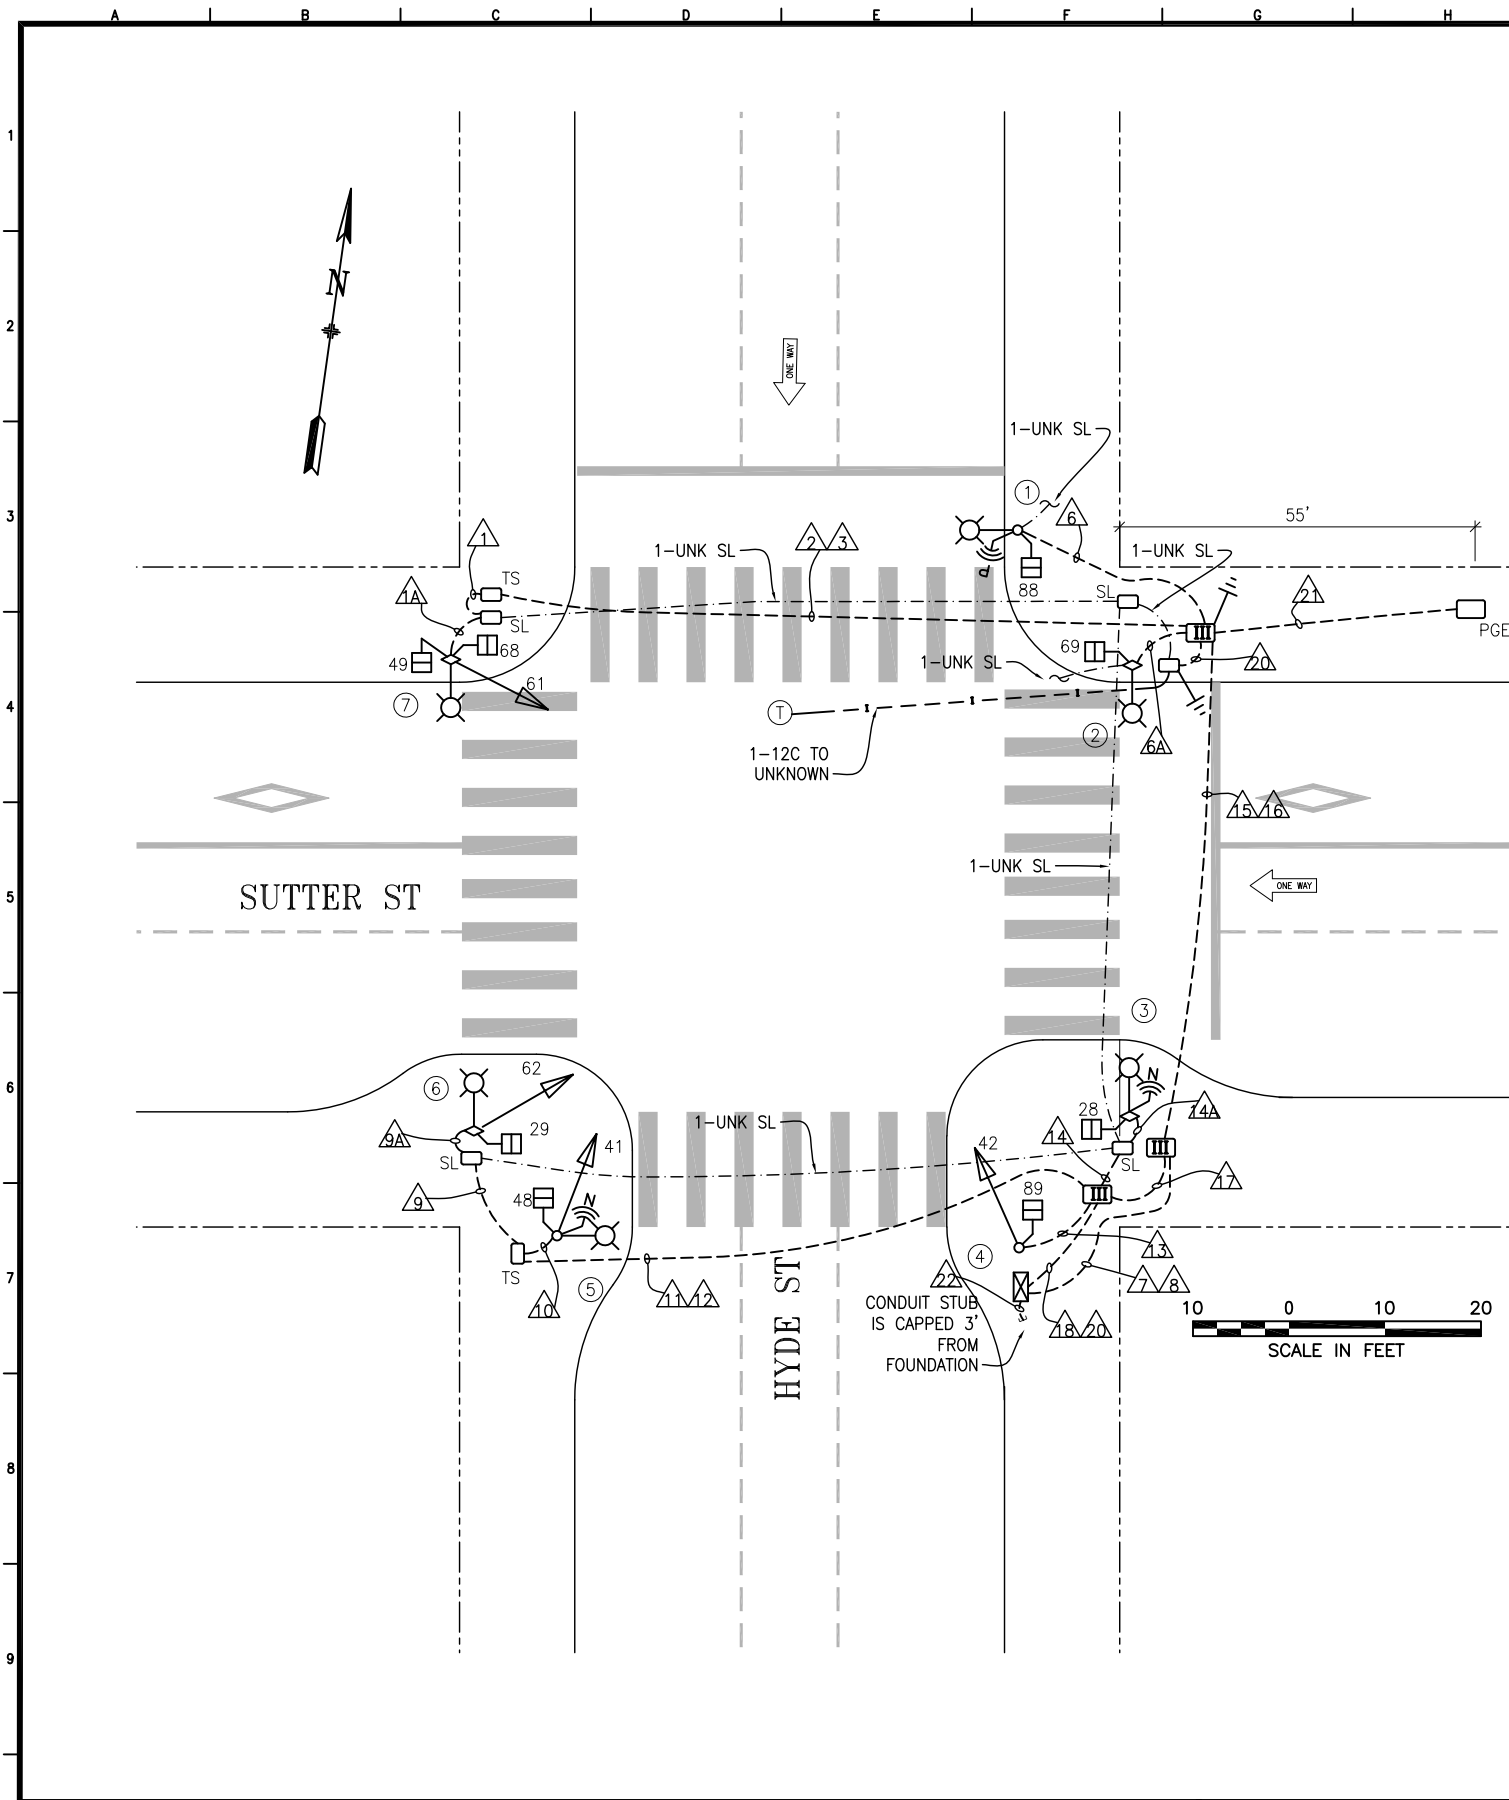

POLE AND EQUIPMENT SCHEDULE										
POLE No.	TYPE OF POLE	VEHICLE SIGNAL					PEDESTRIAN SIGNAL			REMARKS
		No.	TYPE	MOUNTING	VISORS	LOUVERS/BP	No.	TYPE	MOUNTING	
①	STREETLIGHT						88	1S-COUNT	SP-1	TSP RADIO
②	ORNAMENTAL MUNI FEEDER POLE W/ LUMINAIRE						69	1S-COUNT	SP-1	
③	ORNAMENTAL MUNI POLE W/ LUMINAIRE						28	1S-COUNT	SP-1	NETWORK RADIO
④	1-A (10')	42	3S12"	TV-1-T	T		89	1S-COUNT	SP-1	
⑤	STREETLIGHT	41	3S12"	SV-1-T	T		48	1S-COUNT	SP-1	NETWORK RADIO
⑥	ORNAMENTAL MUNI POLE W/ LUMINAIRE	62	3S12"	SV-1-T	T		29	1S-COUNT	SP-1	
⑦	ORNAMENTAL MUNI POLE W/ LUMINAIRE	61	3S12"	SV-1-T	T		49 68	1S-COUNT 1S-COUNT	SP-1-SF(12") SP-1(22")	

Δ	6/9/23	PER SRC 2023-043: UPGRADE ALL 4 SIGNALS FROM 8 TO 12-INCH	D. YEUNG	G. DE LEON	
Δ	2/9/23	UPDATE PER FIELD - ADD TSP AND NETWORK RADIOS	D. YEUNG	G. DE LEON	
Δ	3/23/05	CONVERTED FROM CONTRACT 0480J AS-BUILT	D. YEUNG	G. DE LEON	
NO.	DATE	DESCRIPTION	BY	APPROVED	
TABLE OF REVISIONS					
CHECKOUT DRAWING THROUGH THE SID CUSTODIAN FOR THE LATEST REVISION					



SFMTA

DRAWN BY: D. YEUNG	DATE: FEB 2023	SCALE AS SHOWN	TRAFFIC SIGNAL INVENTORY DIAGRAM	CNN NO: 25163000
		SHEET OF SHEETS		REV NO:
		1 OF 2	HYDE ST AND SUTTER ST	2

