


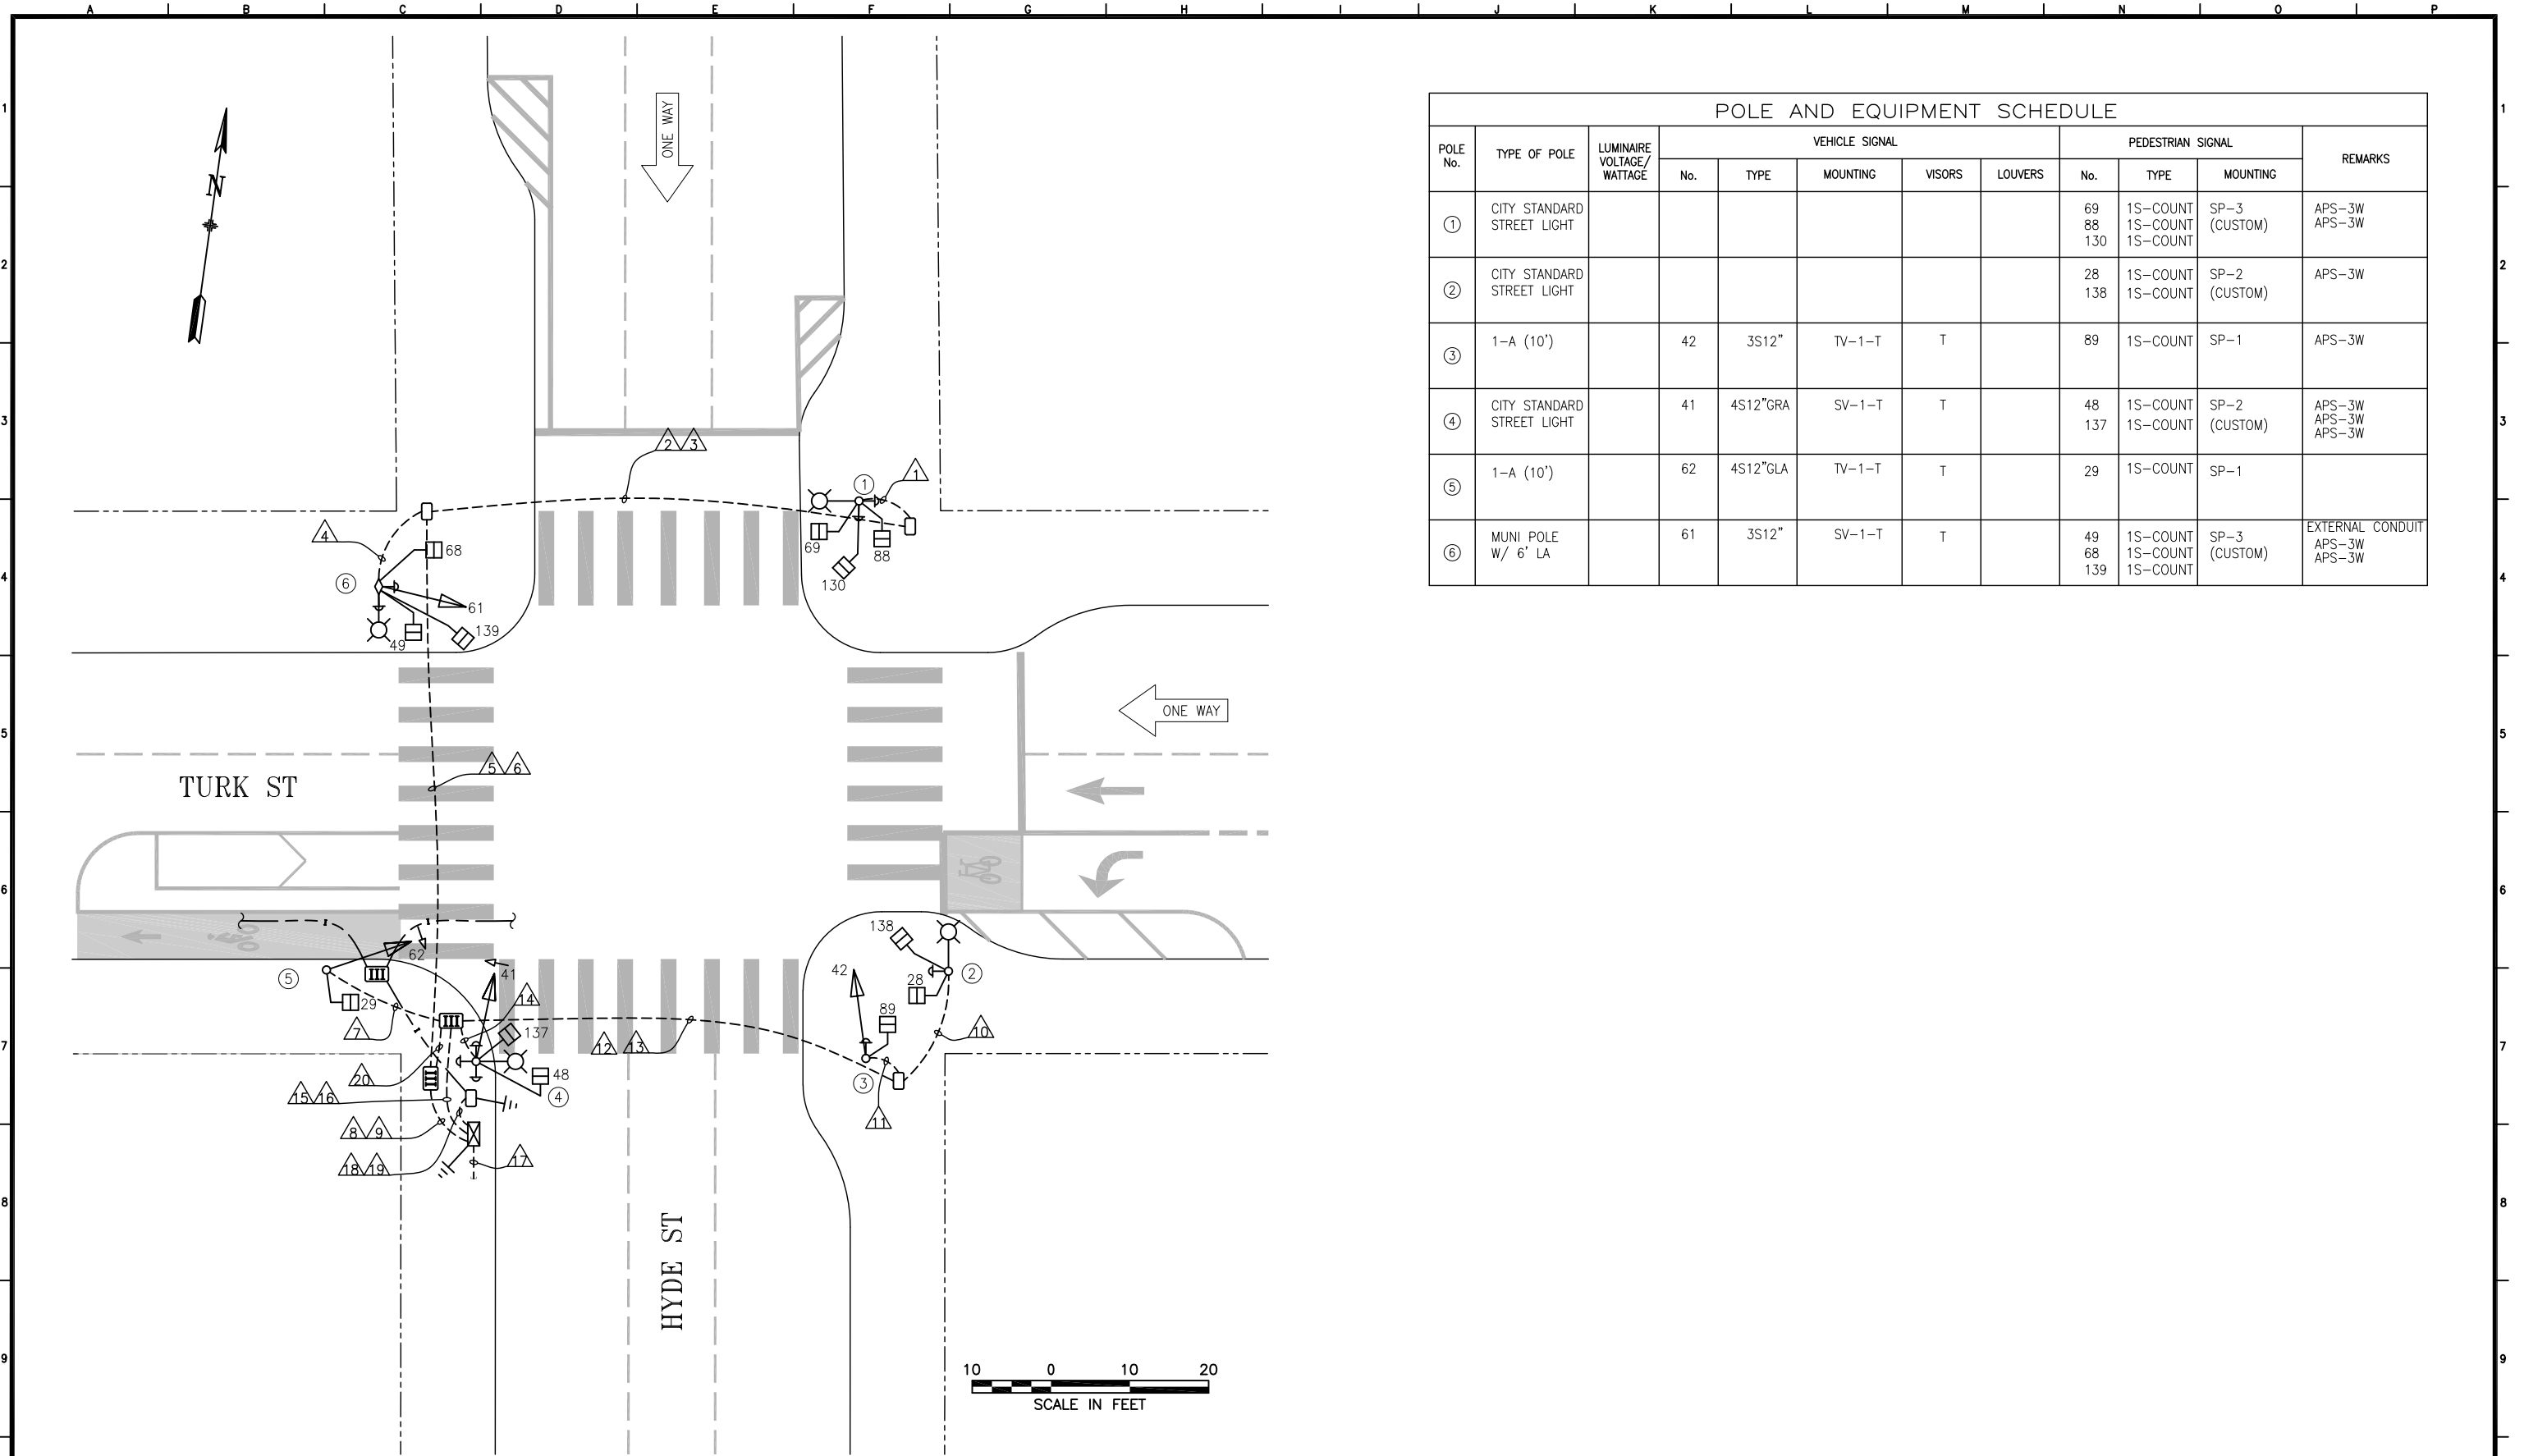

| POLE AND EQUIPMENT SCHEDULE |                            |                           |                |          |          |        |         |                   |                                  |                  |                                      |
|-----------------------------|----------------------------|---------------------------|----------------|----------|----------|--------|---------|-------------------|----------------------------------|------------------|--------------------------------------|
| POLE No.                    | TYPE OF POLE               | LUMINAIRE VOLTAGE/WATTAGE | VEHICLE SIGNAL |          |          |        |         | PEDESTRIAN SIGNAL |                                  |                  | REMARKS                              |
|                             |                            |                           | No.            | TYPE     | MOUNTING | VISORS | LOUVERS | No.               | TYPE                             | MOUNTING         |                                      |
| ①                           | CITY STANDARD STREET LIGHT |                           |                |          |          |        |         | 69<br>88<br>130   | 1S-COUNT<br>1S-COUNT<br>1S-COUNT | SP-3<br>(CUSTOM) | APS-3W<br>APS-3W                     |
| ②                           | CITY STANDARD STREET LIGHT |                           |                |          |          |        |         | 28<br>138         | 1S-COUNT<br>1S-COUNT             | SP-2<br>(CUSTOM) | APS-3W                               |
| ③                           | 1-A (10')                  |                           | 42             | 3S12"    | TV-1-T   | T      |         | 89                | 1S-COUNT                         | SP-1             | APS-3W                               |
| ④                           | CITY STANDARD STREET LIGHT |                           | 41             | 4S12"GRA | SV-1-T   | T      |         | 48<br>137         | 1S-COUNT<br>1S-COUNT             | SP-2<br>(CUSTOM) | APS-3W<br>APS-3W<br>APS-3W           |
| ⑤                           | 1-A (10')                  |                           | 62             | 4S12"GLA | TV-1-T   | T      |         | 29                | 1S-COUNT                         | SP-1             |                                      |
| ⑥                           | MUNI POLE W/ 6' LA         |                           | 61             | 3S12"    | SV-1-T   | T      |         | 49<br>68<br>139   | 1S-COUNT<br>1S-COUNT<br>1S-COUNT | SP-3<br>(CUSTOM) | EXTERNAL CONDUIT<br>APS-3W<br>APS-3W |

|     |          |                                                                                 |               |            |
|-----|----------|---------------------------------------------------------------------------------|---------------|------------|
| 4   | 4/24/23  | ADD NEW APS PER SRC 2022-199                                                    | D. YEUNG      | G. DE LEON |
| 3   | 5/19/21  | ADD DIAGONAL PED HEADS (SRC 2021-056)                                           | D. YEUNG      | B. WOO     |
| 2   | 10/19/19 | SIGNAL 42&61 REPLACED W/ 3S12", 41 W/ 4S12"GRA, 62 W/ 4S12"GLA PER SRC 2019-351 | J. HORNPOSTEL | G. DE LEON |
| 1   | 4/2008   | SIGNAL 49&68 MOUNTING REVISED PER FIELD                                         | J. HORNPOSTEL | G. DE LEON |
| 0   | 3/16/05  | SIGNAL UPGRADE BY 0480J; CONVERTED FROM AS-BUILTS                               | J. HORNPOSTEL | G. DE LEON |
| NO. | DATE     | DESCRIPTION                                                                     | BY            | APPROVED   |

TABLE OF REVISIONS  
CHECKOUT DRAWING THROUGH THE SID CUSTODIAN FOR THE LATEST REVISION



SFMTA

|                            |                  |
|----------------------------|------------------|
| DRAWN BY:<br>J. HORNPOSTEL | DATE:<br>12/2019 |
| CHECKED BY:<br>G. DE LEON  | DATE:<br>12/2019 |

|                           |                                  |                     |
|---------------------------|----------------------------------|---------------------|
| SCALE<br>AS SHOWN         | TRAFFIC SIGNAL INVENTORY DIAGRAM | CNN NO:<br>24933000 |
| SHEET OF SHEETS<br>1 OF 2 |                                  |                     |

|                             |              |
|-----------------------------|--------------|
| HYDE STREET AND TURK STREET | REV NO:<br>4 |
|-----------------------------|--------------|

