


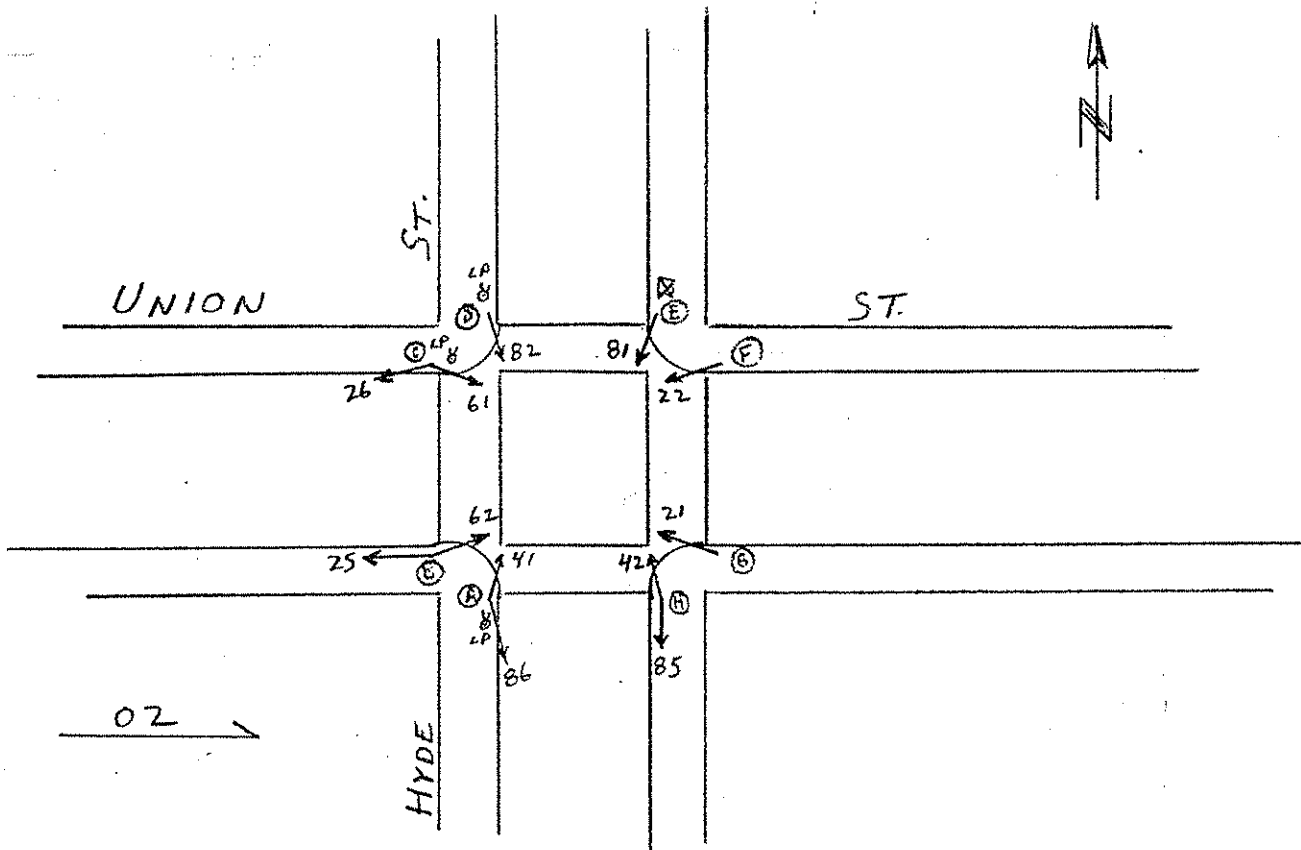

7-11-84

POLE	FUNC.	MAT'L	SIGNAL NO.	MAKE	NO. OF SECT.	SIZE	VISOR	B.P. OR LOUVERS	MOUNT	PED SIGNAL NO.	LEGEND	MESSAGE		MAKE	MOUNT
												ELEMENT	COLOR		
A	S	S	86	EC	3	8"	FCB"	No	T						
B	L	S	41	EC	3	8"	FCB"	No	T						
C	M	S	62	EC	3	8"	FCB"	No	S						
D	S	S	25	EC	3	8"	FCB"	No	S						
E	L	S	26	EC	3	8"	FCB"	No	S						
F	L	S	61	EC	3	8"	FCB"	No	S						
G	S	S	82	EC	3	8"	FCB"	No	T						
H	U	W	81	EC	3	8"	FCB"	No	S						
			22	EC	3	8"	FCB"	No	S						
			21	EC	3	8"	FCB"	No	T						
			42	EC	3	8"	FCB"	No	S						
			85	EC	3	8"	FCB"	No	S						

CONTROLLER CABINET SIZE : LARGE BASE CABINET : _____

COMMENTS :