


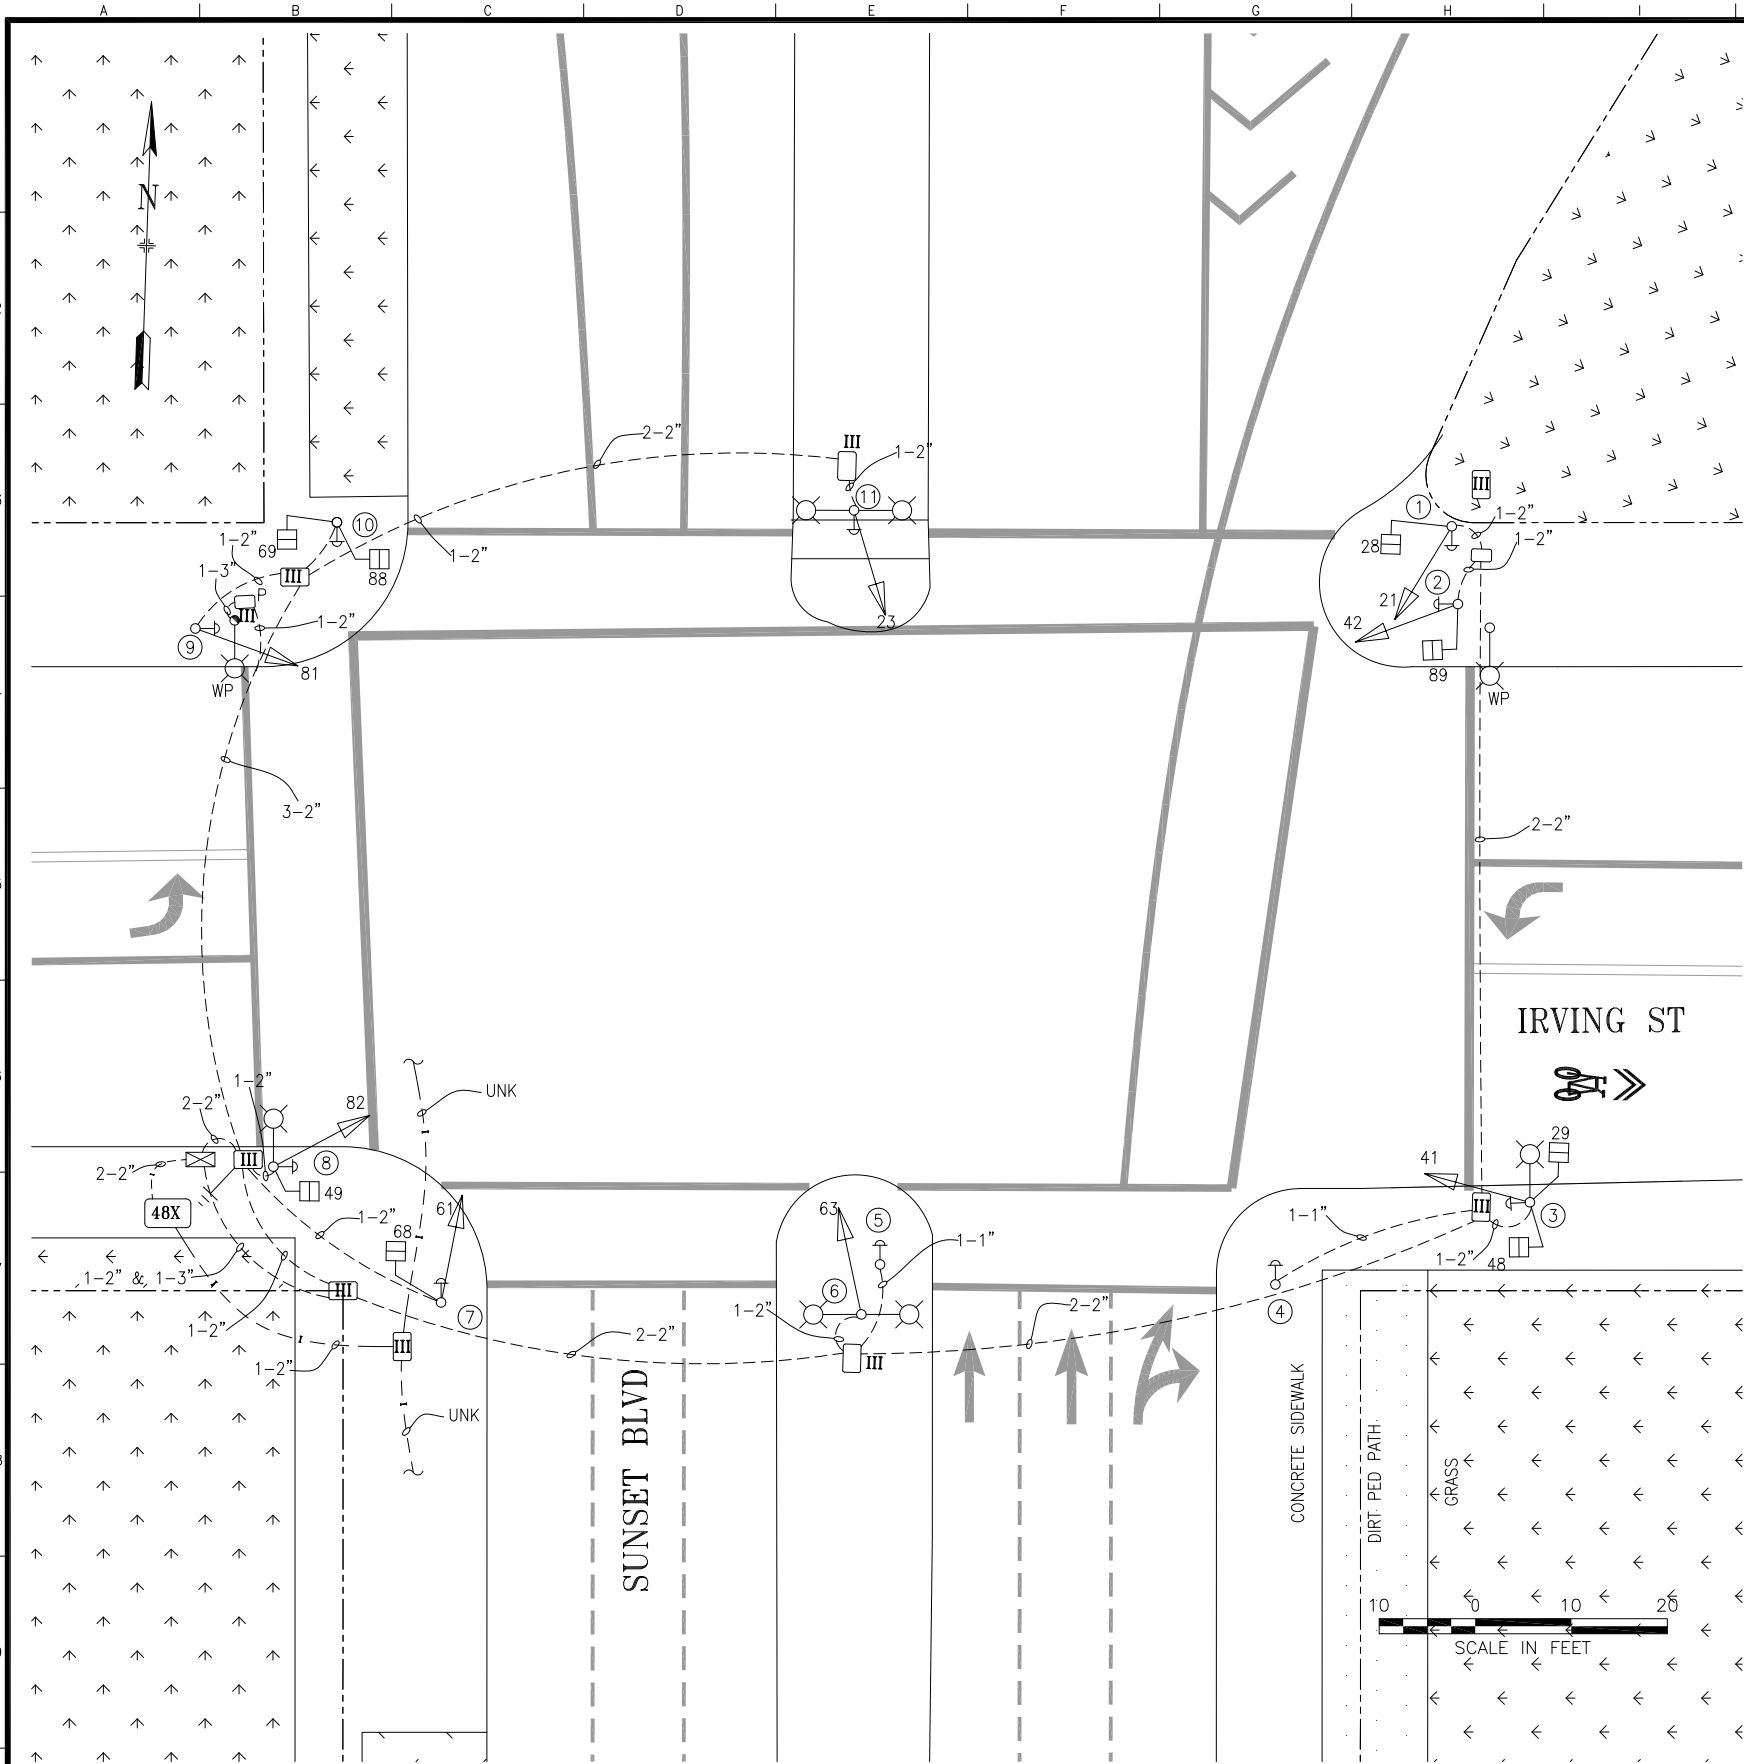

POLE AND EQUIPMENT SCHEDULE											
POLE No.	TYPE OF POLE	LUMINAIRE VOLTAGE/WATTAGE	VEHICLE SIGNAL					PEDESTRIAN SIGNAL			REMARKS
			No.	TYPE	MOUNTING	VISORS	LOUVERS	No.	TYPE	MOUNTING	
①	1-A (10')		21	3S12"	TV-1-T	T		28	1S-COUNT	SP-1	APS-2W
②	1-A (10')		42	3S12"	TV-1-T	T		89	1S-COUNT	SP-1	APS-2W
③	CITY STANDARD STREET LIGHT	120V/150W	41	3S12"	SV-1-T	T		29 48	1S-COUNT 1S-COUNT	SP-1-SF (12") SP-1 (22")	APS-2W
④	PPB POST										APS-2W
⑤	PPB POST										APS-2W
⑥	MARBELITE SL W/ DUAL LUMINAIRE ARMS		63	3S12"	SV-1-T	T					
⑦	1-A (10')		61	3S12"	TV-1-T	T		68	1S-COUNT	SP-1 (22")	APS-2W
⑧	CITY STANDARD STREET LIGHT	120V/150W	82	3S12"	SV-1-T	T		49	1S-COUNT	SP-1	APS-2W
⑨	1-A (10')		81	3S12"	TV-1-T	T					APS-2W
⑩	1-A (7')							69 88	1S-COUNT 1S-COUNT	TP-2-T	APS-2W
⑪	MARBELITE SL W/ DUAL LUMINAIRE ARMS		23	3S12"	SV-1-T	T					APS-2W

TABLE OF REVISIONS			
NO.	DATE	DESCRIPTION	BY APP.
1	7/16/17	NEW POLES 4 & 5 VIA 2821J; APS VIA SRC 2017-113	DYeung GDeleon
0	7/16/14	UPGRADED BY 2142J; CONVERTED FROM AS-BUILTS	JH GD

CHECK WITH TRACING TO SEE IF YOU HAVE LATEST REVISION

REFERENCE INFORMATION & FILE NO. OF SURVEYS	



SAN FRANCISCO MUNICIPAL TRANSPORTATION AGENCY

CITY AND COUNTY OF SAN FRANCISCO

DRAWN:	DATE:
JH	06/2016
CHECKED:	DATE:
GD	06/2016

SCALE:
AS SHOWN
SHEET OF SHEETS
1 of 1

TRAFFIC SIGNAL INVENTORY DIAGRAM
IRVING STREET AND SUNSET BOULEVARD

CNN NO.
27737000
REV NO.
1