


MISSION & ITALY

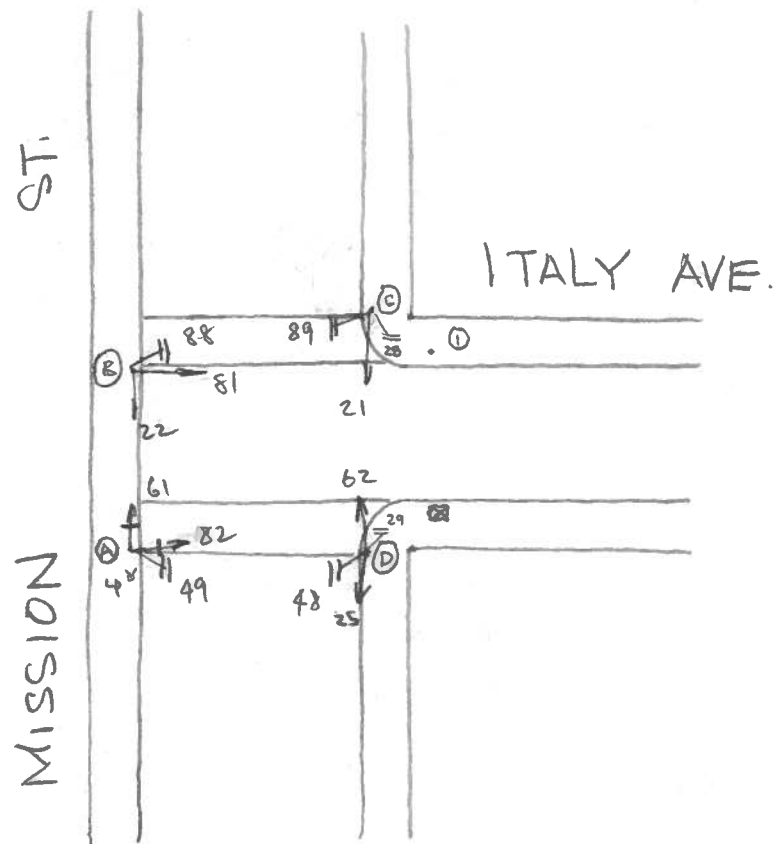

φ2

12/13/2019

[illegible]

CONTROLLER CABINET SIZE : ORDINARY BASE CABINET: YES

COMMENTS: ADD PED SIGNAL #28 & #29 AS PER FIELD.

AF E. LUU DESIGNATION: THIS AIRCRAFT IN BASE A. TRACKED IN R. 21SR

~~COPY~~ 04-1984 S 21 22, 84-61 FRO 2 11 12"