


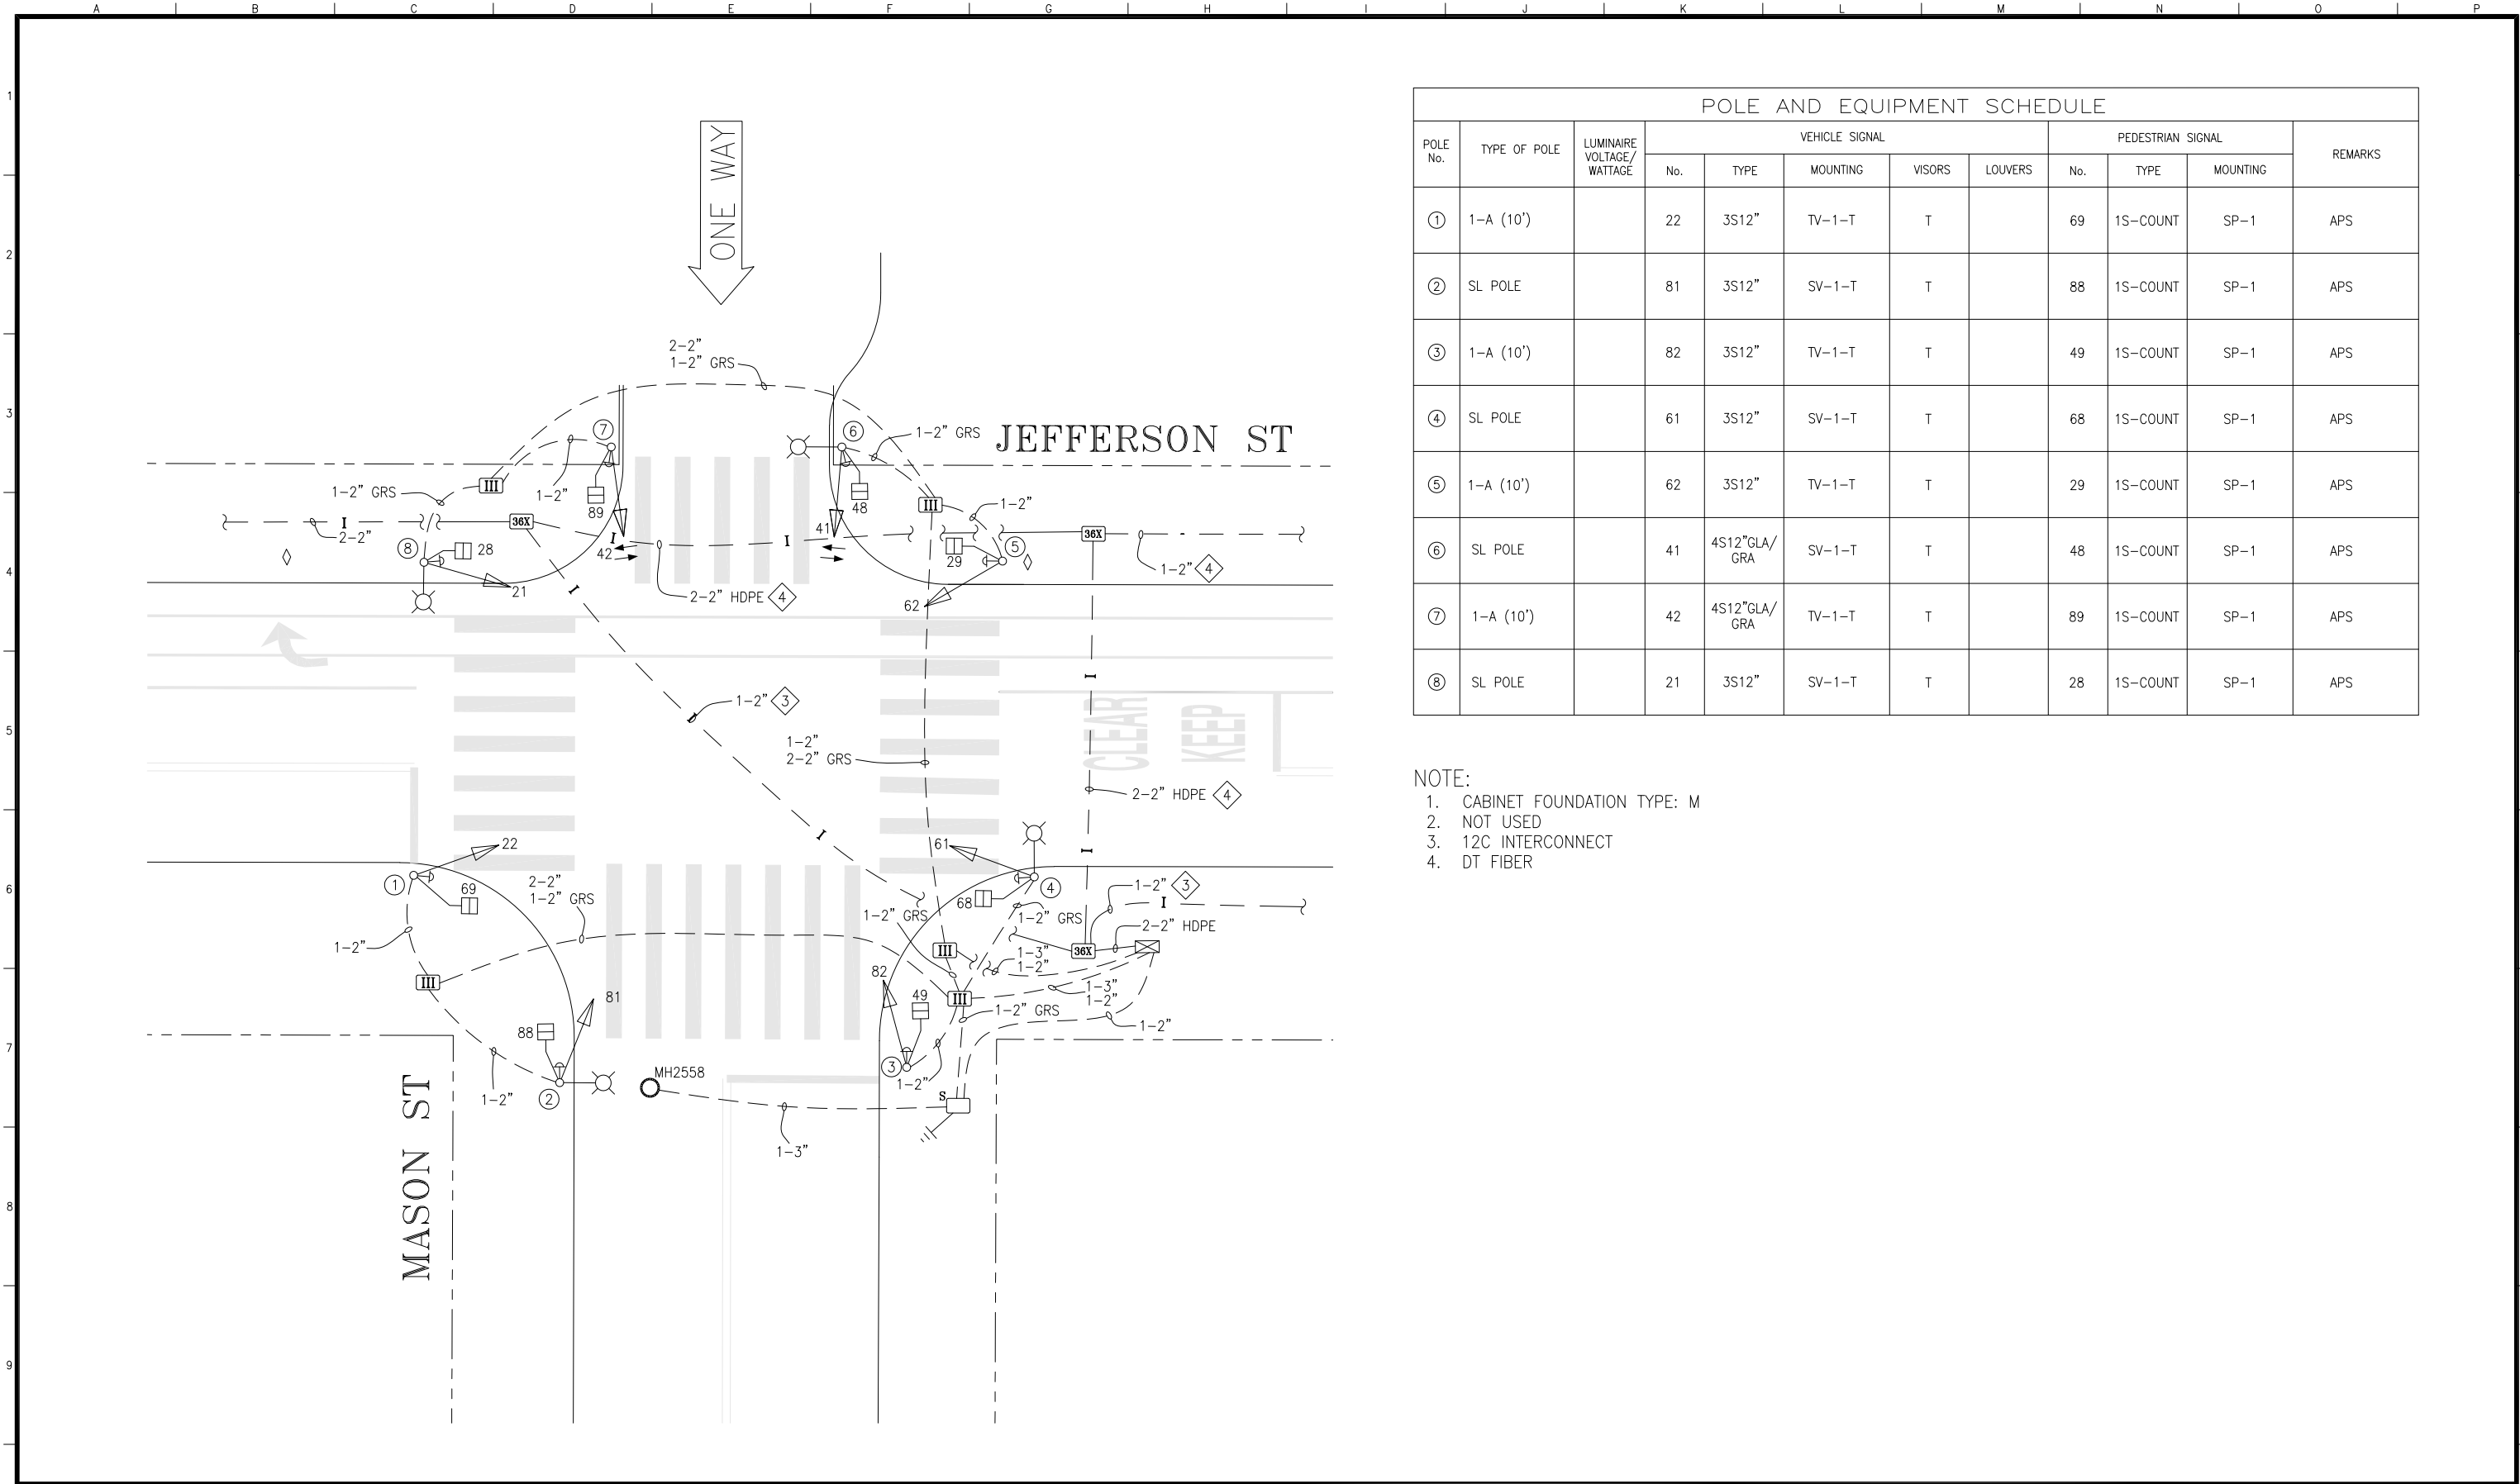

POLE AND EQUIPMENT SCHEDULE										
POLE No.	TYPE OF POLE	LUMINAIRE VOLTAGE/ WATTAGE	VEHICLE SIGNAL				PEDESTRIAN SIGNAL			REMARKS
			No.	TYPE	MOUNTING	VISORS	LOUVERS	No.	TYPE	MOUNTING
①	1-A (10')		22	3S12"	TV-1-T	T		69	1S-COUNT	SP-1
②	SL POLE		81	3S12"	SV-1-T	T		88	1S-COUNT	SP-1
③	1-A (10')		82	3S12"	TV-1-T	T		49	1S-COUNT	SP-1
④	SL POLE		61	3S12"	SV-1-T	T		68	1S-COUNT	SP-1
⑤	1-A (10')		62	3S12"	TV-1-T	T		29	1S-COUNT	SP-1
⑥	SL POLE		41	4S12"GLA/ GRA	SV-1-T	T		48	1S-COUNT	SP-1
⑦	1-A (10')		42	4S12"GLA/ GRA	TV-1-T	T		89	1S-COUNT	SP-1
⑧	SL POLE		21	3S12"	SV-1-T	T		28	1S-COUNT	SP-1

NOTE:
1. CABINET FOUNDATION TYPE: M
2. NOT USED
3. 12C INTERCONNECT
4. DT FIBER

NO.	DATE	DESCRIPTION	BY	APP.
1	7/13/21	SRC 2021-127: INSTALLED APS	TY	MV
0	8/26/20	SRC 2020-179: CONTRACT 2768J/1000011498 SWITCHOVER CONVERTED FROM 1949J/MR-1112R AS-BUILTS	TY	MV

TABLE OF REVISIONS
CHECK WITH TRACING TO SEE IF YOU HAVE LATEST REVISION

REFERENCE INFORMATION & FILE NO. OF SURVEYS
CONTRACT MR-1112R DRAWINGS E-11 & E-19 SPECIFICATION NO. 1949J DRAWING E-3.1 CONTRACT 2768J/1000011498 DRAWINGS ET-3.1 & ET-3.2



SAN FRANCISCO MUNICIPAL TRANSPORTATION AGENCY

CITY AND COUNTY OF SAN FRANCISCO

DRAWN:	DATE:
TY	04/2021
CHECKED:	DATE:
MV	04/2021

SCALE:
1" = 10'
SHEET OF SHEETS
1 OF 1

TRAFFIC SIGNAL INVENTORY DIAGRAM
JEFFERSON ST & MASON ST

CNN NO.
25486000
REV NO.
1