


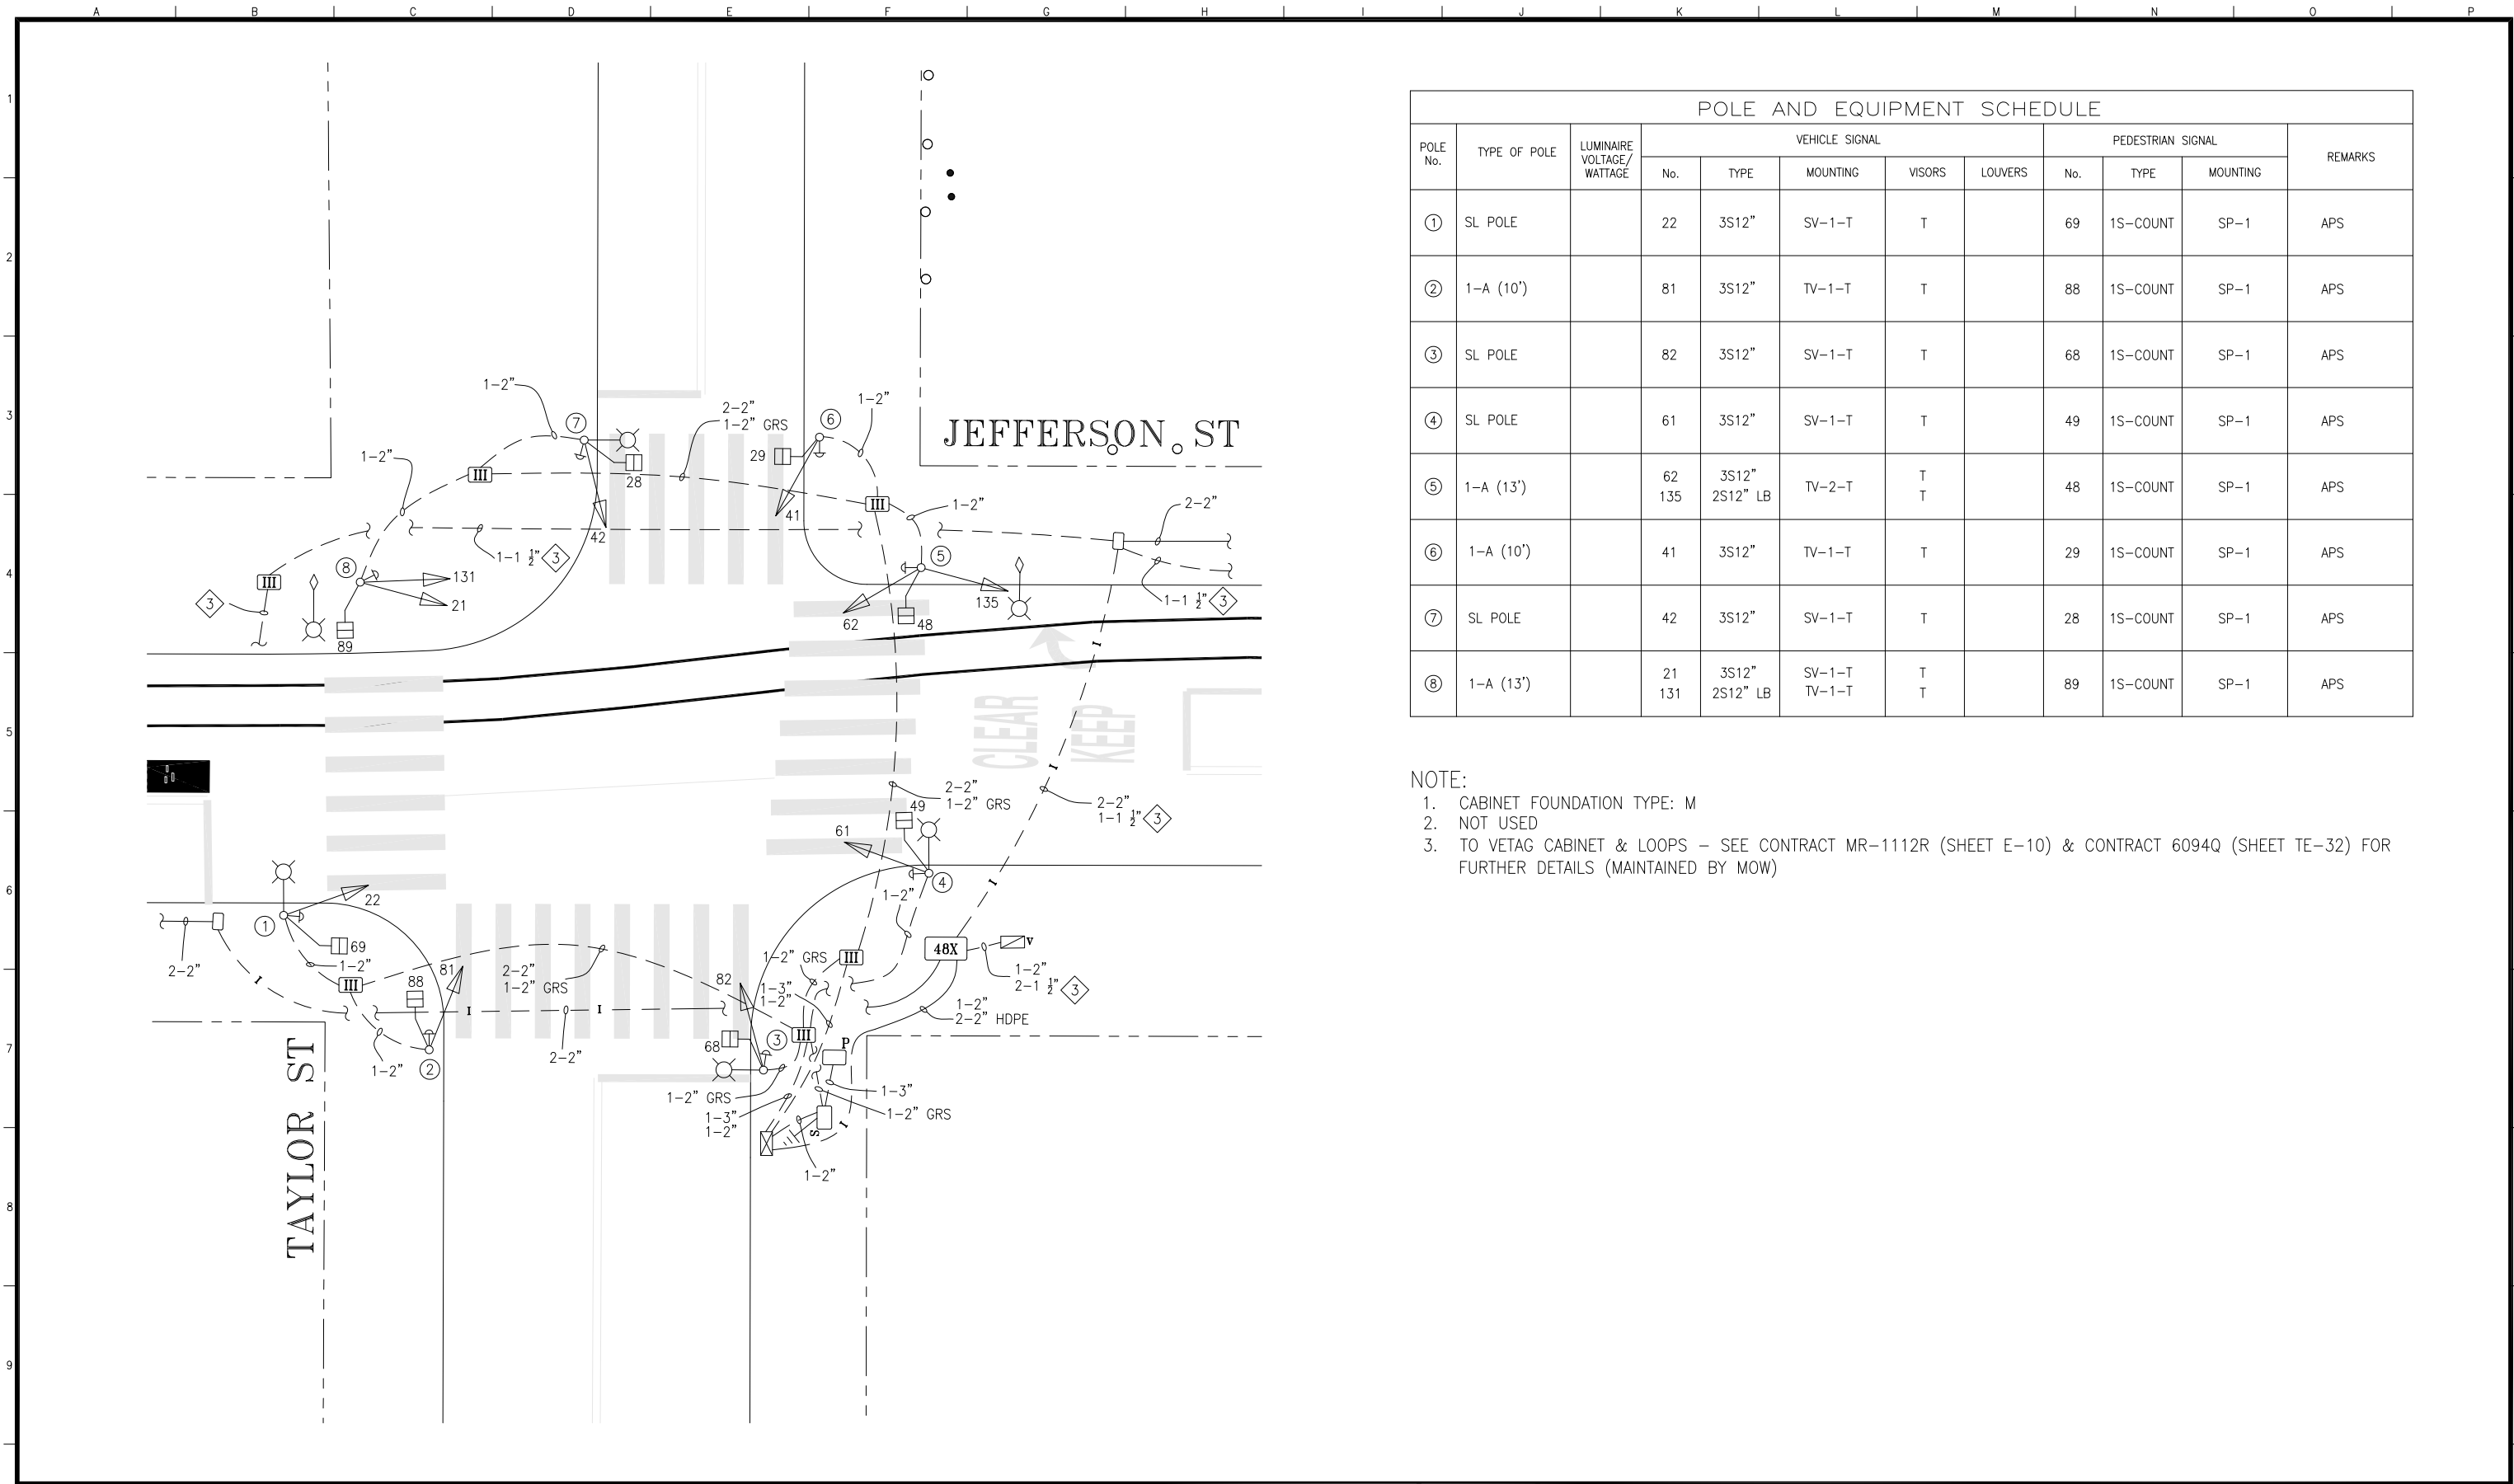

POLE AND EQUIPMENT SCHEDULE											
POLE No.	TYPE OF POLE	LUMINAIRE VOLTAGE/ WATTAGE	VEHICLE SIGNAL					PEDESTRIAN SIGNAL			REMARKS
			No.	TYPE	MOUNTING	VISORS	LOUVERS	No.	TYPE	MOUNTING	
①	SL POLE		22	3S12"	SV-1-T	T		69	1S-COUNT	SP-1	APS
②	1-A (10')		81	3S12"	TV-1-T	T		88	1S-COUNT	SP-1	APS
③	SL POLE		82	3S12"	SV-1-T	T		68	1S-COUNT	SP-1	APS
④	SL POLE		61	3S12"	SV-1-T	T		49	1S-COUNT	SP-1	APS
⑤	1-A (13')		62 135	3S12" 2S12" LB	TV-2-T	T T		48	1S-COUNT	SP-1	APS
⑥	1-A (10')		41	3S12"	TV-1-T	T		29	1S-COUNT	SP-1	APS
⑦	SL POLE		42	3S12"	SV-1-T	T		28	1S-COUNT	SP-1	APS
⑧	1-A (13')		21 131	3S12" 2S12" LB	SV-1-T TV-1-T	T T		89	1S-COUNT	SP-1	APS

NOTE:
1. CABINET FOUNDATION TYPE: M
2. NOT USED
3. TO VETAG CABINET & LOOPS – SEE CONTRACT MR-1112R (SHEET E-10) & CONTRACT 6094Q (SHEET TE-32) FOR FURTHER DETAILS (MAINTAINED BY MOW)

NO.	DATE	DESCRIPTION	BY	APP.
1	7/13/21	SRC 2021-127: INSTALLED APS	TY	MV
0	8/26/20	SRC 2020-179: CONTRACT 2768J/1000011498 SWITCHOVER CONVERTED FROM 1949J/MR-1112R AS-BUILTS	TY	MV

TABLE OF REVISIONS
CHECK WITH TRACING TO SEE IF YOU HAVE LATEST REVISION

REFERENCE INFORMATION & FILE NO. OF SURVEYS	
CONTRACT MR-1112R DRAWINGS E-10 & E-18 SPECIFICATION NO. 1949J DRAWING E-4.0 CONTRACT 2768J/1000011498 DRAWINGS ET-2.1 & ET-2.2 CONTRACT 6094Q DRAWING TE-32	



SAN FRANCISCO MUNICIPAL TRANSPORTATION AGENCY
CITY AND COUNTY OF SAN FRANCISCO

DRAWN:	DATE:
TY	04/2021
CHECKED:	DATE:
MV	04/2021

SCALE:
1" = 10'
SHEET OF SHEETS
1 OF 1

TRAFFIC SIGNAL INVENTORY DIAGRAM
JEFFERSON ST & TAYLOR ST

CNN NO.
25594000
REV NO.
1