


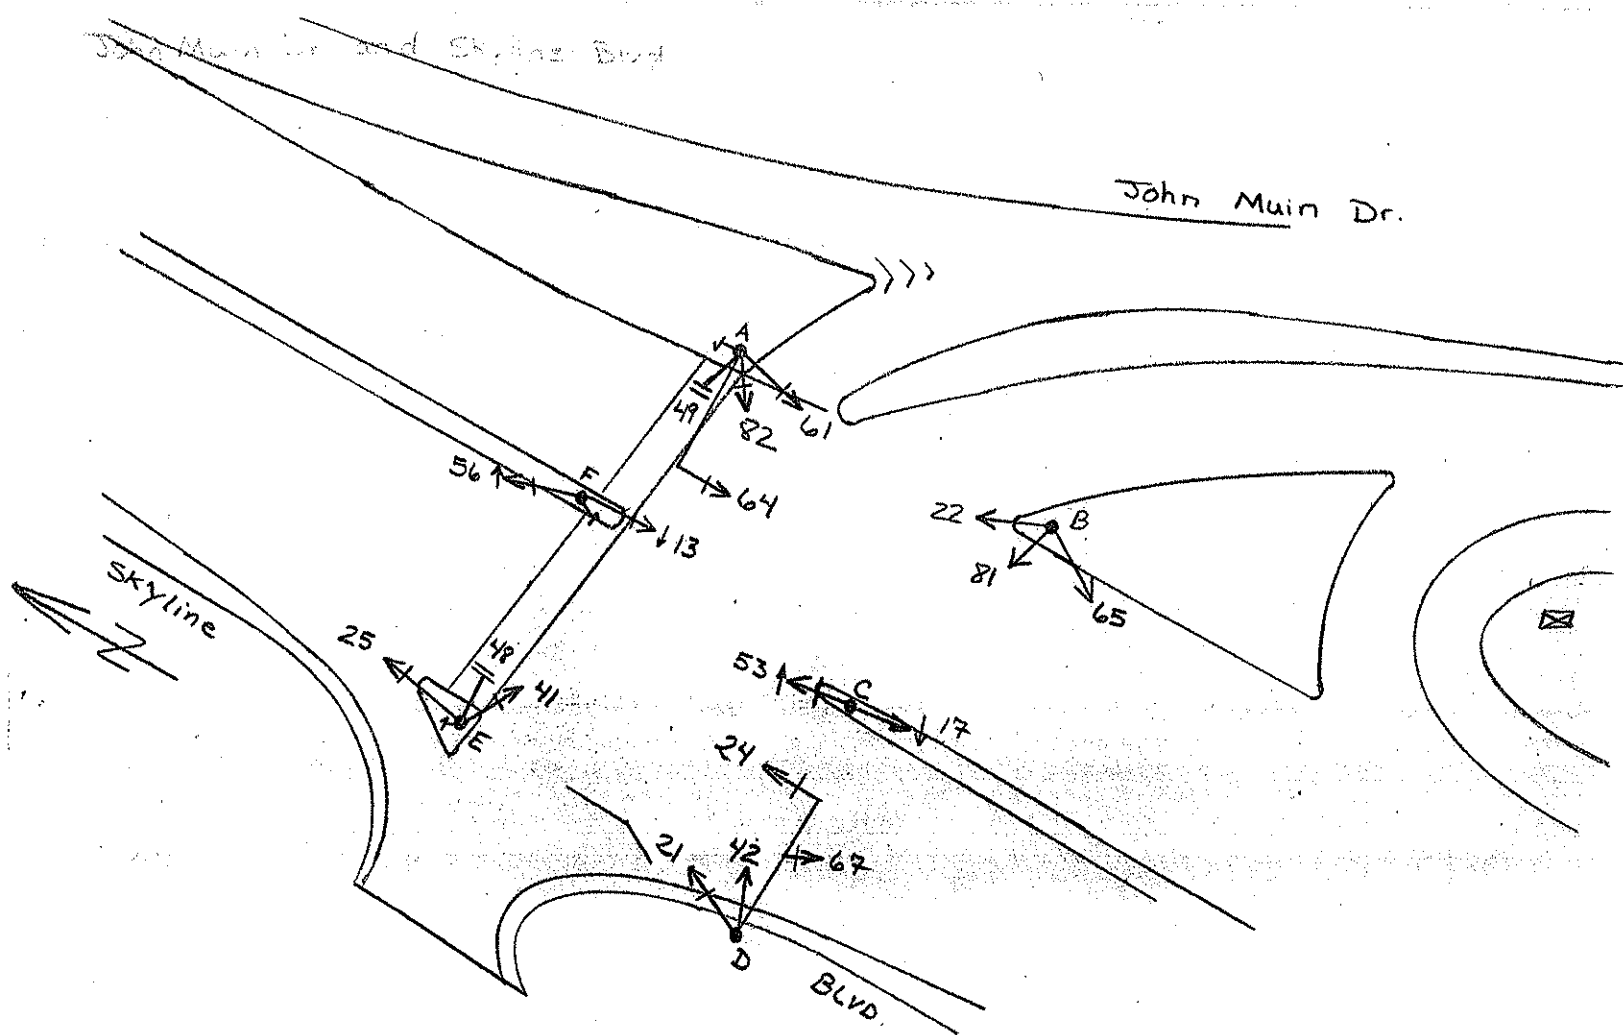

7-10-95

POLE	FUNC.	MAT'L	SIGNAL NO.	MAKE	NO. OF SECT.	SIZE	VISOR	B.P. OR LOUVERS	MOUN'T	PED SIGNAL NO.	LEGEND	MESSAGE		MAKE	MOUN'
												ELEMENT	COLOR		
A	L	S	17	EC	3	8" BY 12" RY	FC8" RY FC12" G	Red light Louvers	S	48	I	IS-1	WH/or	MTS	S
B	S	S	13	MTS	3	12" RY	FC12"	BP	T	49	I	IS-1	WH/or	ICC	S
C	S	S	22	EC	3	8"	FC8"	Louvers	T						
D	S	S	21	EC	3	12"	FC12"	BP	S						
E	S	S	24	State	3	12"	FC12"	BP	MAS						
F	S	S	25	EC	3	8"	FC8"	BP	T						
			41	EC	3	12"	FC12"	BP	T						
			42	EC	3	8"	FC8"	-	S						
			53	EC	3	12" RY	FC12"	BP	T						
			56	EC	3	8" BY 12" RY	FC8" RY FC12" G	Louvers BP	S						
			61	EC	3	8"	FC8"	BP	S						
			64	EC	3	12"	FC12"	BP	MAS						
			65	EC	3	8"	FC8"	-	T						
			67	PV	3	12"	FC12"	BP	MAS						

CONTROLLER CABINET SIZE : State (170) BASE CABINET: _____

COMMENTS :

81 EC 3 8" FC8" - T

82 EC 3 8" FC8" BP S